


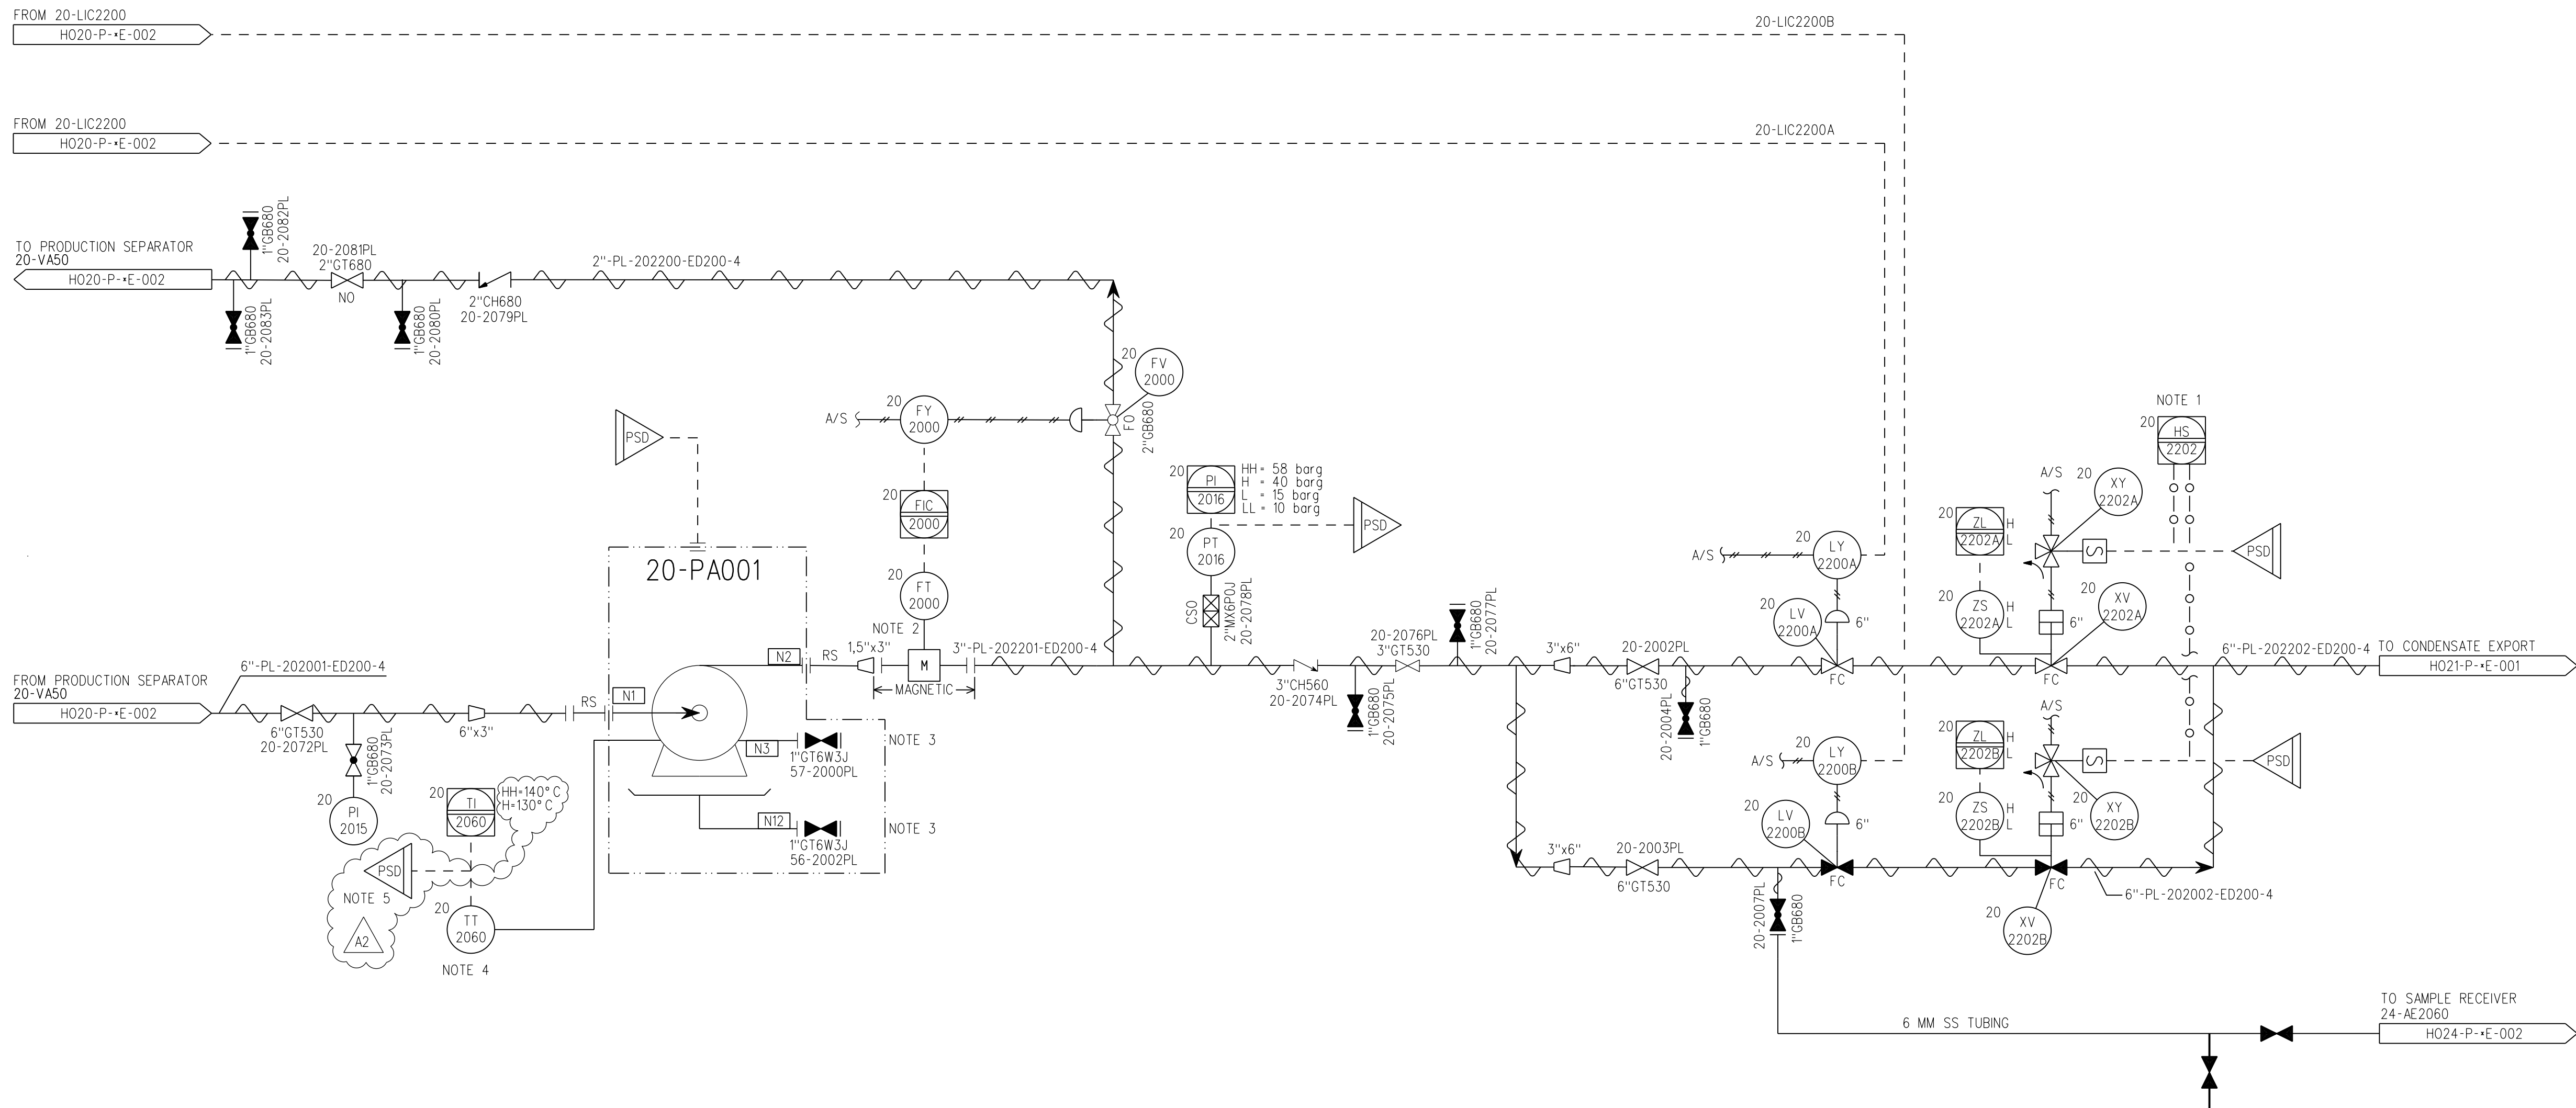

1. 20-HS2202A TO OPERATE 20-XV2202A, AND 20-HS2202B TO OPERATE 20-XV2202B.
2. 5D UPSTREAM AND 3D DOWNSTREAM STRAIGHT LINE FOR FLOWMETER.
3. CONNECTION FOR PORTABLE PUMP.
4. SHELL TEMPERATURE MEASUREMENT.
5. 20-TAH2060 TRIPS PUMP 20-PA001.

									A2	AS BUILT NOT 43443644	24.01.14	TE	LS	MJR	LL	
									A1	AS-BUILT NW 969718/NOT 41306043	17.07.13	SHR	MH	MJR		
DRG. NO.	REFERENCE DRAWINGS	REV	REASON FOR ISSUE	DATE	DRN	CHK	DISC SUP	DOB	REV	REASON FOR ISSUE	DATE	DRN	CHK	DISC SUP	DOB	

SYSTEM NO		 Statoil		Huldra EPC WHPT							
20				TITLE PIPING AND INSTRUMENT DIAGRAM PRODUCTION SEPARATION AND STABILIZATION SYSTEM SEPARATOR PUMP 20-PA001							
WORK PACK NO				DRAWING NO							
				C025-V-HB20-P-x-E-001-01						A2	
		SCALE	PROJECTION								
		N.T.S.									
				PROJECT NO	CONTR	AREA/SYS	DISC	TYPE	NUMBER	SHT NO	REV