


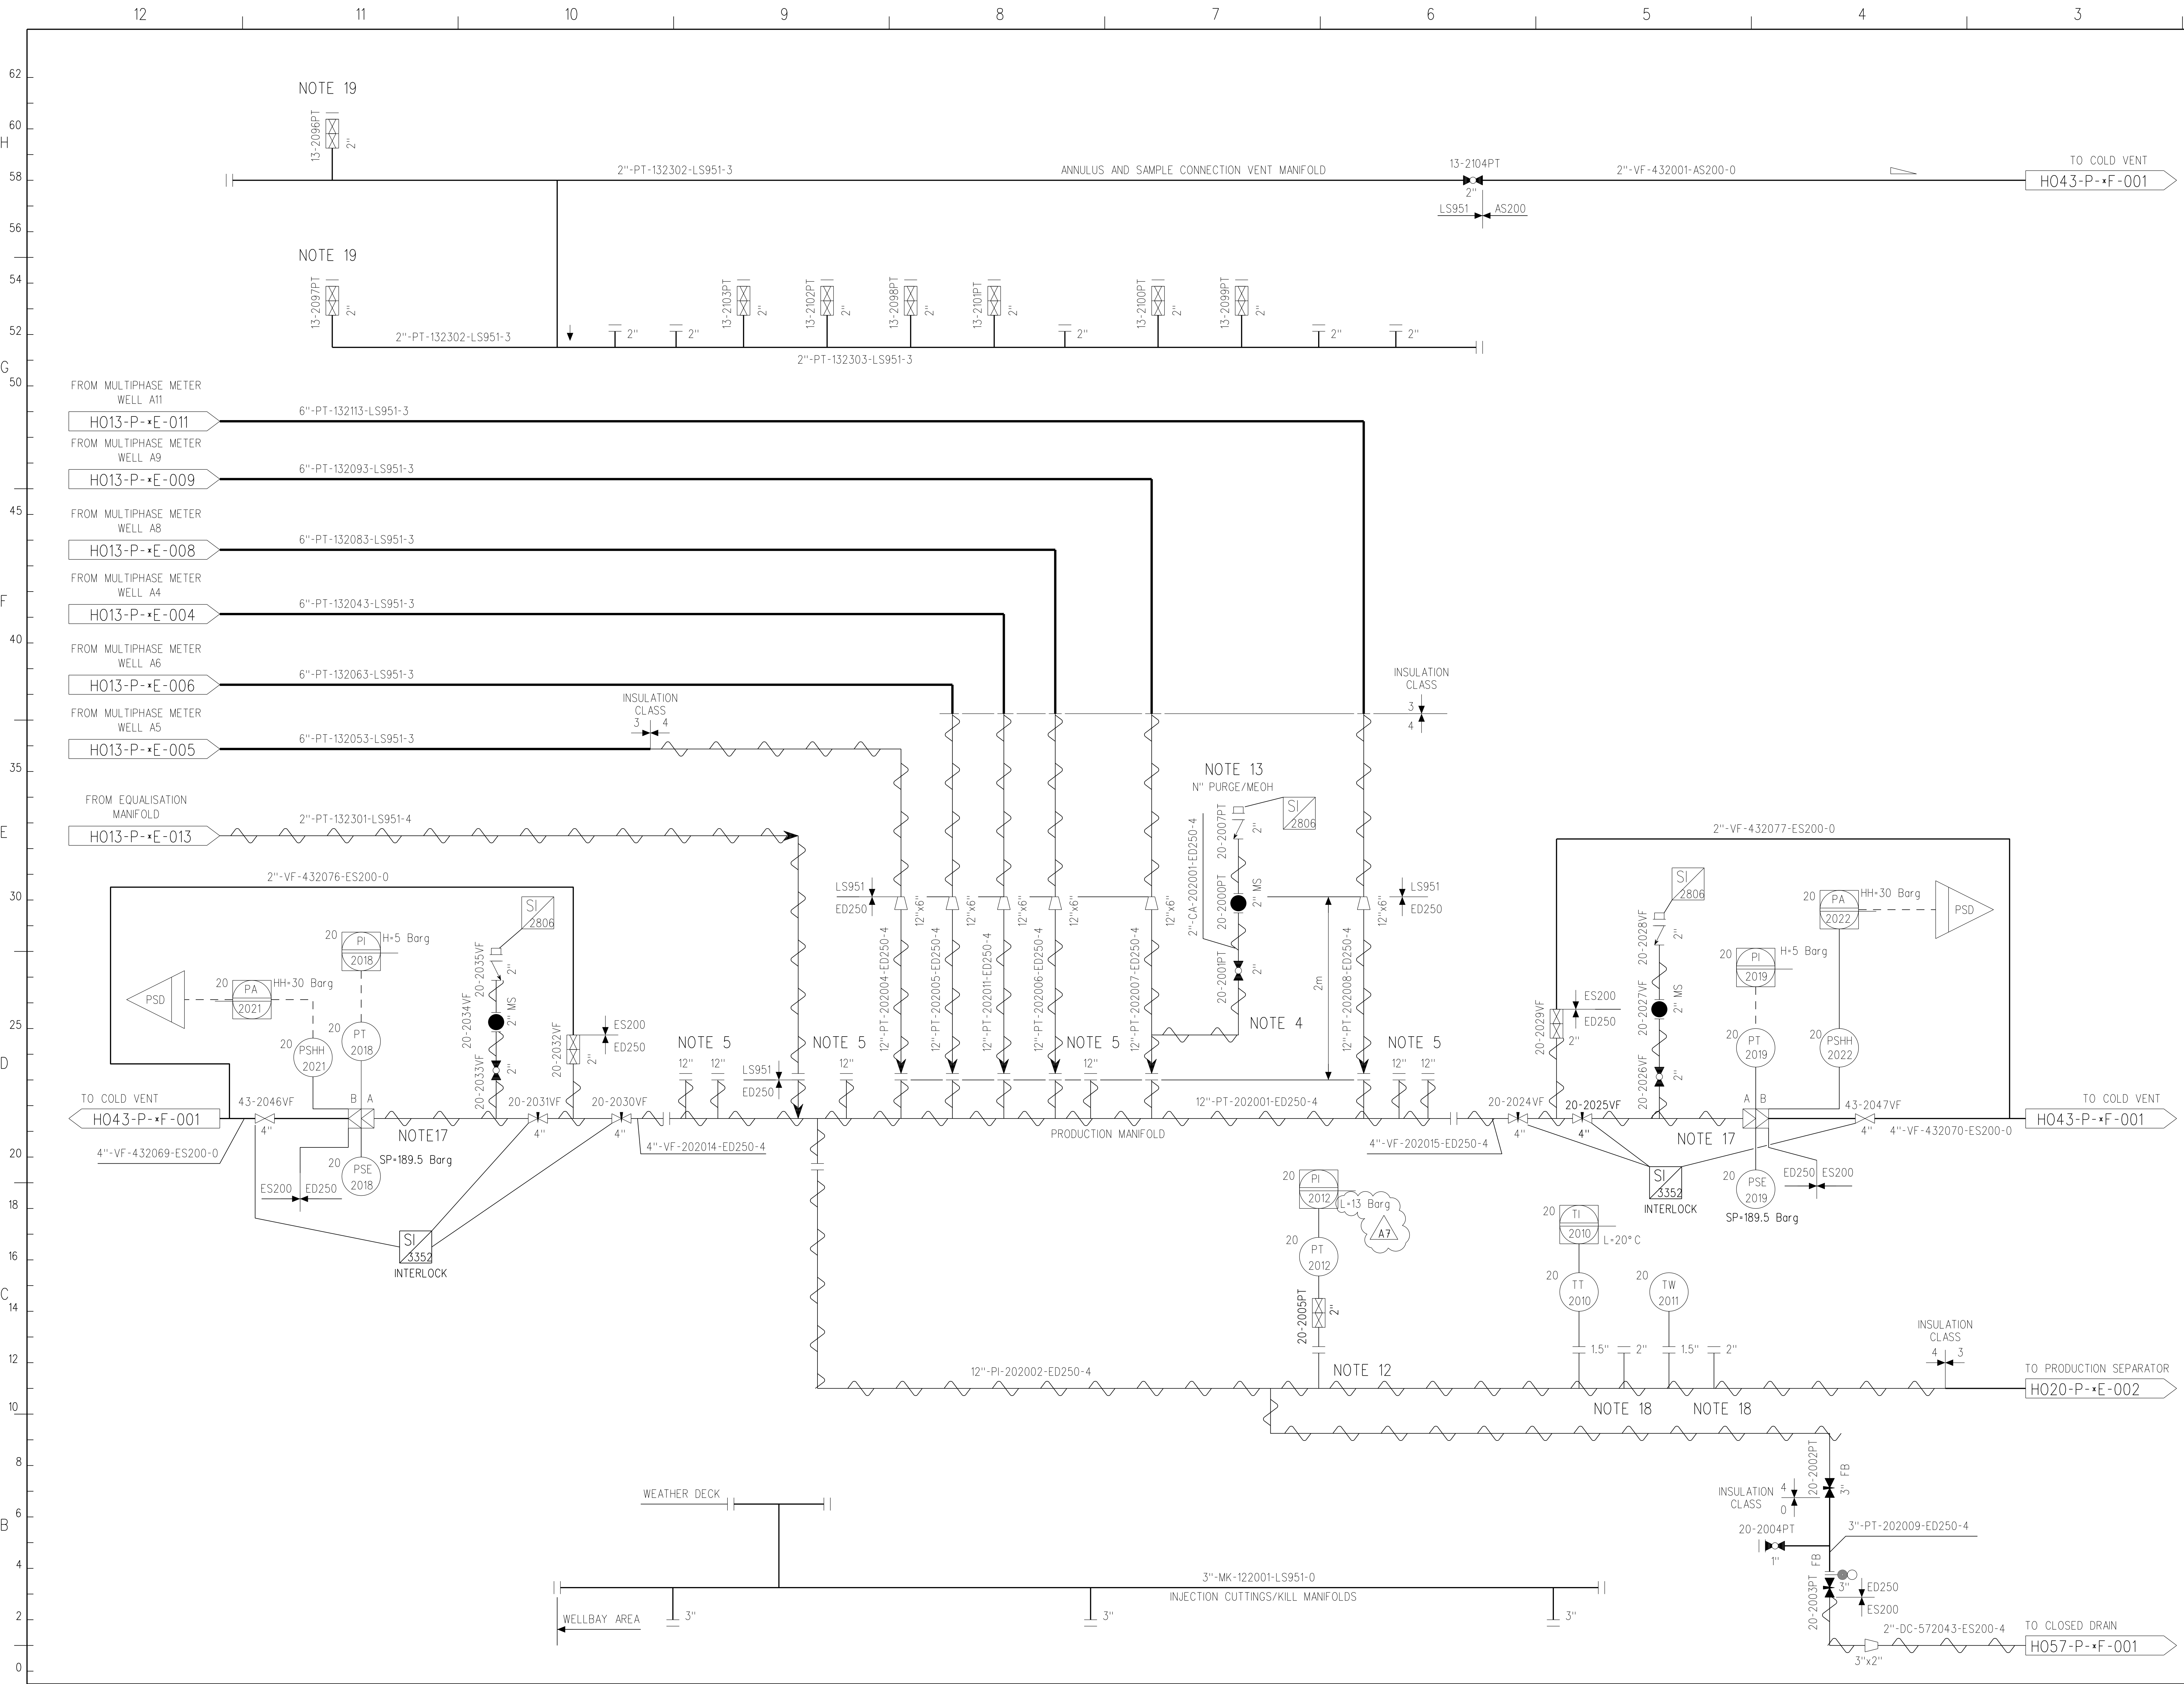

NOTES

1. DELETED.
2. DELETED.
3. DELETED.
4. PURGE CONNECTION AT HIGH POINT.
5. CONNECTIONS FOR SIX FUTURE WELLS.
6. DELETED.
7. DELETED.
8. DELETED.
9. DELETED.
10. DELETED.
11. DELETED.
12. 3D BENDS REQUIRED IN THE PIPING DUF TO SAND EROSION.
13. NITROGEN PURGE/METHANOL INJECTION POINT TO BE TERMINATED BY A BLIND FLANGE WITH AN 0.75" SAFETY BLEED PLUG (SI2806). NITROGEN HOSE AND CONNECIOR ARE BY STATOIL.WHEN REQUIRED FOR METHANOL INJECTION, THE BLIND FLANGE IS REMOVED AND REPLACED BY A METHANOL HOSE CONNECTION (SI3209).
14. DELETED
15. DELETED.
16. DELETED.
17. WINTERISATION UP TO BURSTING DISC INLET.
18. FUTURE CORROSION PROBE CONNECTIONS.
19. HOSE AND CONNECTOR ARE BY STATOIL.

StatOil UBT - MicroStation - A1			A7	AS-BUILT NW 969718/NOT 41306043	23.05.13	MLF	MH	MH		A2	AS BUILT	06.12.01	NH-J	DGB	DGB	PJD	SYSTEM NO: 20		Huldra EPC WHPT						
			A6	AS-BUILT HHP-PROJECT	17.07.07	MC	SVL	SVL	RSB	A1	AS BUILT	21.09.01	BC	PJD	PJD	PJD			TITLE: PIPING AND INSTRUMENT DIAGRAM PRODUCTION MANIFOLD						
			A5	AS-BUILT (NY TEGNET)	17.11.04	EE	KNS		OUR	0B	ISSUED FOR COMMISSIONING INC RN 20-24	15.01.01	WB	JG	JG	JG									
			A4	AS-BUILT OFFSHORE A0.600130	03.08.03	EE	KNS	OUR		0A	AFC INC RN 12 - 19	10.08.00	WB	RS	JG	RGG	WORK PACK NO: SCALE: N.T.S		DRAWING NO.: C025-W-H020-P-E-001-01		A7				
			A3	AS BUILT	02.04.02	NH-J	RT		SN	0	AFC INC RN 8 - 11	29.03.00	MZW	RAS	JG	PD									
	DRG. NO.	REFERENCE DRAWINGS			REV.	REASON FOR ISSUE			DATE	DRN.	CHK.	DISC. SUP.	DDB	REV.	REASON FOR ISSUE			DATE	DRN.	CHK.	DISC. SUP.	DDB			
12		11		10		9		8		7		6		5		4		3		1					