


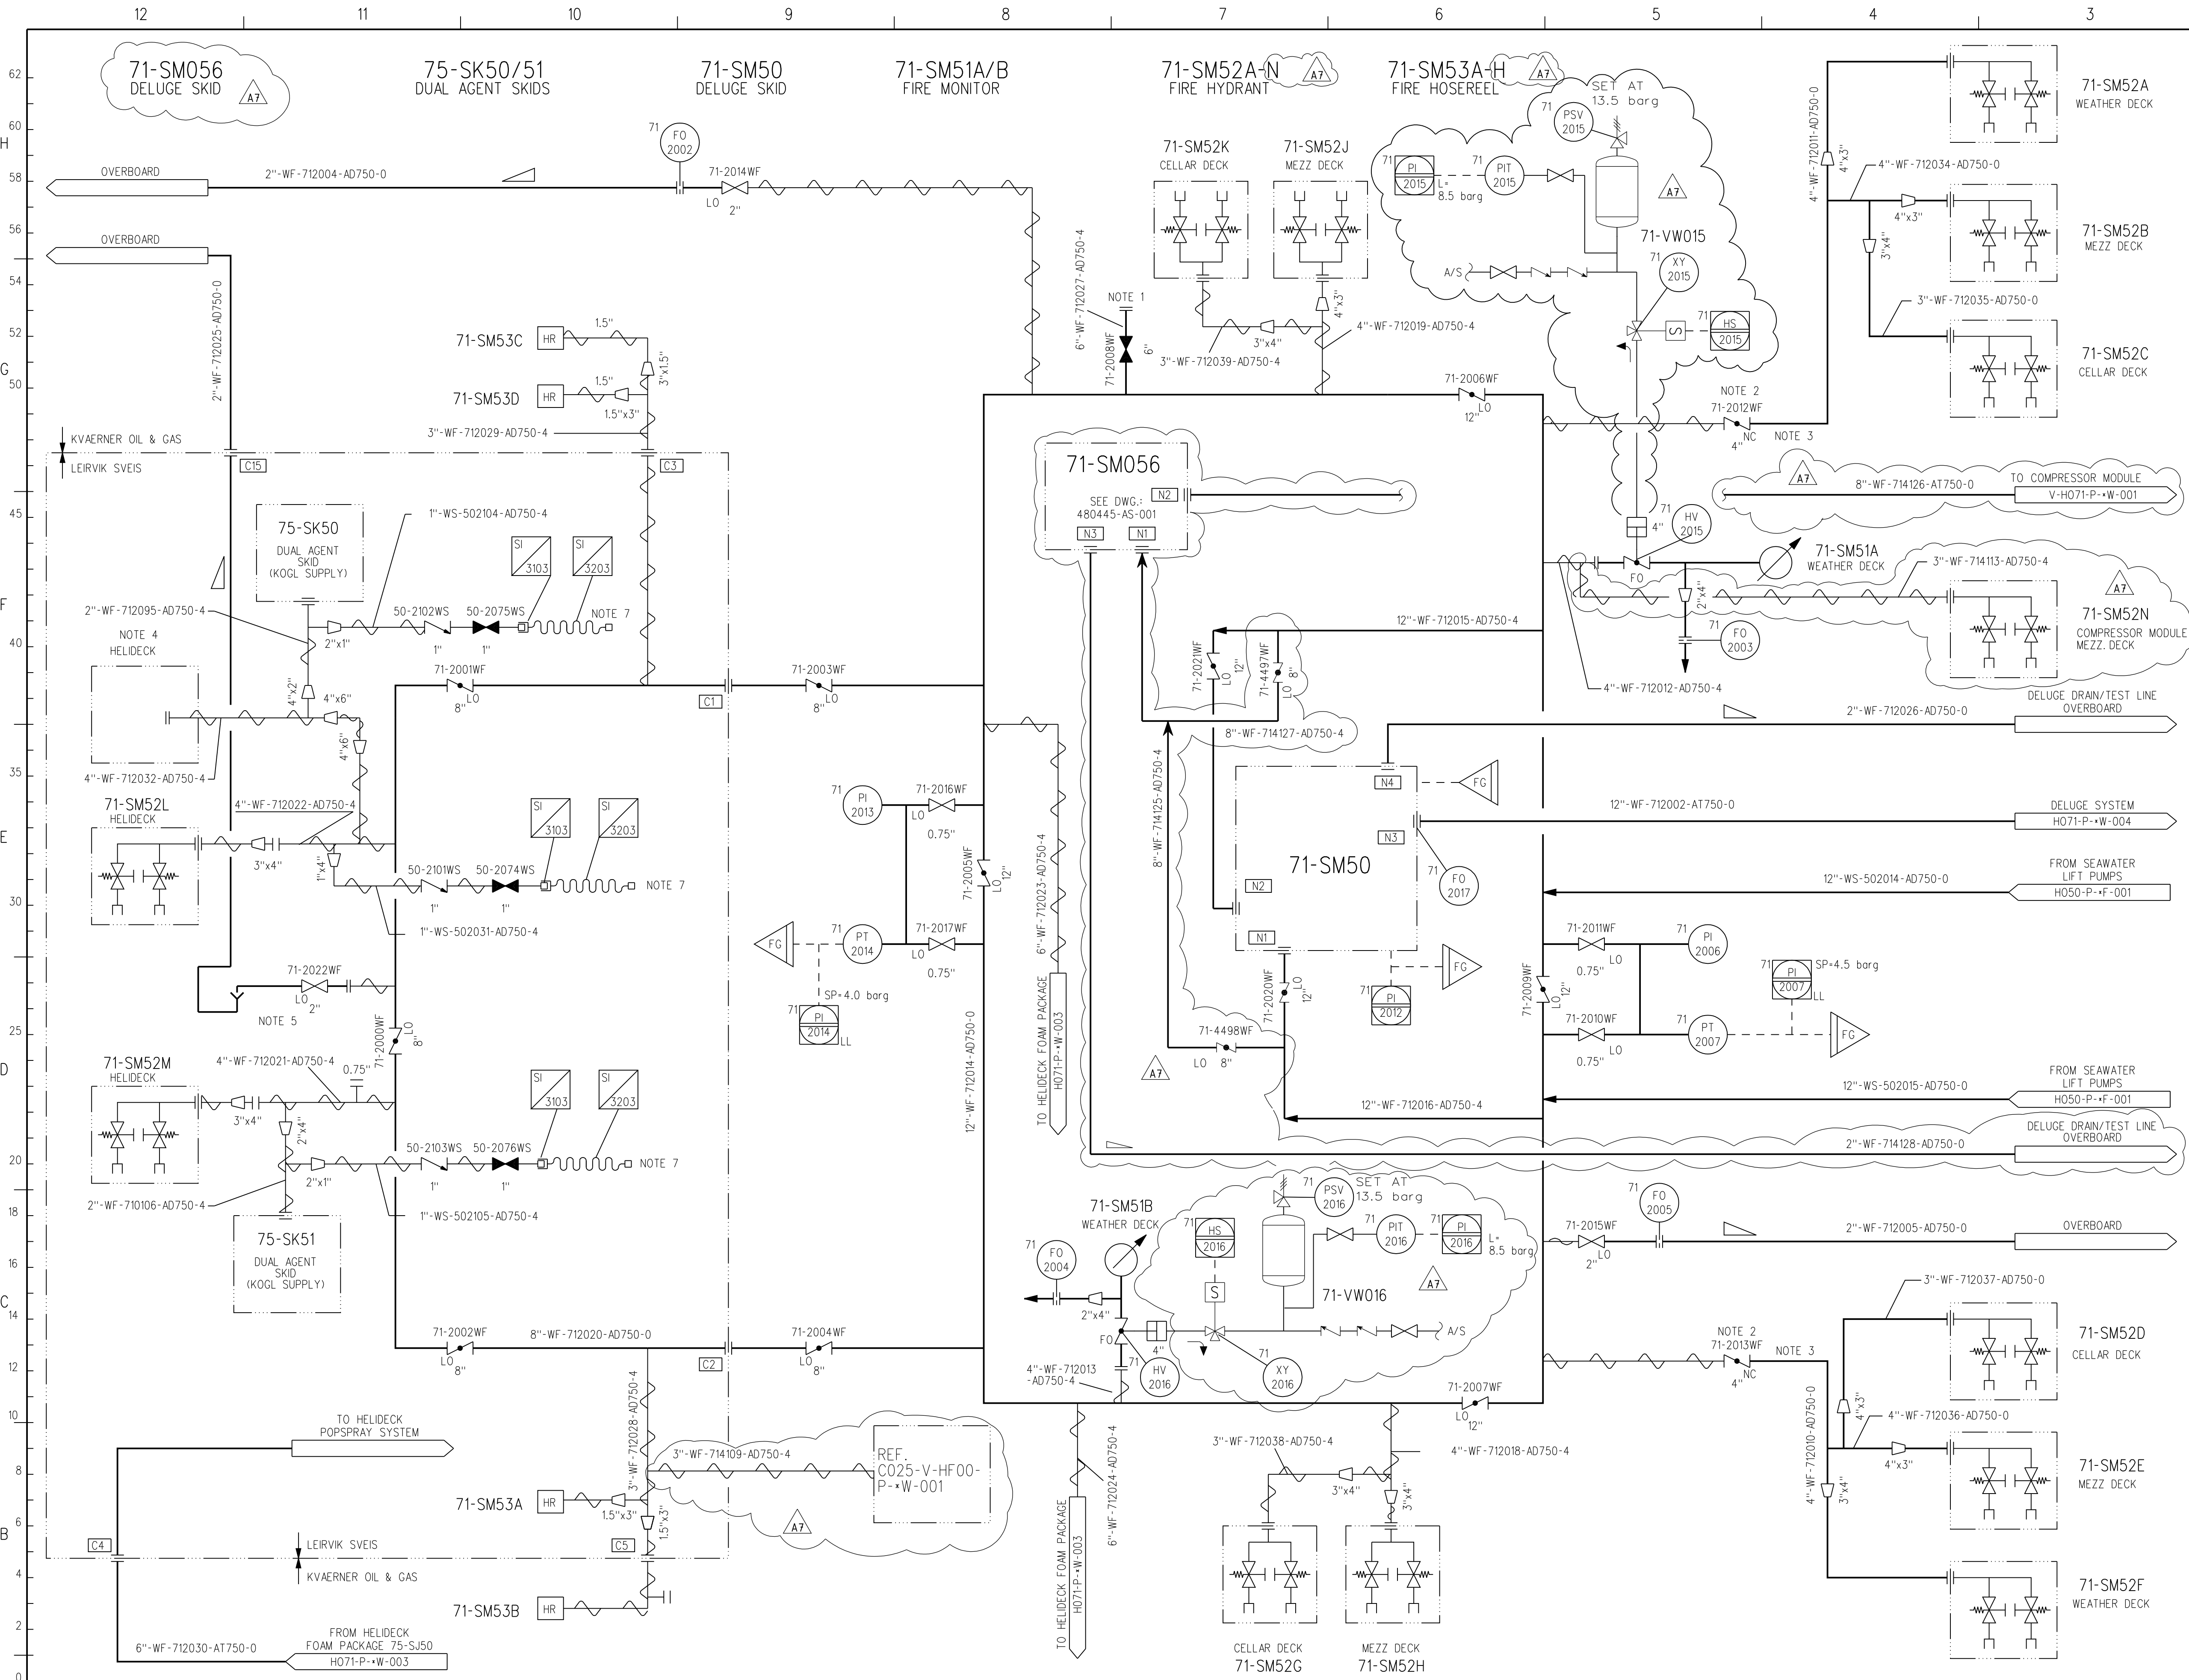

- NOTES
1. PROVISION FOR JACK UP FIREWATER CONNECTION.
 2. ISOLATION VALVE FOR HYDRANT SPUR TO BE LOCATED BEHIND FIRE/BLAST WALL.
 3. DRAIN HOLE (3mm) TO BE DRILLED IN LOWEST POINT.
 4. SUPPLY LINE FOR POSSIBLE THIRD FUTURE HELIDECK MONITOR.
 5. OVERBOARD DUMP LINE TO RUN FROM HIGH POINT TO FACILITATE AIR REMOVAL.
 6. TIME DELAY TO BE INCLUDED ON PRESSURE TRANSMITTERS. TO ALLOW FOR PUMP TO RUN UP FROM SEAWATER SERVICE PRESSURE TO PREWATER SERVICE PRESSURE. PRESSURE TRANSMITTERS OVERRIDE IN SEAWATER MODE.
 7. VALVES AND HOSE STATION TO BE SUPPLIED FREE ISSUE TO LEIRVIK SVEIS.
 8. PT2007 AND PT2014 ARE INOPERATIVE WHEN PUMPS ARE IN SEAWATER MODE. IN FIRE MODE, THE LOW SET POINT CAUSES TRANSITION TO HIGHER MODE.

StatOil UBT - MicroStation - A1			A7	AS-BUILT, HHP-PROJECT	24.09.2007	LA	BJ	JL	ORS	A2	AS BUILT	07.09.01	BC	PJD	PJD	PJD	SYSTEM NO: 71		Huldra EPC WHPT TITLE: PIPING AND INSTRUMENT DIAGRAM FIREWATER SYSTEM SHEET 1 OF 2				
			A6	AS-BUILT OFFSHORE AO 40293056	30.10.03	EE	KNS		OUR	A1	AS BUILT	13.06.01	REH	RGB	RGB	PJD							
			A5	AS BUILT AO600072	26.03.03	NH-J	EB	RT	SN	0A	ISSUED FOR COMMISSIONING INC RN 8-10	08.01.01	WB	RGB	RGB	PJD							
			A4	AS BUILT	02.04.02	NH-J	RT		SN	0	AFC INC RN 7	24.03.00	WB	RGH	RGB	DB	WORK PACK NO:		DRAWING NO.: C025-W-H071-P-•W-001-01				
			A3	AS BUILT	07.11.01	REH	PJD	PJD	PJD	06D	APPROVED FOR DESIGN INC RN 5 & 6	07.02.00	WB	RGH	RGB	DB							
	DRG. NO.	REFERENCE DRAWINGS	REV.	REASON FOR ISSUE	DATE	DRN.	CHK.	DISC SUP.	DDB	REV.	REASON FOR ISSUE	DATE	DRN.	CHK.	DISC SUP.	DDB	SCALE: N.T.S.	PROJECTION: 	A7				
	12	11	10	9	8	7	6	5	4	3	2	1											