


PROJ. NO. 82-CA50B
SHEET NO. 1
ISSUE NO. 1
DATE 25.02.02
BY NH-J
CHK. DB
DISC. SUP. PJD
JOB NO. 600219
REV. 0
REASON FOR ISSUE
ISSUED FOR COMMISSIONING
DATE 20.11.00
BY WB
CHK. JG
DISC. SUP. JG
JOB NO. 600213
REV. 0
REASON FOR ISSUE
ISSUED FOR NOTIFICATION
DATE 09.08.00
BY WB
CHK. RGK
DISC. SUP. RGK
JOB NO. SWO 13 & 63
REV. 0
REASON FOR ISSUE

DRG. NO.	REFERENCE DRAWINGS	REV.	REASON FOR ISSUE	DATE	DRN.	CHK.	DISC. SUP.	JOB	REV.	REASON FOR ISSUE	DATE	DRN.	CHK.	DISC. SUP.	JOB
		A3	AS BUILT	25.02.02	NH-J	BH	BH	PJD							
		A2	AS BUILT	03.12.01	NH-J	DGB	DGB	PJD							
		A1	AS BUILT	11.09.01	REH	DB	DB	PJD	A6	AS BUILT AO 600219	21.01.04	NH-J		RT	DB
		0	ISSUED FOR COMMISSIONING	20.11.00	WB	JG	JG	JG	A5	AS BUILT AO 600213	06.01.04	JFL	RT	RT	DB
		01N	ISSUED FOR NOTIFICATION	09.08.00	WB	RGK	JG	RGK	A4	AS BUILT SWO 13 & 63	07.01.03	NH-J	STÅ	RT	SN

SYSTEM NO.	82
WORK PACK NO.	
SCALE:	N.T.S.
PRODUCTION:	

Huldra EPC WHPT	
TITLE: PIPING AND INSTRUMENT DIAGRAM DIESEL POWER GENERATOR A LUBE OIL SYSTEM	
PROJECT NO.	C025-W-HO82-P-*U-004-01
CONTR.	
AREA/SYS	
DISC.	
TYPE	
NUMBER	
SHTNO	
REV.	A6

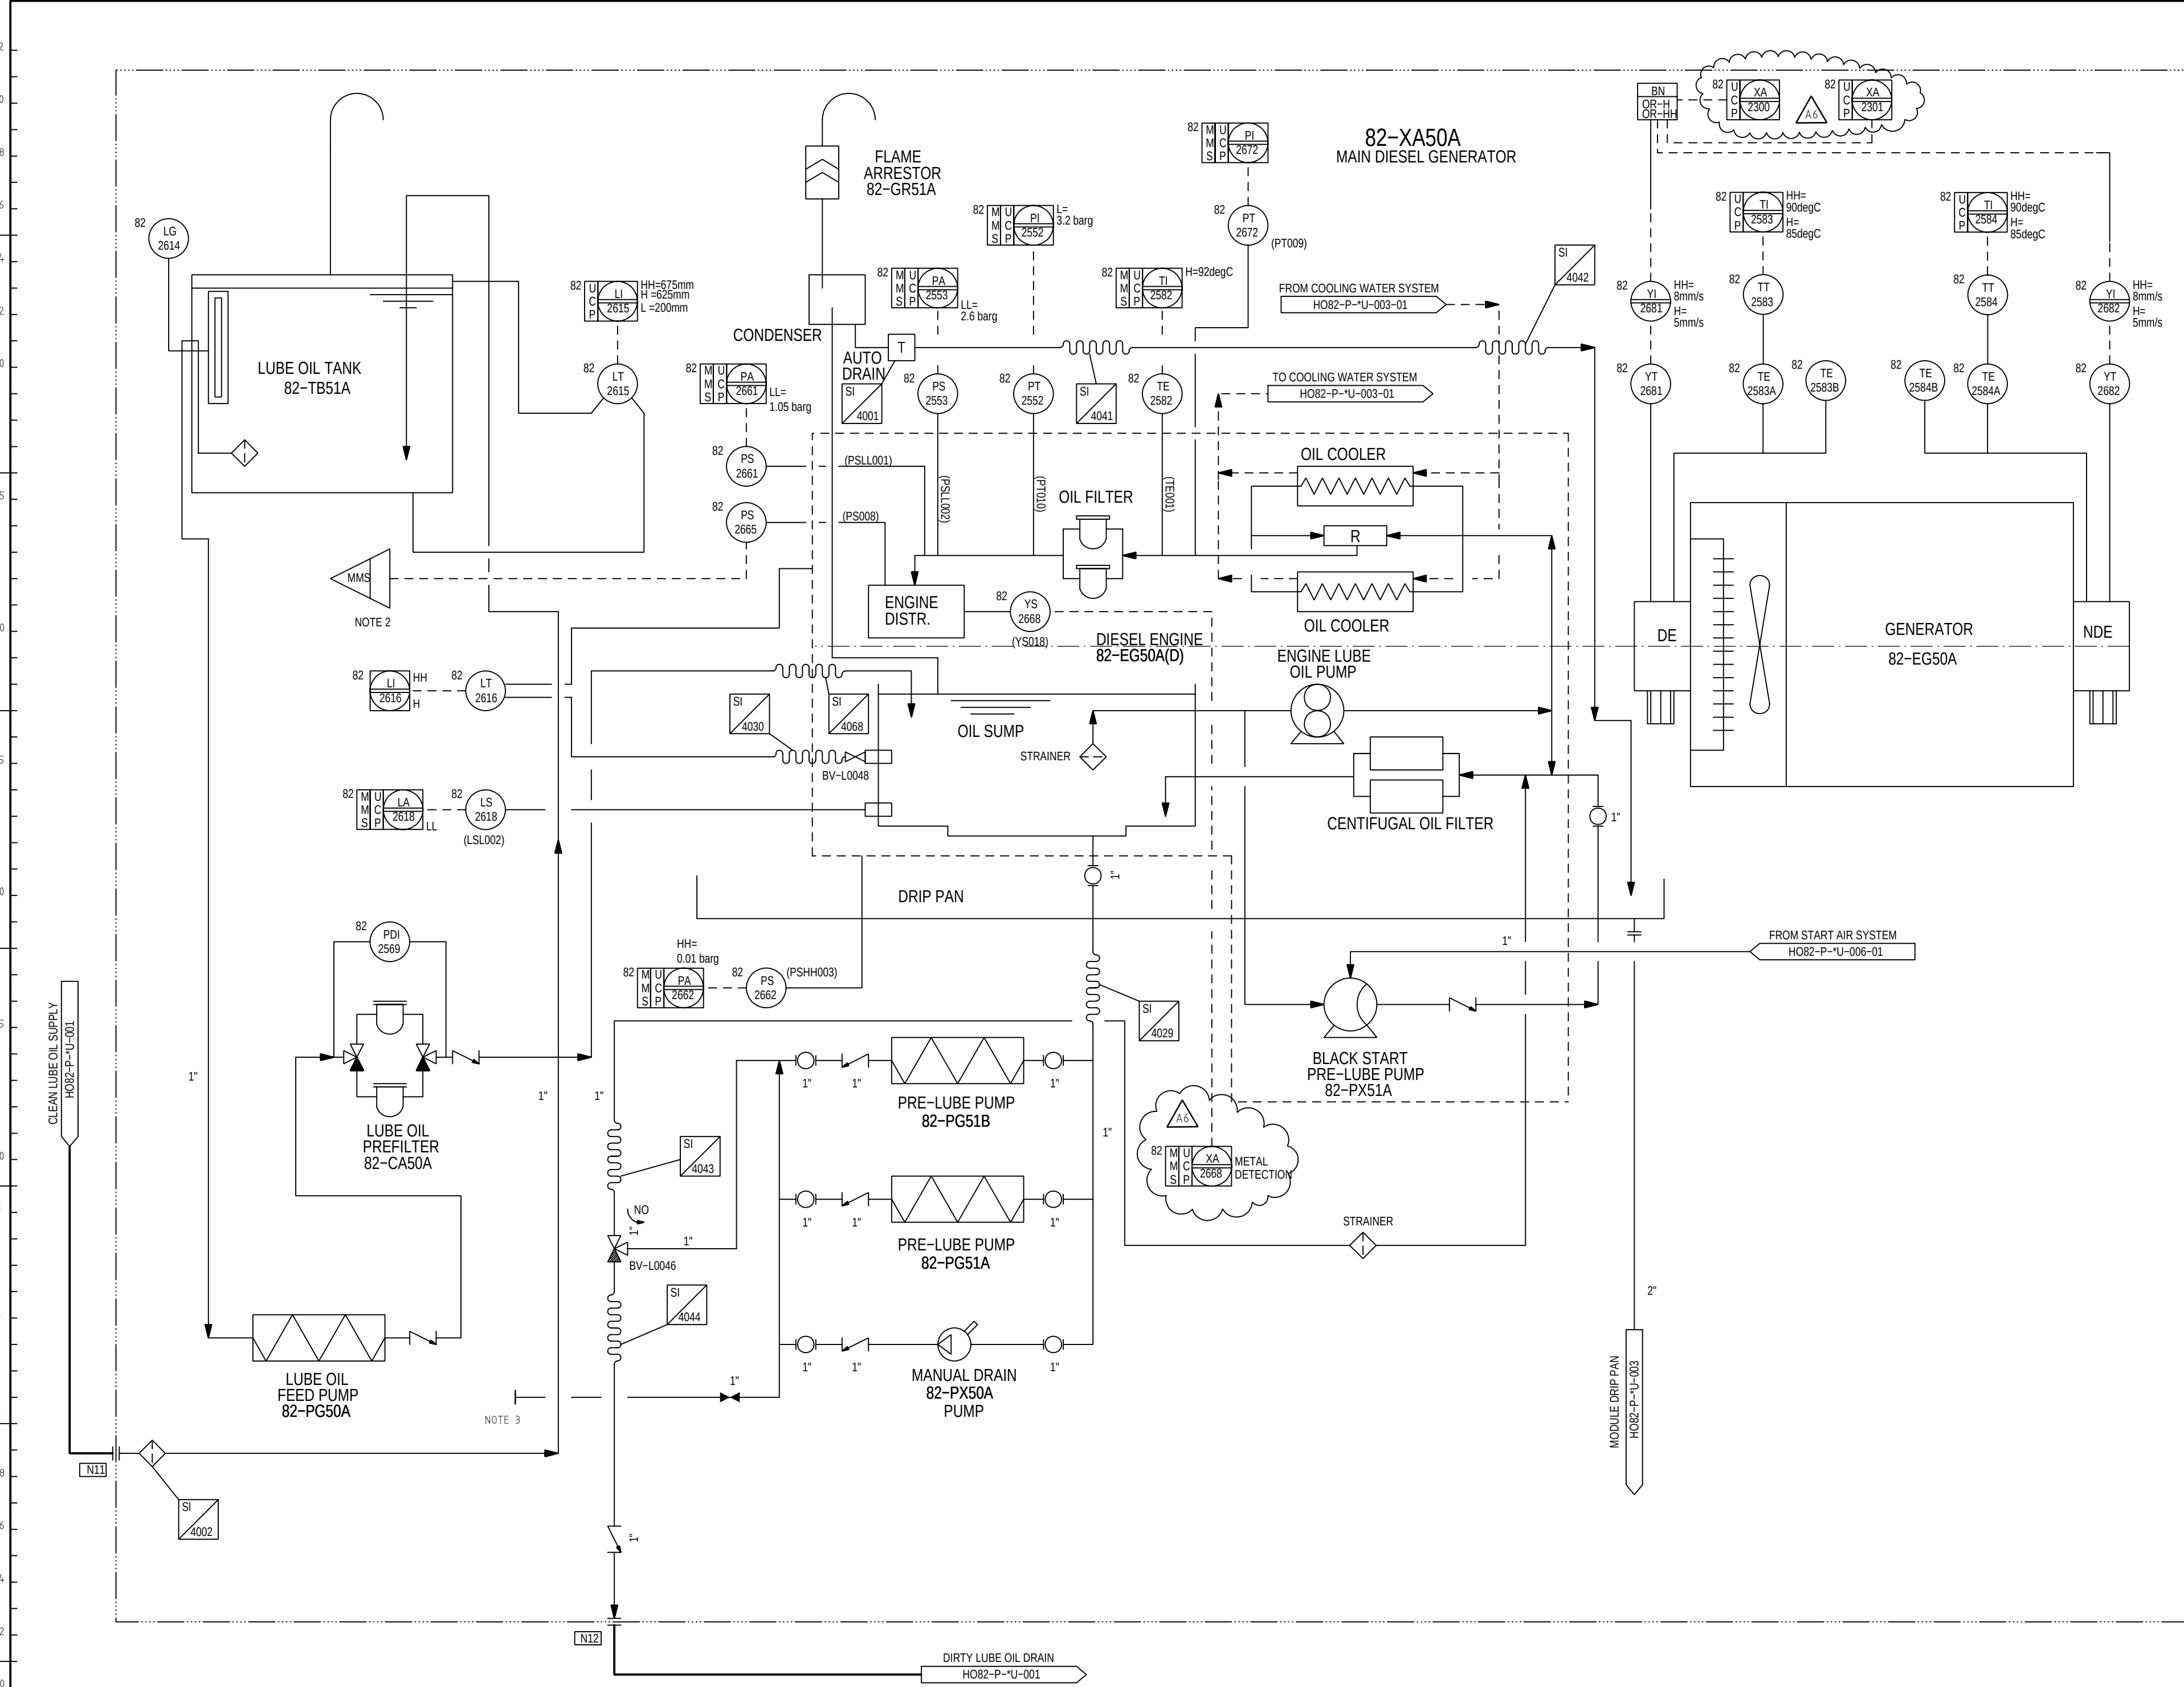

- NOTES
1. DELETED.
 2. START PERMISSIVE.
 3. THE PIPE DISMANTLED AND BLIND FLANGE MOUNTED.