



LOGICAL SYMBOLS

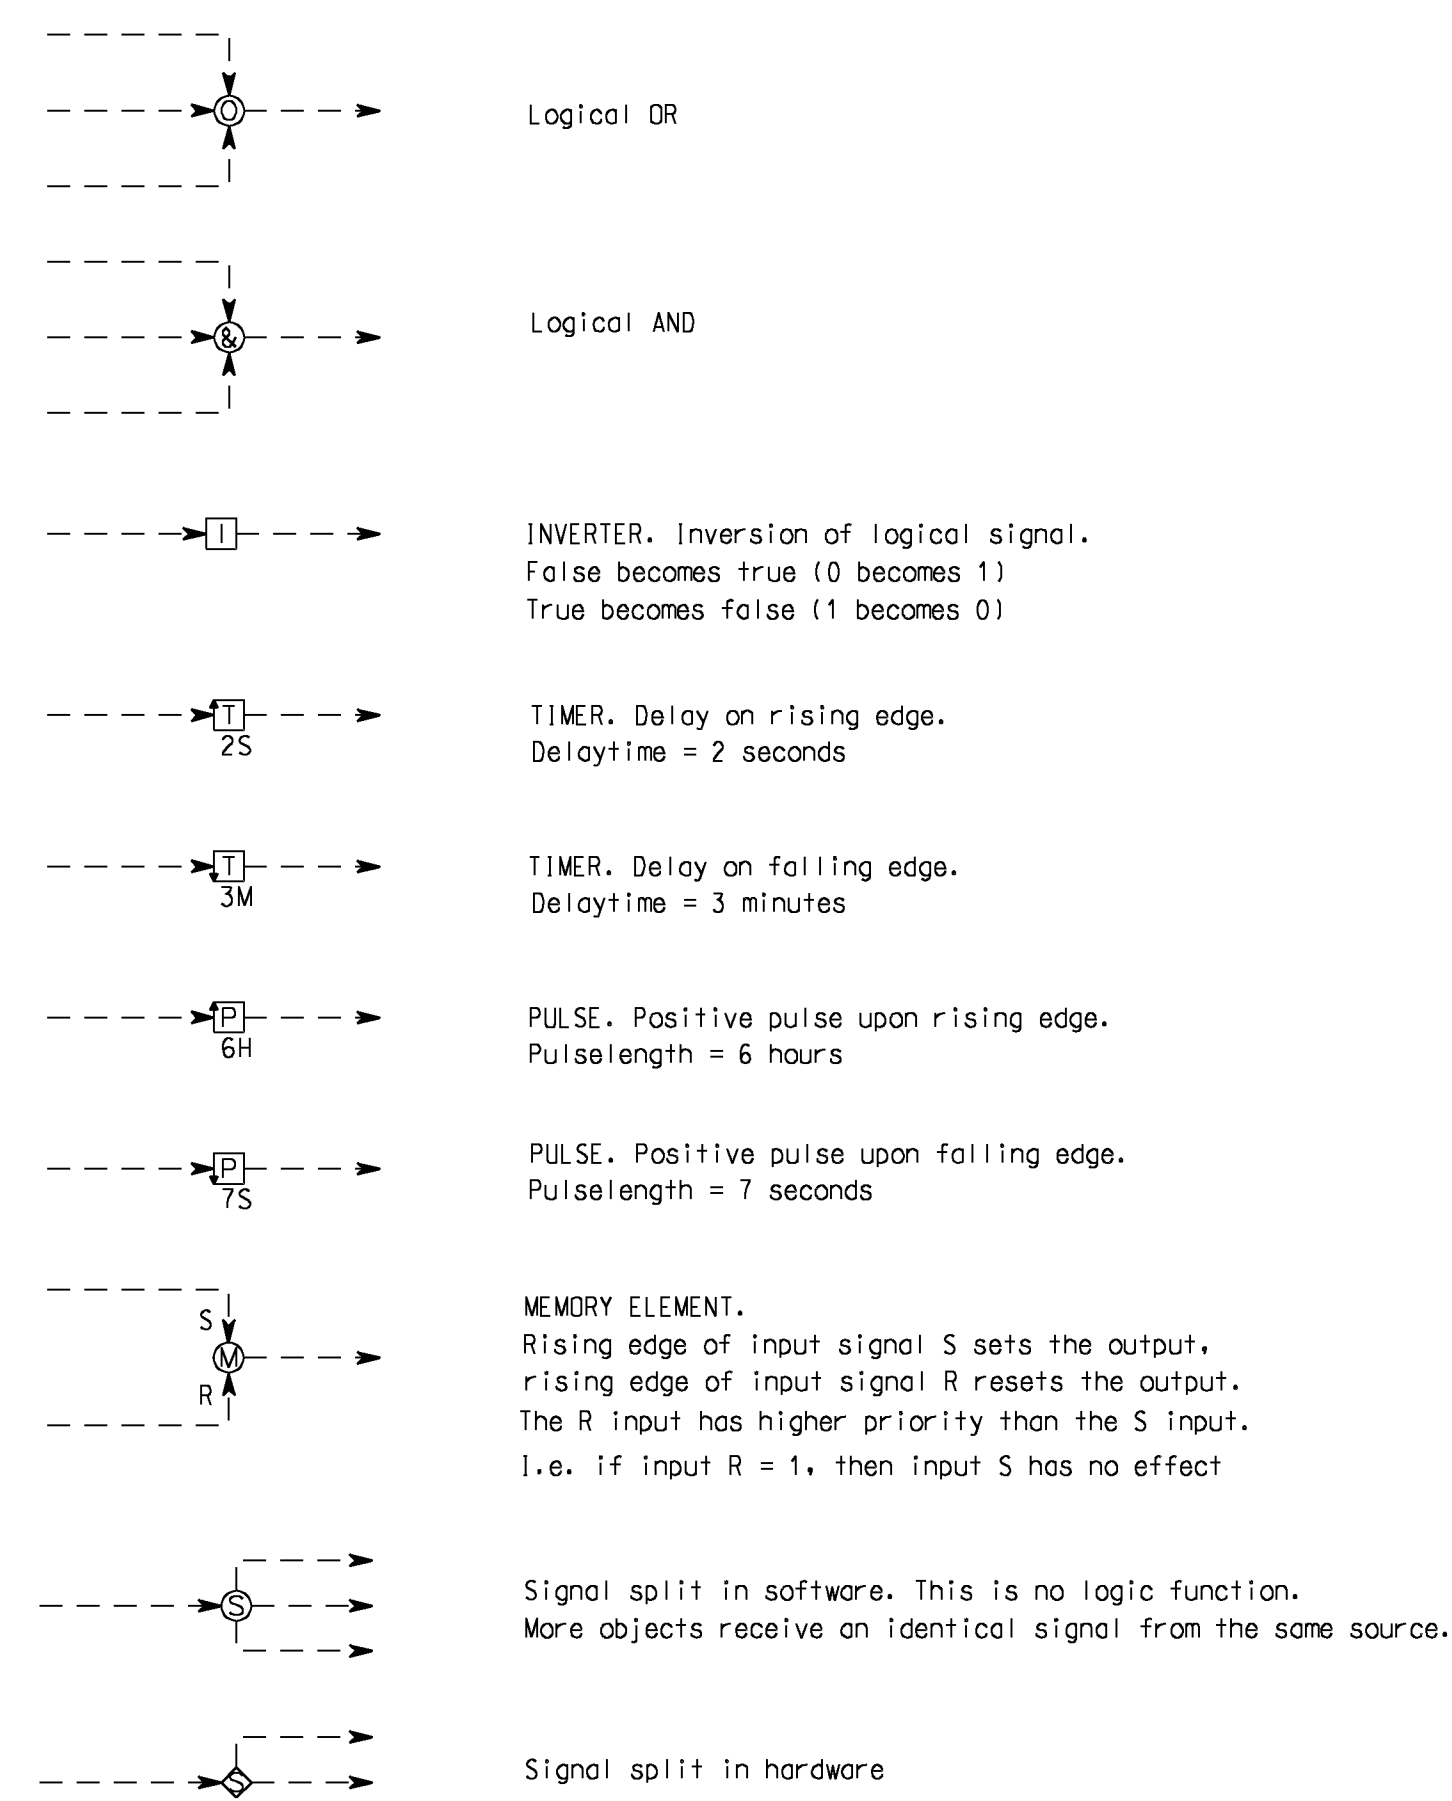

ANALOG ELEMENTS

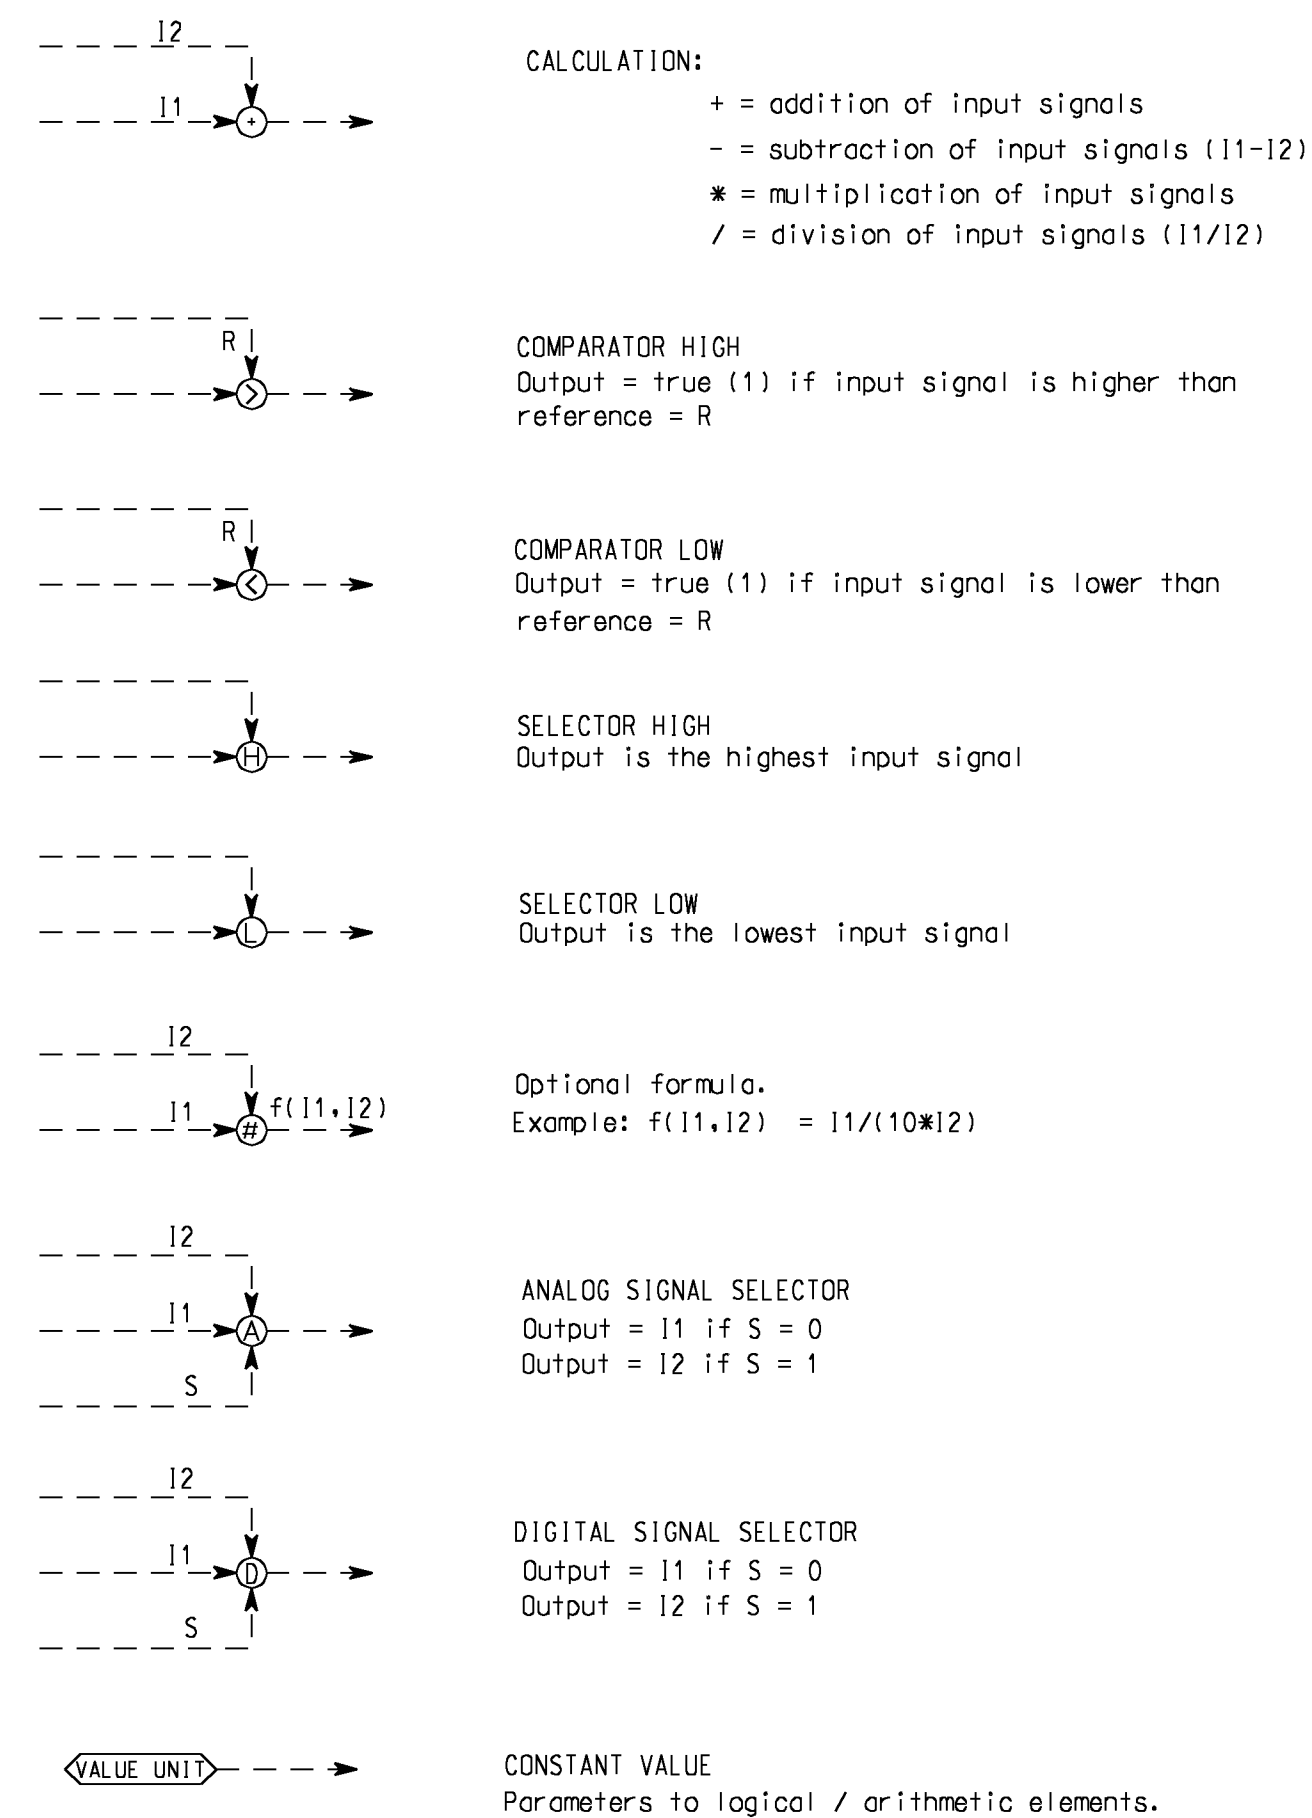

A1	30.09.01	AS BUILT	EiL				GS
0	31.03.01	ISSUED FOR CONSTRUCTION	SNo				
03D	10.03.00	RE-ISSUED FOR DESIGN	DD				
02D	26.11.99	ISSUED FOR DESIGN	SNo				
01R	25.10.99	ISSUED FOR REVIEW	SNo				
Rev.	Date	Description	Made by	Disc. check	Disc. appr.	Contr. appr.	Comp. appr.
Acceptance Codes: 1 ☐ 1B ☐ 2A ☐ 2 ☐ 3 ☐ 4 ☐			Signs				
Kværner Oil & Gas			Project : HULDRA EPC WHPT				
Drawing title :							
SYSTEM CONTROL DIAGRAM LEGEND 2, GENERAL				N/A			
				Tag no.			
				SDL Code		NTS	
P.O.No : 480018-P01-01				Scale		A1	
Siemens Doc.No :				Projection		Dwg.Format	
Drawing No : C025-W-H000-J-*E-011-01				00			
				Area Code		Syst.Code	
				1 of 1		A1	
				Sheet		Rev.	