



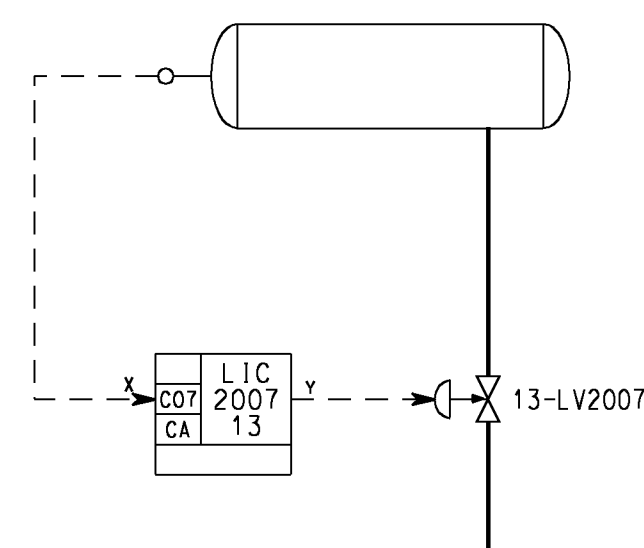


Analog control / Modulating control (PID Regulator)

The output Y is an analog value

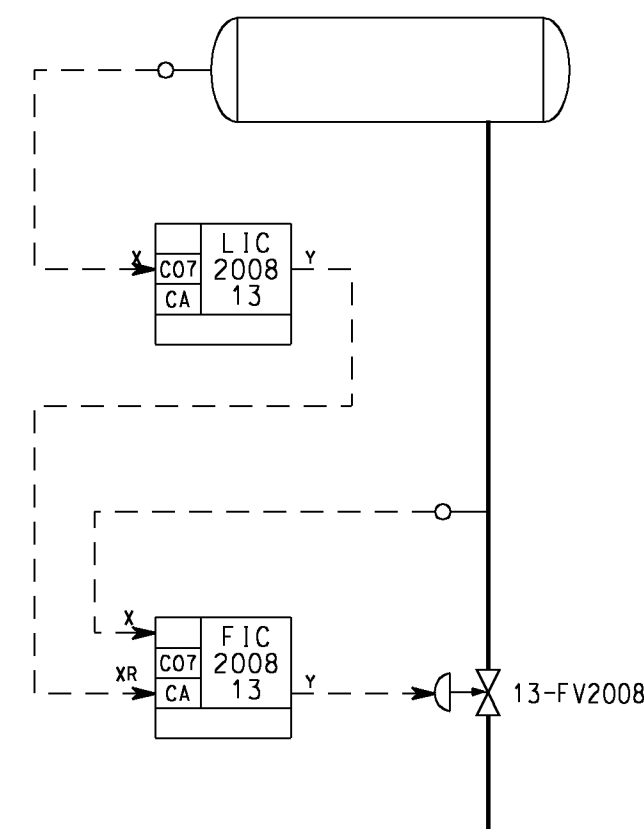


Cascaded controllers


The output from the levelcontroller gives the flow setpoint of the flowcontroller.

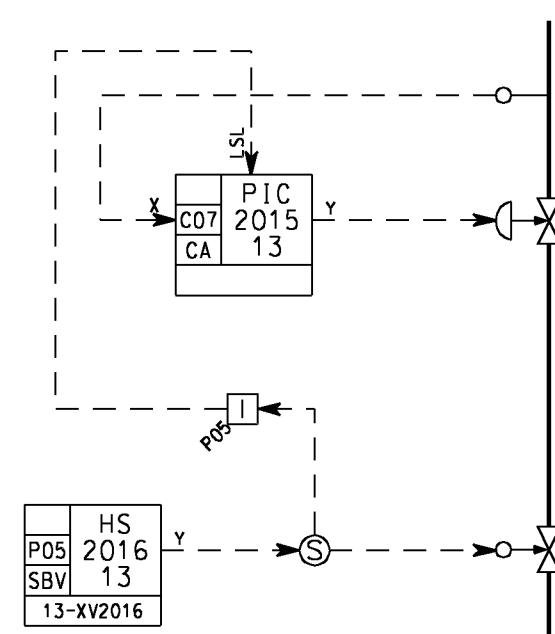

When the XV (PSD) valve closes, the pressure controller (PIC) is no longer able to control the pressure. Therefore the controller is disabled by setting it in manual and closing the control valve. The internode-signal to the LSL of the PIC is sent by the systembus.

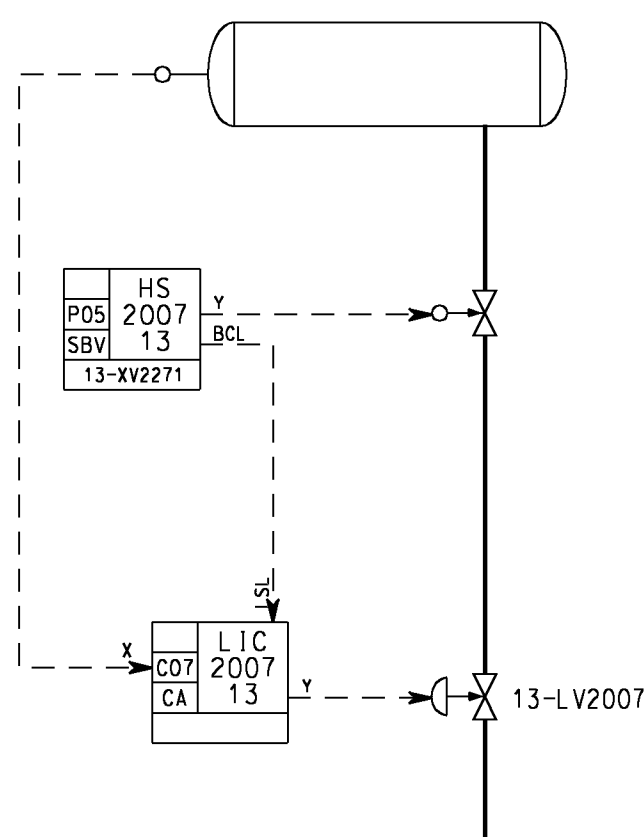


When the PSD valve is shut down, the level controller is disabled, and the level controller valve is thereby closed too.
When the PSD valve opens, the level controller remains in manual, and its valve remains closed.

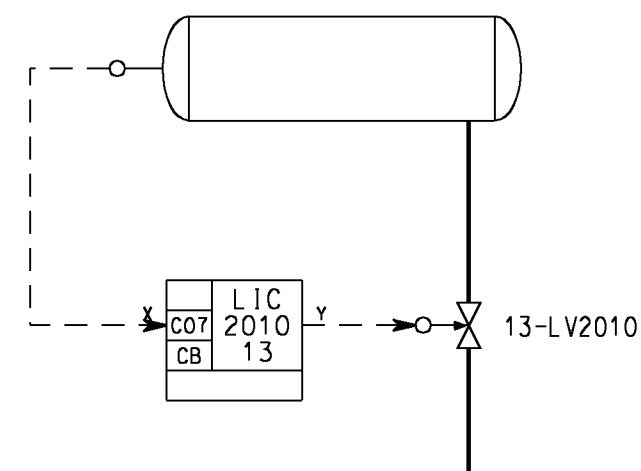


Binary control (ON/OFF regulator)

The output Y is a binary value

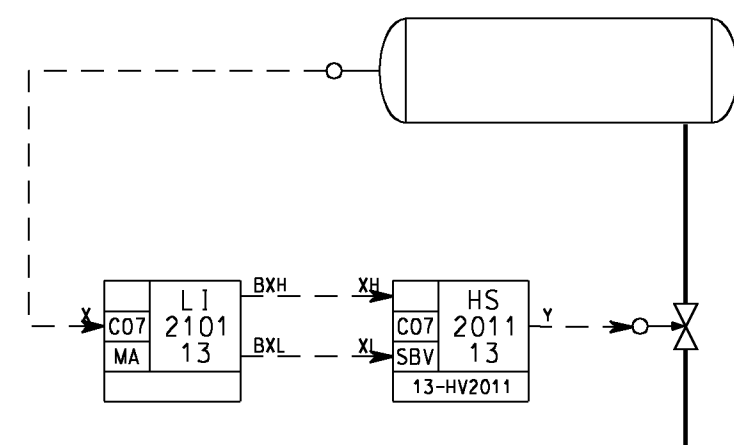


Alternative way of on-off control

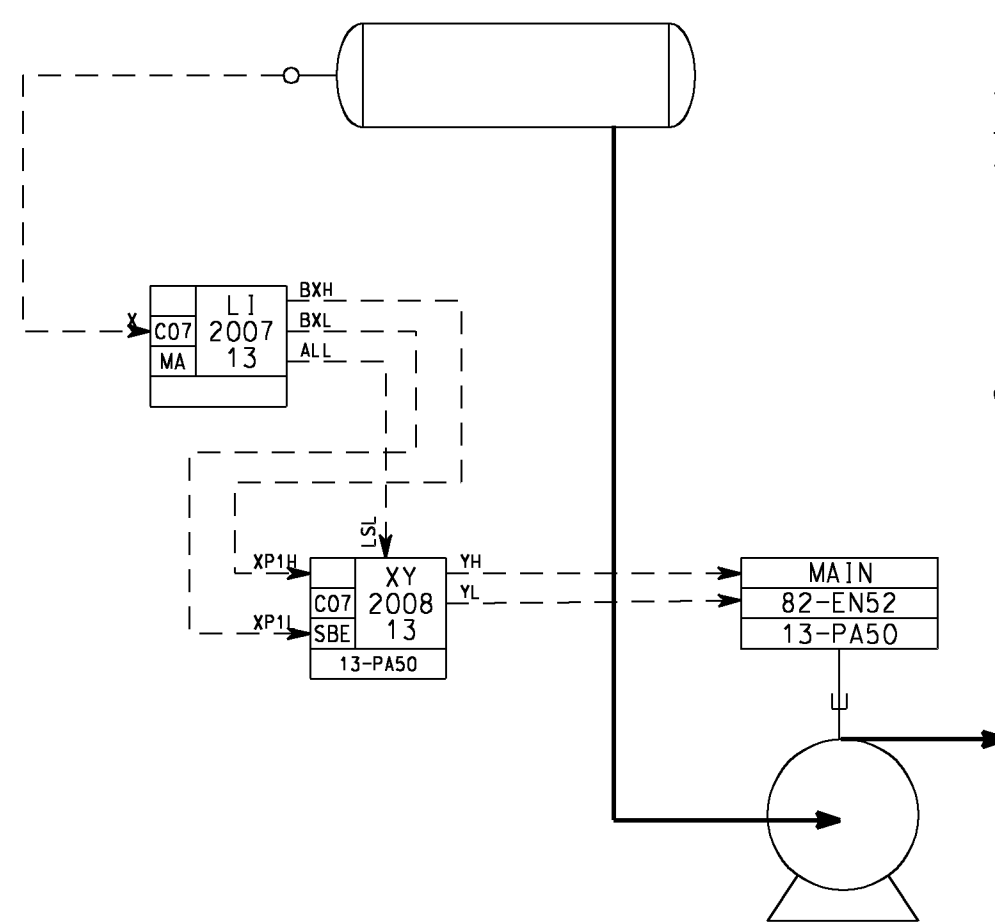

On-off level control using a pump. The pump is started when the level exceeds the BXH limit, and stopped when the level becomes lower than the BXL limit. The pump (i.e. the SBE) must be in auto mode when this on-off logic shall apply.

A shutdown at ALL level trips the pump even if it is in manual mode.

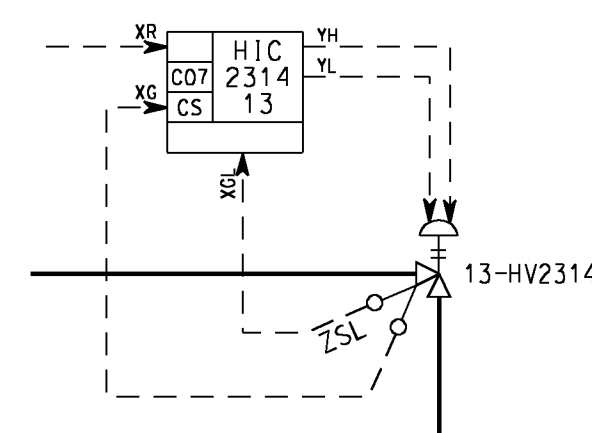

Stepwise control

The outputs YH/YL are pulses

Control of Choke valve

When the valve (i.e. the CS-block) is set to auto, the valve will automatically travel to its setpoint position. This setpoint can be set from either DS or from logic (using the XR-terminal). When the position feedback (XG) becomes equal to the setpoint, the valve will stop.

A1	30.09.01	AS BUILT	EIL				GS
0	31.03.01	ISSUED FOR CONSTRUCTION	SNO				
03D	10.03.00	RE-ISSUED FOR DESIGN	DD				
02D	26.11.99	ISSUED FOR DESIGN	SNO				
01R	25.10.99	ISSUED FOR REVIEW	SNO				
Rev.	Date	Description	Made by	Disc. check	Disc. appr.	Contr. appr.	Comp. appr.
Acceptance Code: 1 ☐ 1B ☐ 2A ☐ 2 ☐ 3 ☐ 4 ☐			Sign:				
 STATOIL Kværner Oil & Gas			Project:				
			HULDRA EPC WHPT				
Drawing title:							
SYSTEM CONTROL DIAGRAM							
LEGEND 6, CONTROLLERS							
P.I.D. No: 480018-P01-01							
Siemens Doc.No:							
C025-W-H000-J- W E-015-01							
Drawing No: 100							
Sheet							
Drawing No: 1 of 1							
Rev.							