


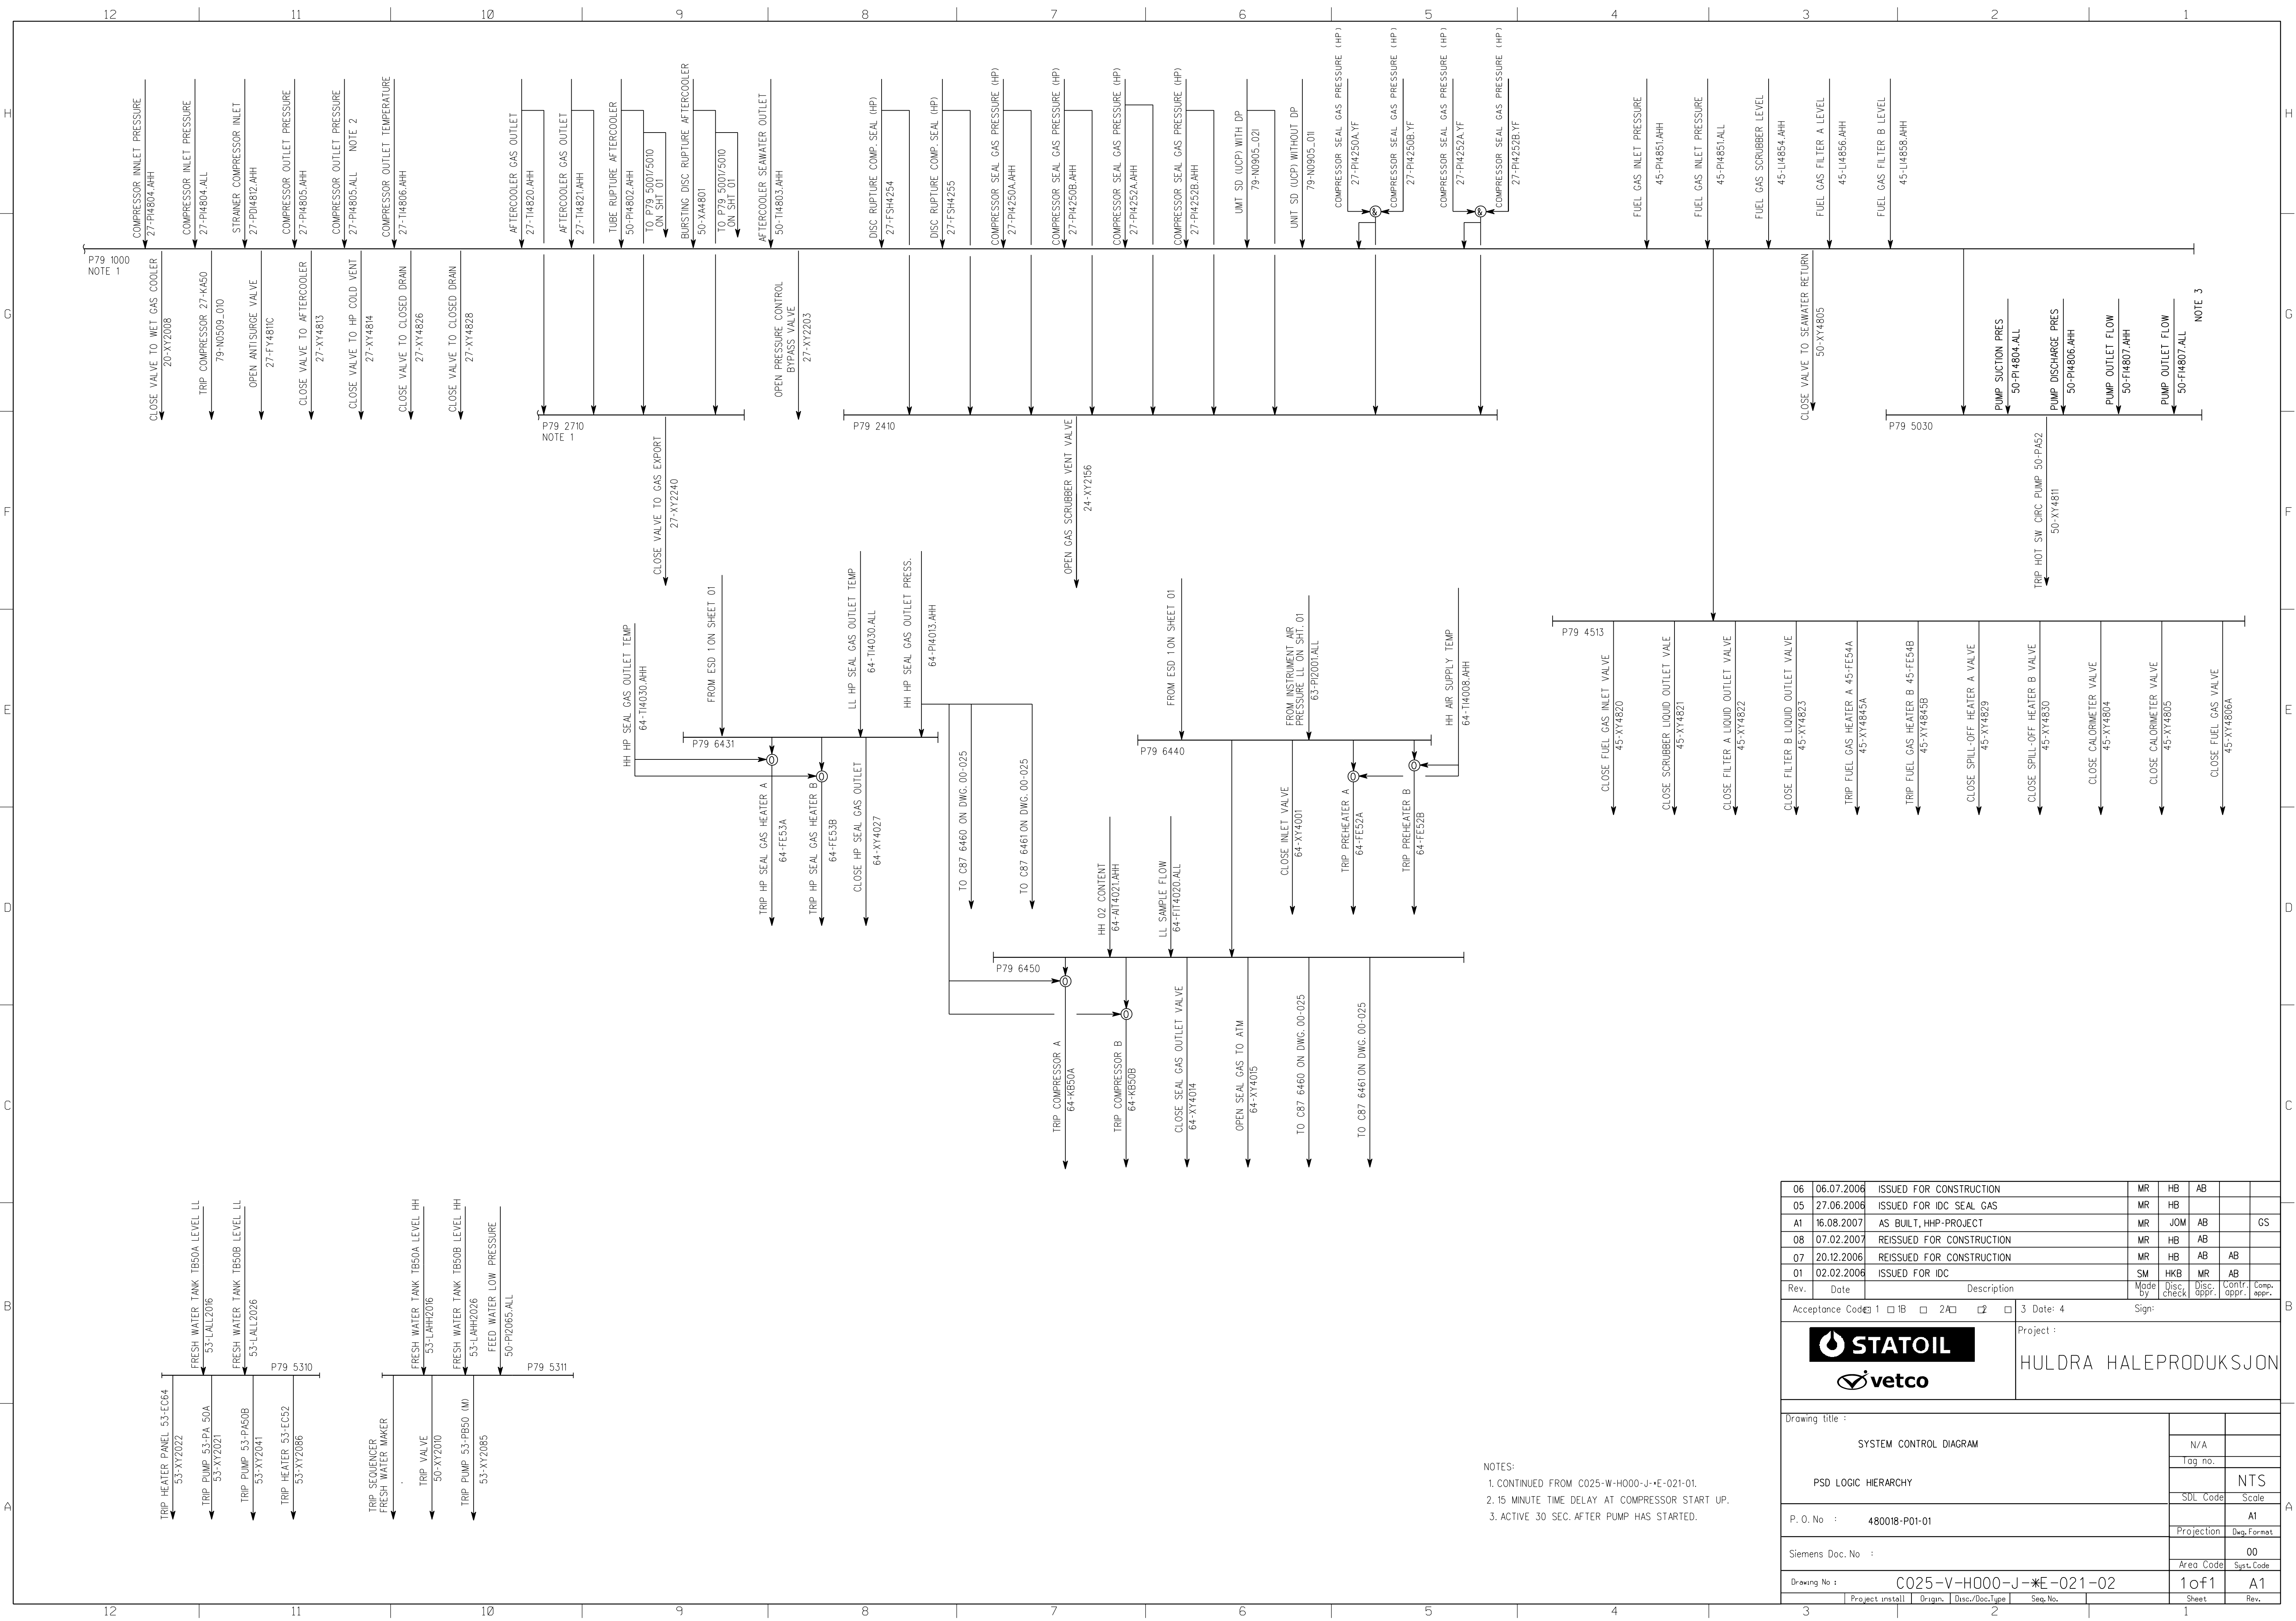

NOTES:
1. CONTINUED FROM C025-W-H000-J-•E-021-01.
2. 15 MINUTE TIME DELAY AT COMPRESSOR START UP.
3. ACTIVE 30 SEC. AFTER PUMP HAS STARTED.

06	06.07.2006	ISSUED FOR CONSTRUCTION	MR	HB	AB			
05	27.06.2006	ISSUED FOR IDC SEAL GAS	MR	HB				
A1	16.08.2007	AS BUILT, HHP-PROJECT	MR	JOM	AB			GS
08	07.02.2007	REISSUED FOR CONSTRUCTION	MR	HB	AB			
07	20.12.2006	REISSUED FOR CONSTRUCTION	MR	HB	AB	AB		
01	02.02.2006	ISSUED FOR IDC	SM	HKB	MR	AB		
Rev.	Date	Description	Made by	Disc. check	Disc. appr.	Contr. appr.	Comp. appr.	
Acceptance Code ☒ 1 ☐ 1B ☐ 2A ☒ 3			Date: 4		Sign:			
 			Project : HULDRA HALEPRODUKSJON					
Drawing title : SYSTEM CONTROL DIAGRAM								
PSD LOGIC HIERARCHY						N/A		
						Tag no.		
						SDL Code		NTS
P. O. No : 480018-P01-01						Scale		A1
Siemens Doc. No :						Projection		Dwg. Format
								00
Drawing No : C025-V-H000-J-*E-021-02						Area Code		Syst. Code
								1 of 1
Project install			Origin			Disc./Doc.Type		
Seq. No.						Sheet		
						Rev.		