


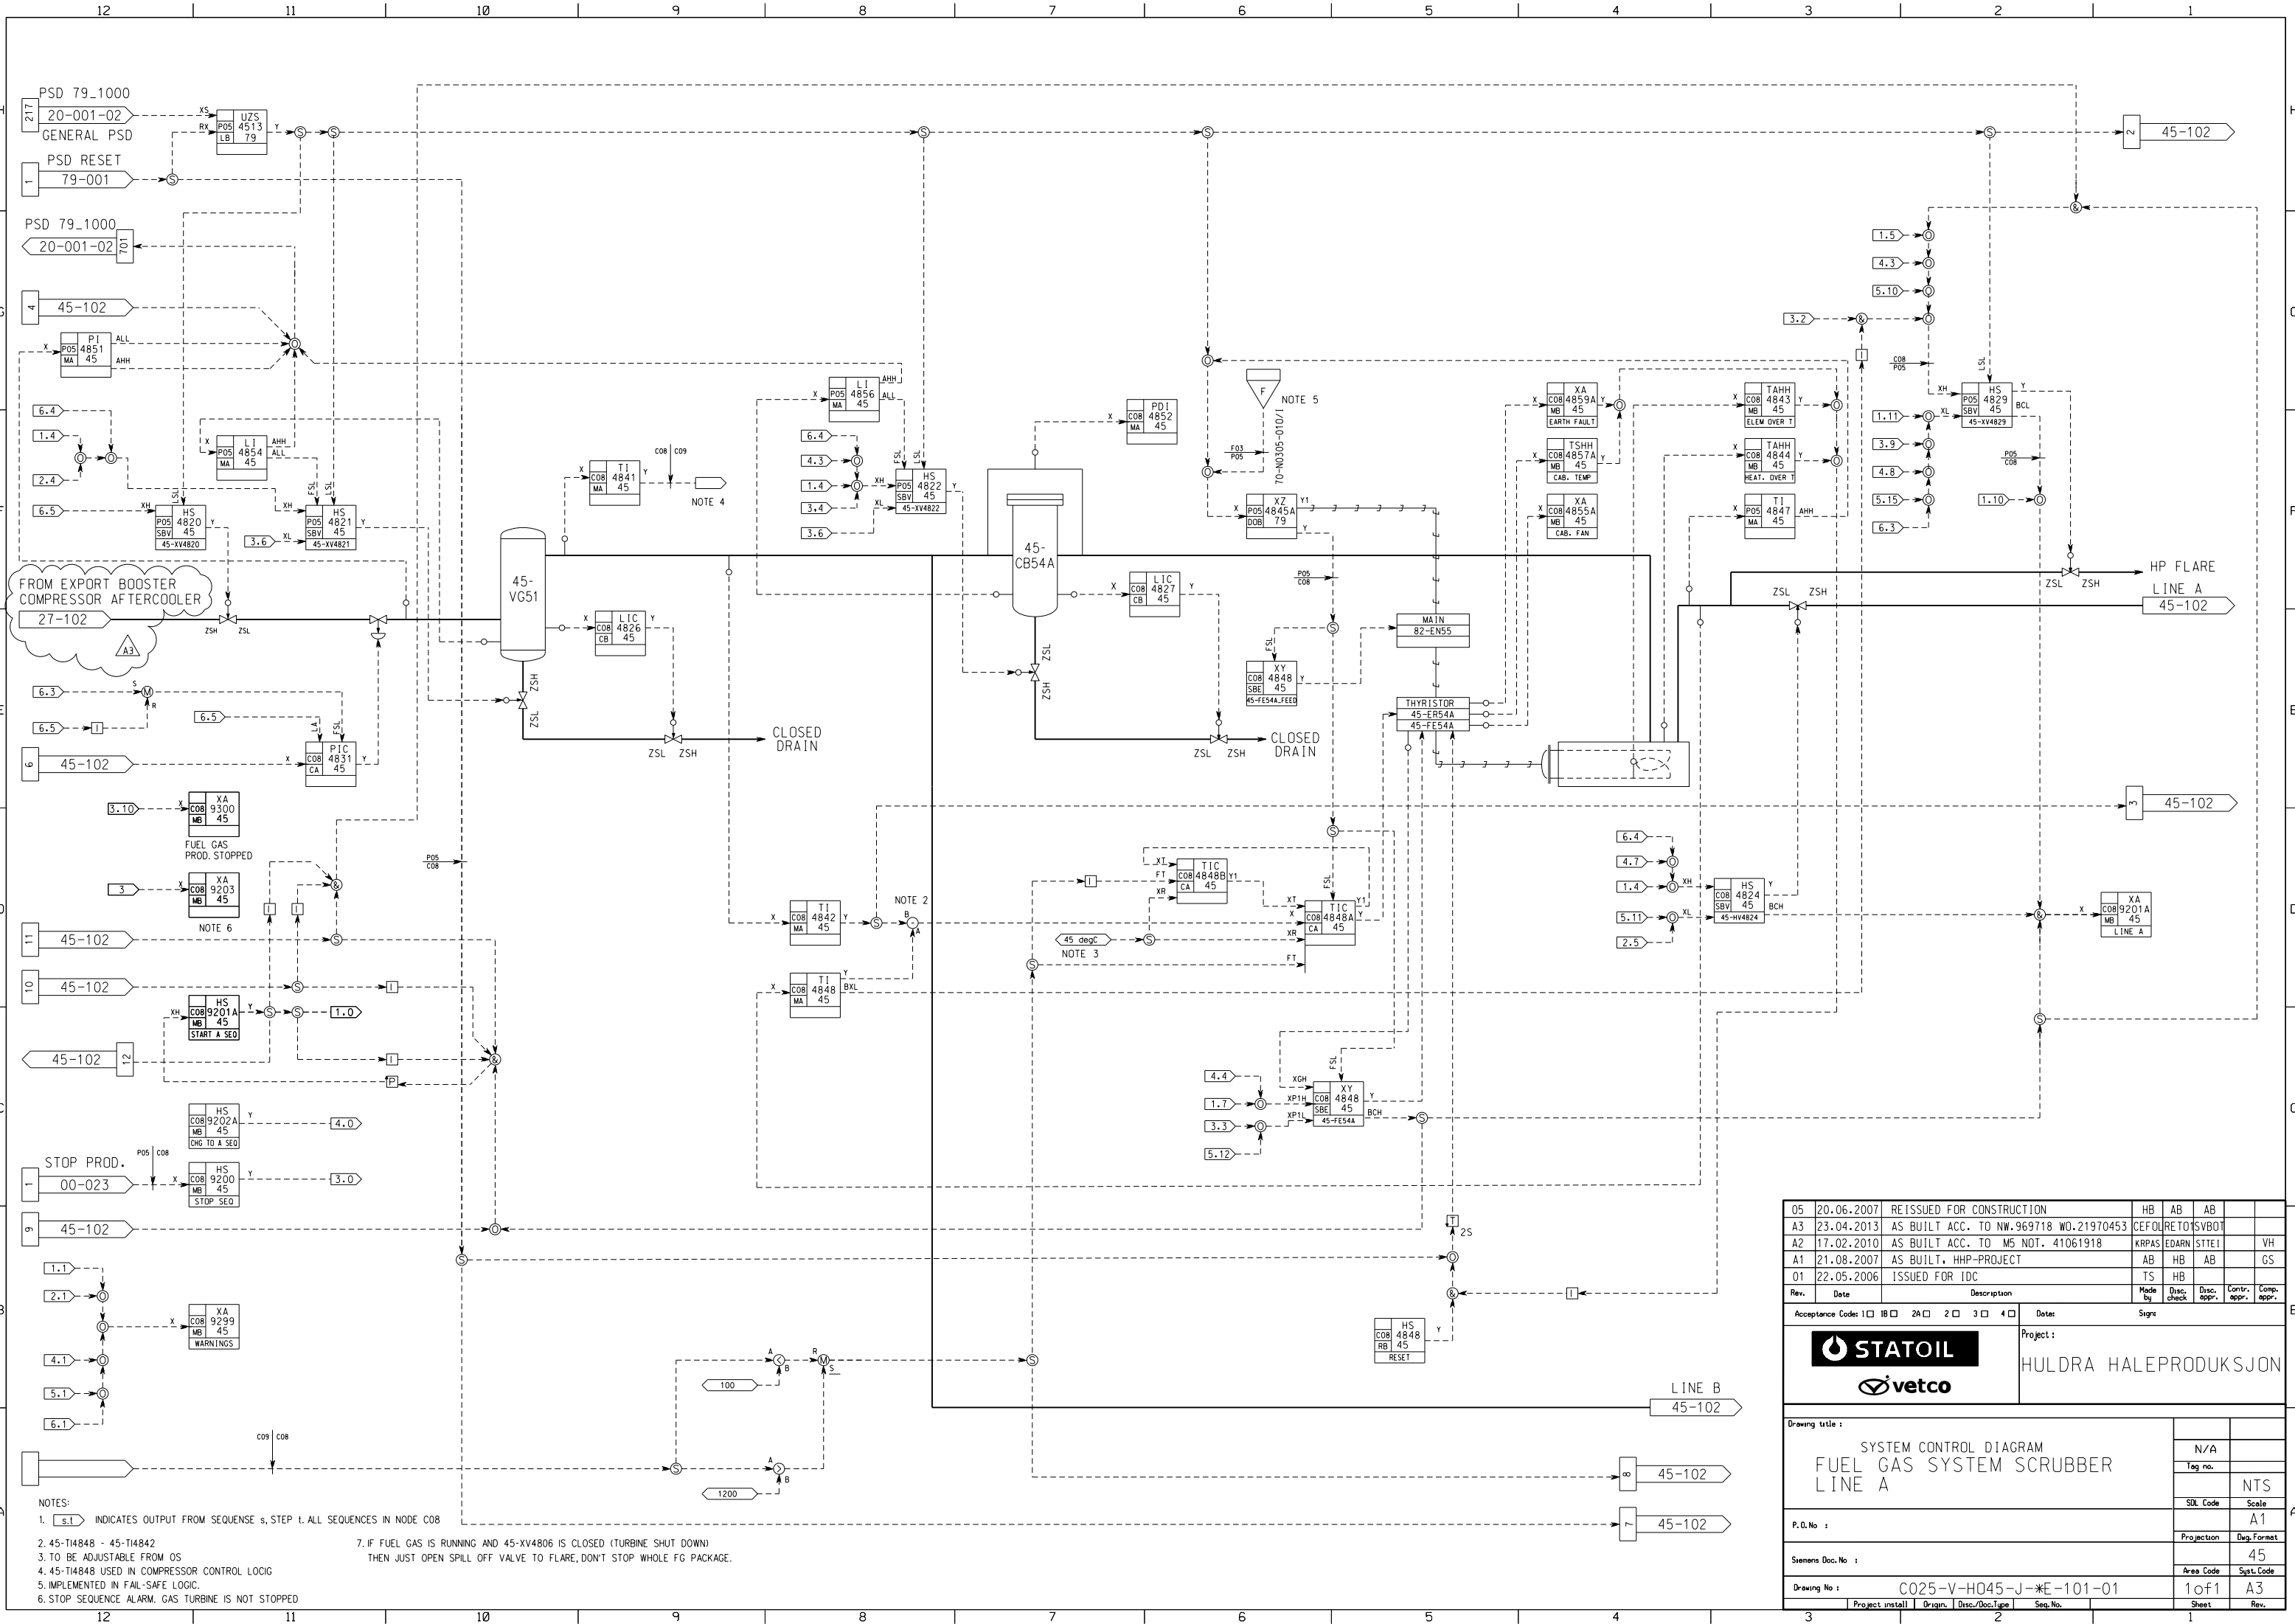

NOTES:
1. INDICATES OUTPUT FROM SEQUENCE s, STEP t. ALL SEQUENCES IN NODE COB
2. 45-TI4848 - 45-TI4842
3. TO BE ADJUSTABLE FROM OS
4. 45-TI4848 USED IN COMPRESSOR CONTROL LOGIC
5. IMPLEMENTED IN FAIL-SAFE LOGIC.
6. STOP SEQUENCE ALARM. GAS TURBINE IS NOT STOPPED
7. IF FUEL GAS IS RUNNING AND 45-XV4806 IS CLOSED (TURBINE SHUT DOWN) THEN JUST OPEN SPILL OFF VALVE TO FLARE, DON'T STOP WHOLE FG PACKAGE.

05	20.06.2007	REISSUED FOR CONSTRUCTION	HB	AB	AB		
A3	23.04.2013	AS BUILT ACC. TO NW.969718 WO.21970453	CEFO	RETO	SVBOT		
A2	17.02.2010	AS BUILT ACC. TO M5 NOT. 41061918	KRPAS	EDARN	STTEI		VH
A1	21.08.2007	AS BUILT, HHP-PROJECT	AB	HB	AB		GS
01	22.05.2006	ISSUED FOR IDC	TS	HB			
Rev.	Date	Description	Mode by	Disc. check	Disc. appr.	Contr. appr.	Comp. appr.
Acceptance Codes: 1 ☐ IB ☐ 2A ☐ 2 ☐ 3 ☐ 4 ☐			Signe				
			Project: HULDRA HALEPRODUKSJON				
Drawing title:			N/A				
			Tag no.		NTS		
			SIL Code		Scale		
P.O. No.:			Projection		A1		
Siemens Doc. No.:			Area Code		45		
Drawing No.:			1 of 1		A3		
Project install			Origins		Seq. No.		
			Disc./Doc. Type		Sheet		