


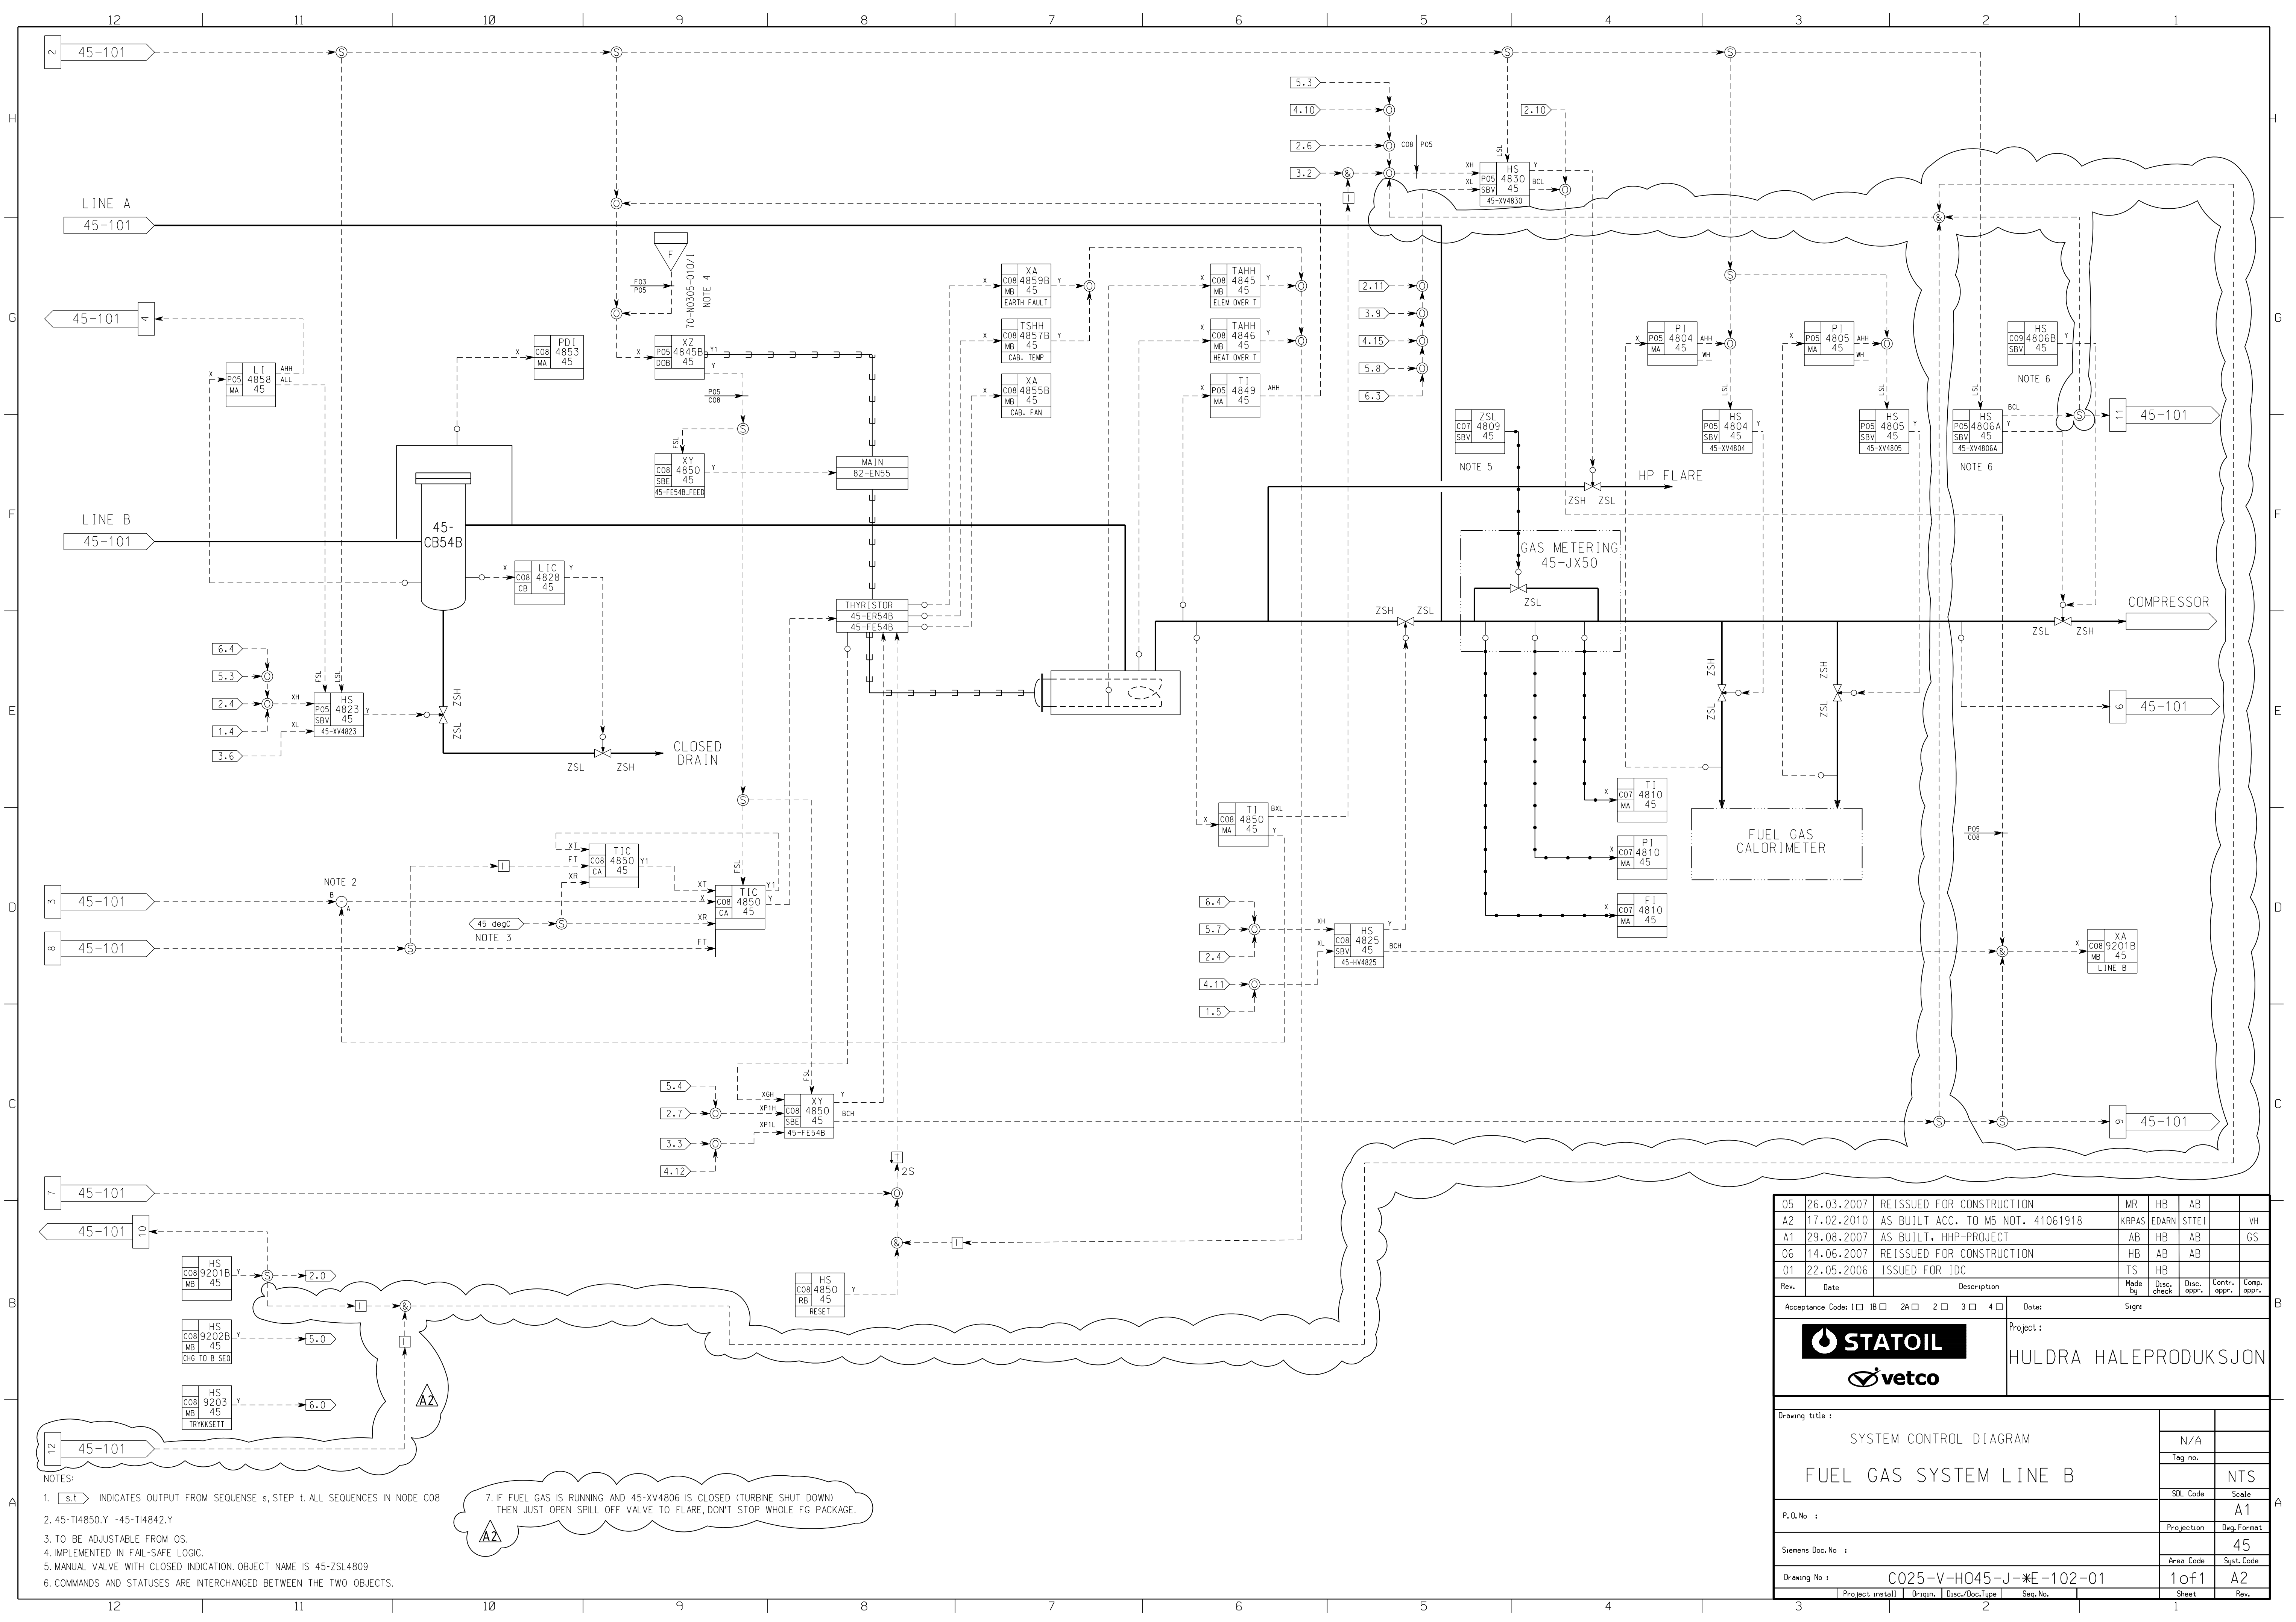

NOTES:

1. INDICATES OUTPUT FROM SEQUENCE s, STEP t. ALL SEQUENCES IN NODE COB

2. 45-TI4850.Y -45-TI4842.Y

3. TO BE ADJUSTABLE FROM OS.

4. IMPLEMENTED IN FAIL-SAFE LOGIC.

5. MANUAL VALVE WITH CLOSED INDICATION. OBJECT NAME IS 45-ZSL4809

6. COMMANDS AND STATUSES ARE INTERCHANGED BETWEEN THE TWO OBJECTS.

7. IF FUEL GAS IS RUNNING AND 45-XV4806 IS CLOSED (TURBINE SHUT DOWN) THEN JUST OPEN SPILL OFF VALVE TO FLARE, DON'T STOP WHOLE FG PACKAGE.

05	26.03.2007	REISSUED FOR CONSTRUCTION	MR	HB	AB		
A2	17.02.2010	AS BUILT ACC. TO M5 NOT. 41061918	KRPAS	EDARN	STTEI		VH
A1	29.08.2007	AS BUILT, HHP-PROJECT	AB	HB	AB		GS
06	14.06.2007	REISSUED FOR CONSTRUCTION	HB	AB	AB		
01	22.05.2006	ISSUED FOR IDC	TS	HB			
Rev.	Date	Description	Made by	Disc. check	Disc. appr.	Contr. appr.	Comp. appr.
Acceptance Codes: 1 ☐ IB ☐ 2A ☐ 2 ☐ 3 ☐ 4 ☐			Date: _____ Signs: _____				
			Project: HULDRA HALEPRODUKSJON				
Drawing title: SYSTEM CONTROL DIAGRAM			N/A				
FUEL GAS SYSTEM LINE B			Tag no. NTS				
P.O. No: _____			Scale: A1				
Siemens Doc. No: _____			Projection: Dwg. Format: 45				
Drawing No: C025-V-H045-J-✱E-102-01			Area Code: 1 of 1				
Project install			Design				
Disc./Doc. type			Seq. No.				
			Sheet				
			Rev.				