

A1	25.05.2007	AS BUILT, HHP- PROJECT	AB	HB	AB		GS
03	16.03.2006	ISSUED FOR CONSTRUCTION	HB	MR	AB	GS	
02	03.03.2006	REISSUED FOR IDC	HB	MR	AB	GS	
01	30.01.2006	ISSUED FOR IDC	HB	MR	AB	GS	
Rev.	Date	Description	Made by	Disc. check	Disc. appr.	Contr. appr.	Comp. appr.


Acceptance Codes: ☐ 1B ☐ 2A ☐ 2 ☐ 3 ☐ 4 ☐ 5
Signs: _____




Project :
HULDRA HALEPRODUKSJON

Drawing title :
SYSTEM CONTROL DIAGRAM
AUTOMATIC FILTER CLEANING

	N/A
Tag no.	
SOL Code	NTS
P.O.No :	A1
Projection	Dwg.Format
Siemens Doc.No :	53
Area Code	Syst.Code
Drawing No : C025-V-H053-J-✱E-102-01	1 of 1
Project install	Origin
Disc./Doc.Type	Seq.No.
Sheet	Rev.

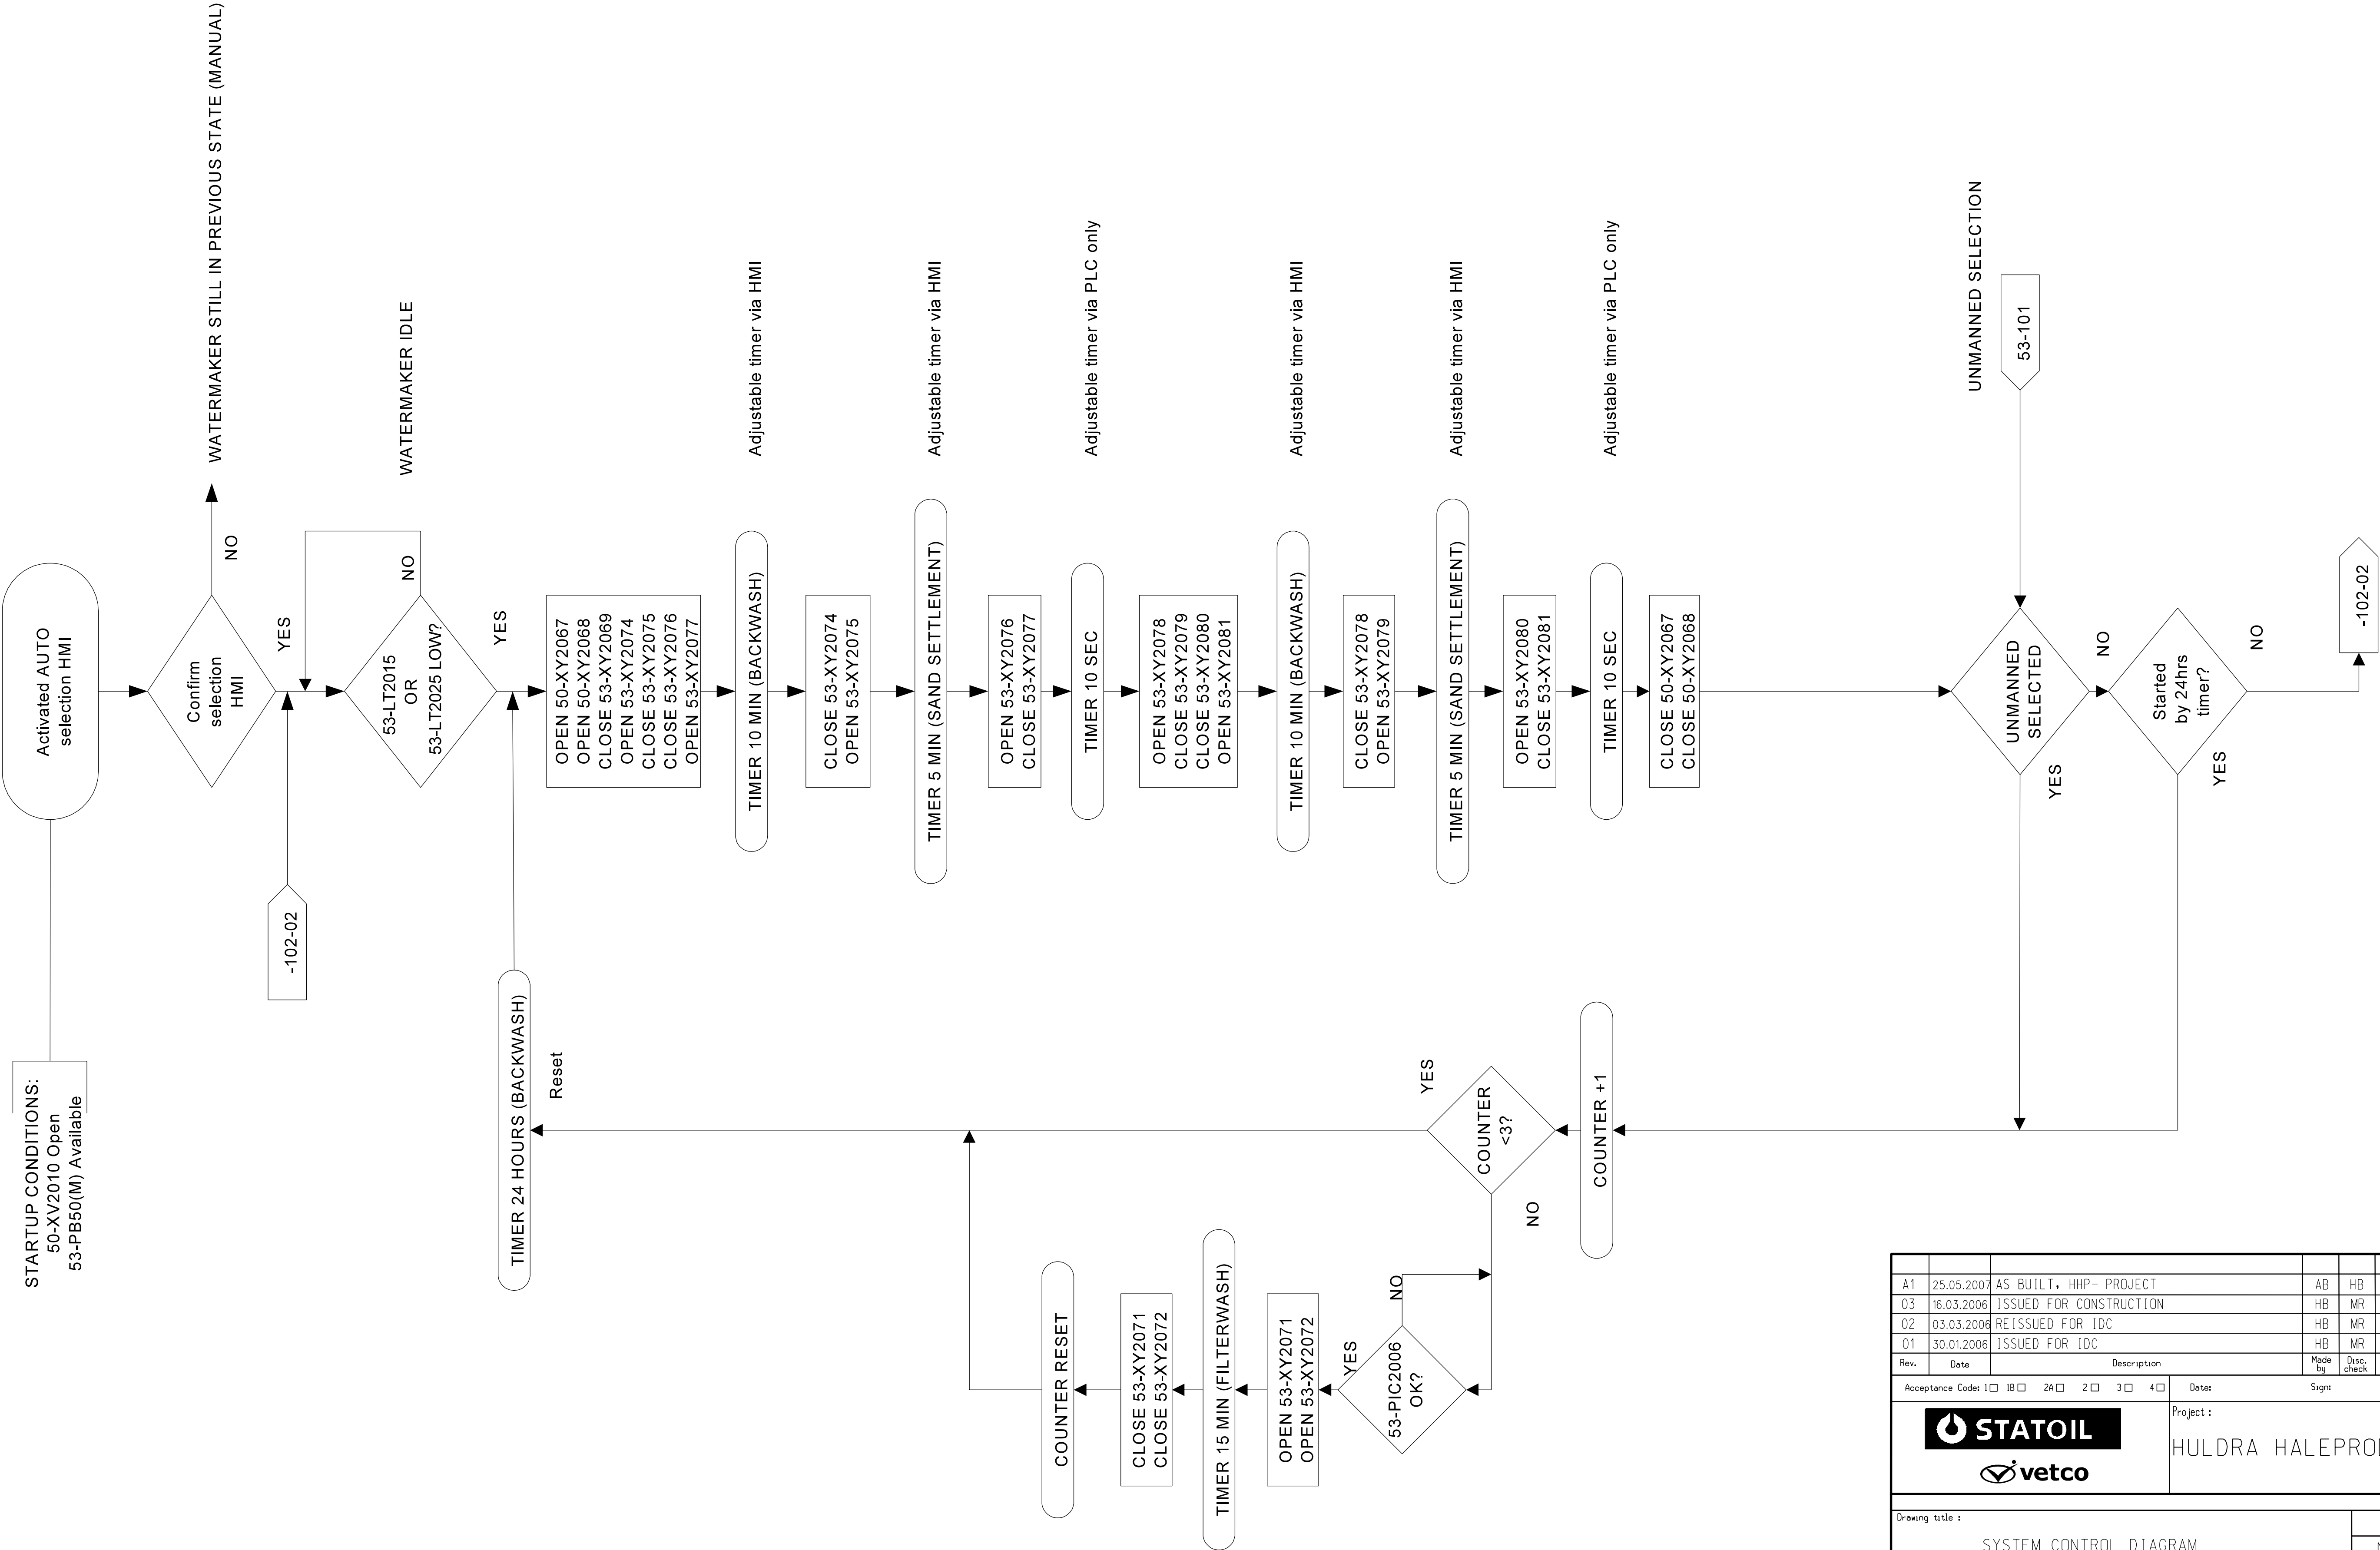

12 11 10 9 8 7 6 5 4 3 2 1

12 11 10 9 8 7 6 5 4 3 2 1