


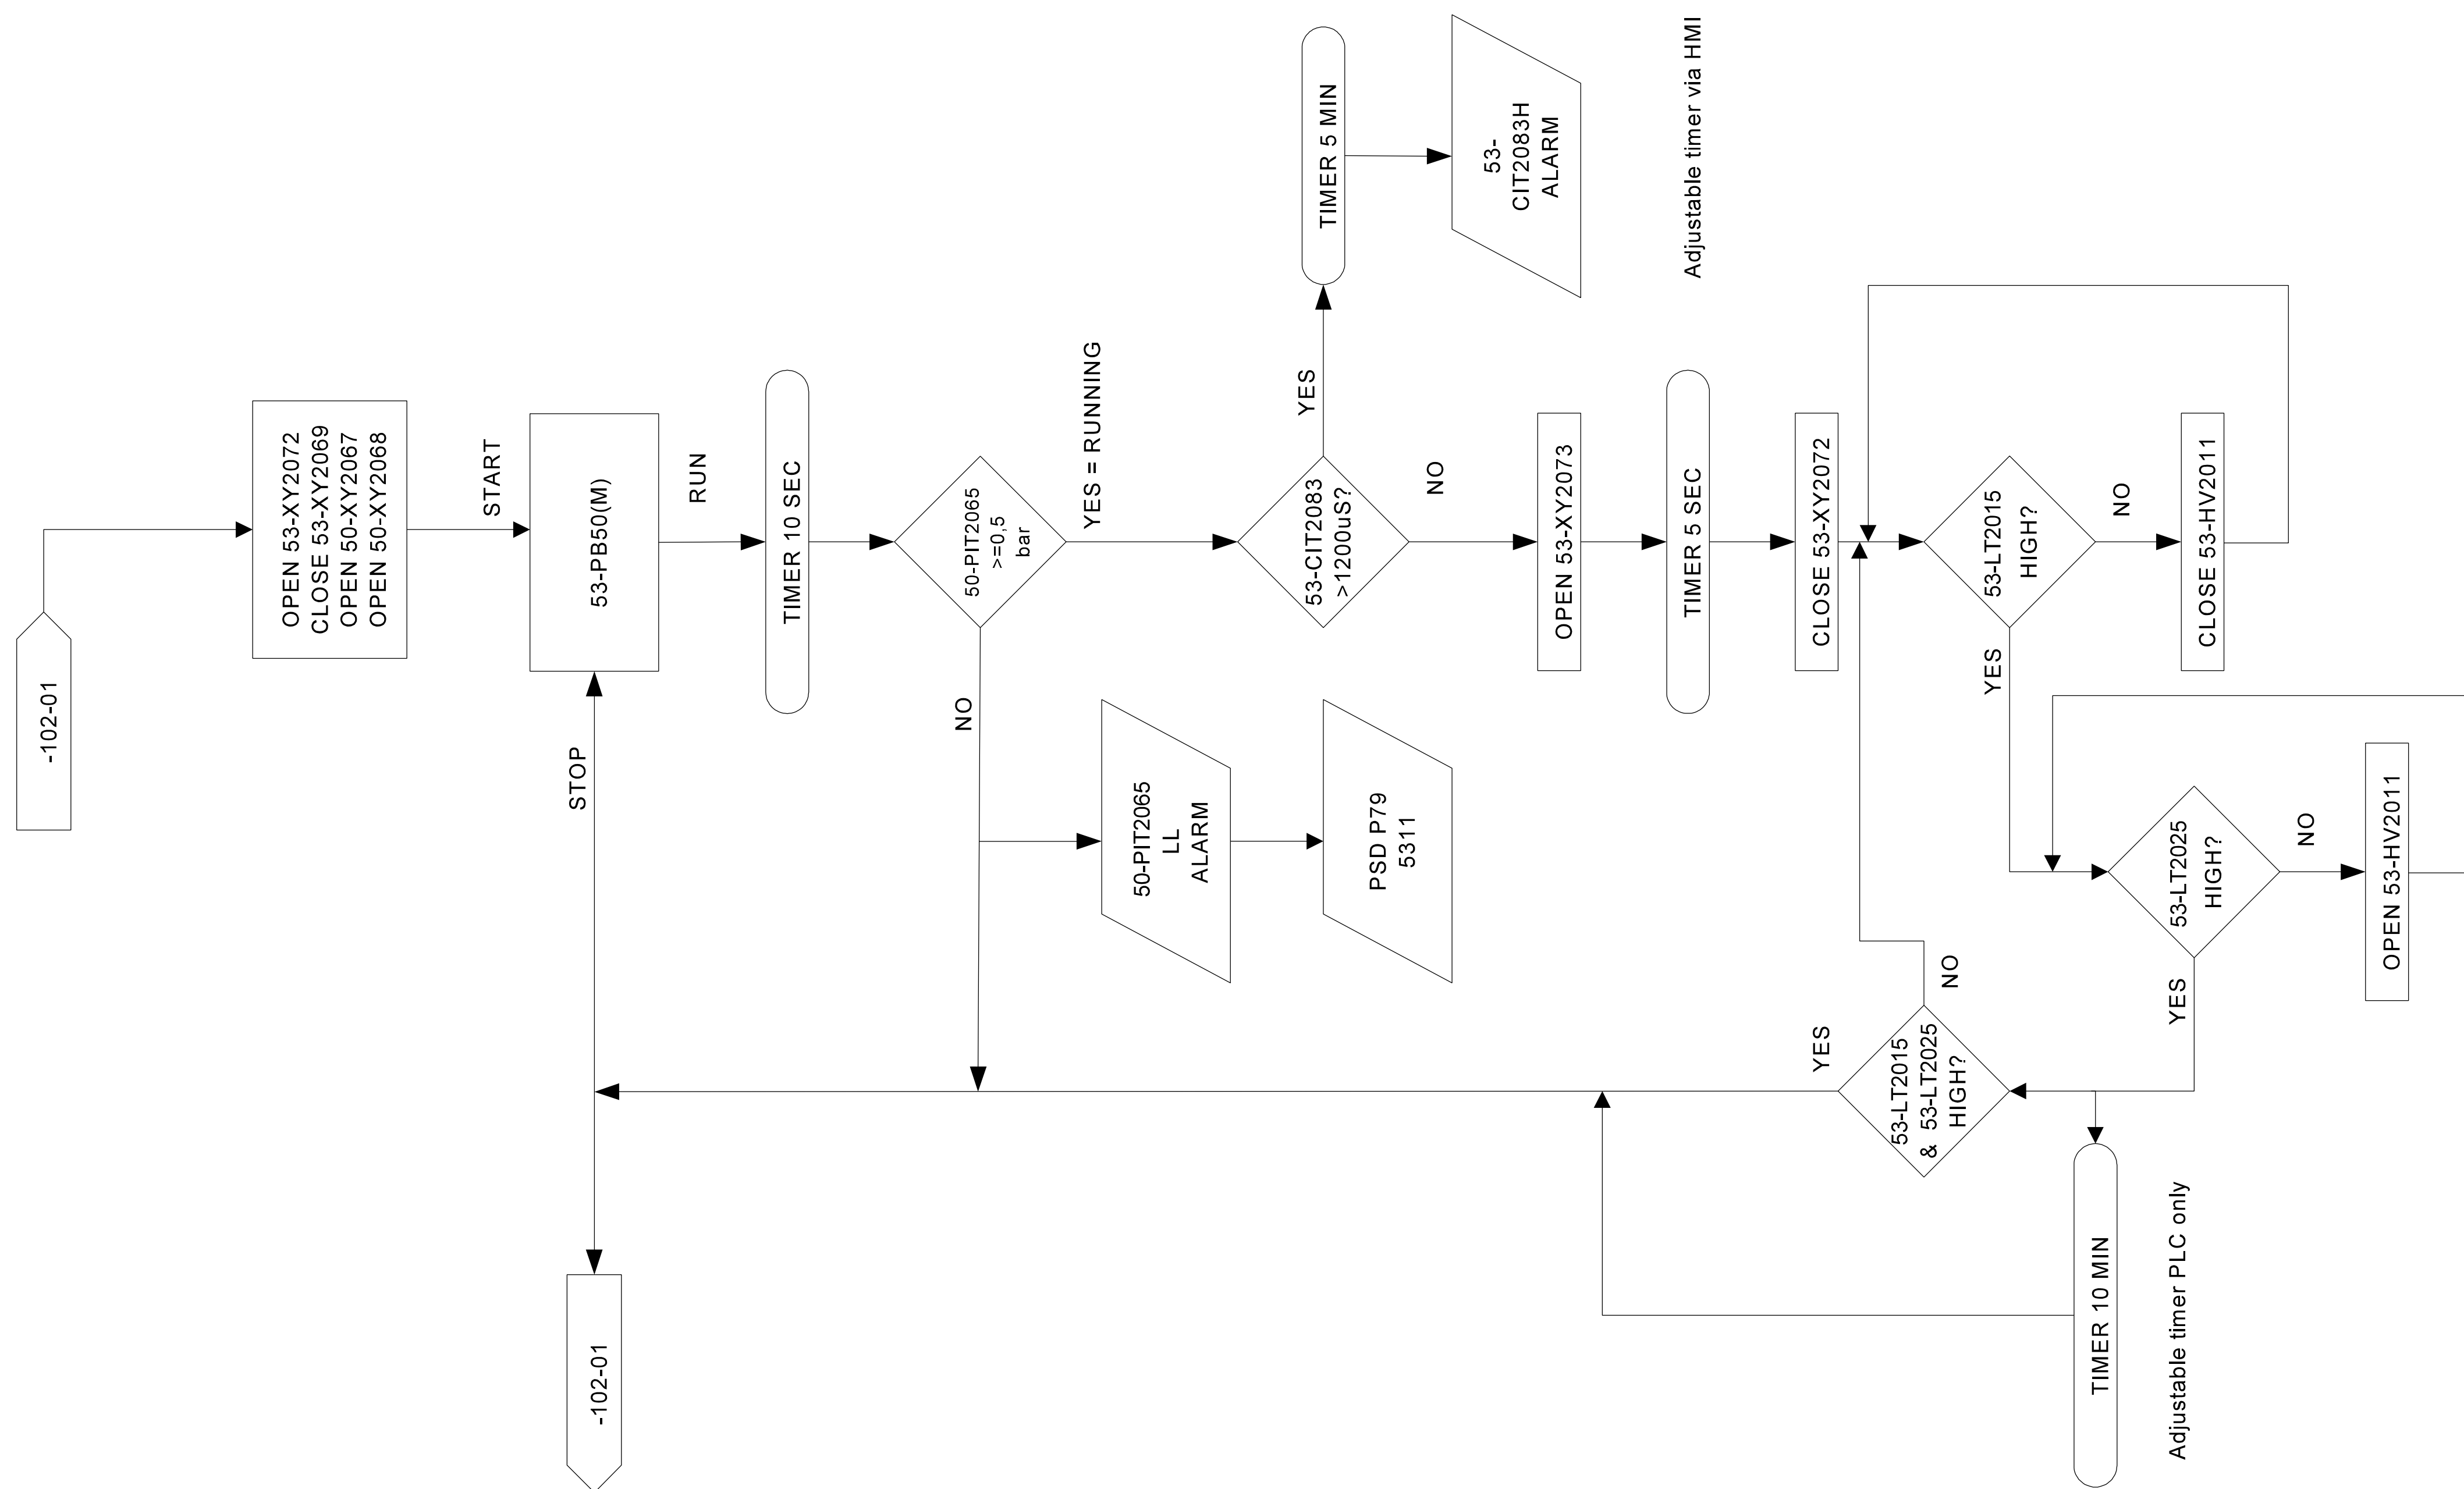

A1	25.05.2007	AS BUILT, HHP-PROJECT	AB	HB	AB		GS
03	16.03.2006	ISSUED FOR CONSTRUCTION	HB	MR	AB	GS	
02	03.03.2006	REISSUED FOR IDC	HB	MR	AB	GS	
01	30.01.2006	ISSUED FOR IDC	HB	MR	AB	GS	
Rev.	Date	Description	Made by	Disc. check	Disc. appr.	Contr. appr.	Comp. appr.
Acceptance Codes 1 ☐ IB ☐ 2A ☐ 2 ☐ 3 ☐ 4 ☐			Sign				
 STATOIL  vetco			Project : HULDRA HALEPRODUKSJON				

Drawing title : SYSTEM CONTROL DIAGRAM FRESH WATER PRODUCTION		
	N/A	
	Tag no.	
	SQL Code	NTS
	Scale	A1
P.O. No :	Projection	Dwg.Format
Siemens Doc. No :	53	53
Drawing No : C025-V-H053-J-WE-102-02	Area Code	Syst.Code
	1 of 1	A1
	Project install	Origin
	Seq.No.	
	Sheet	Rev.