


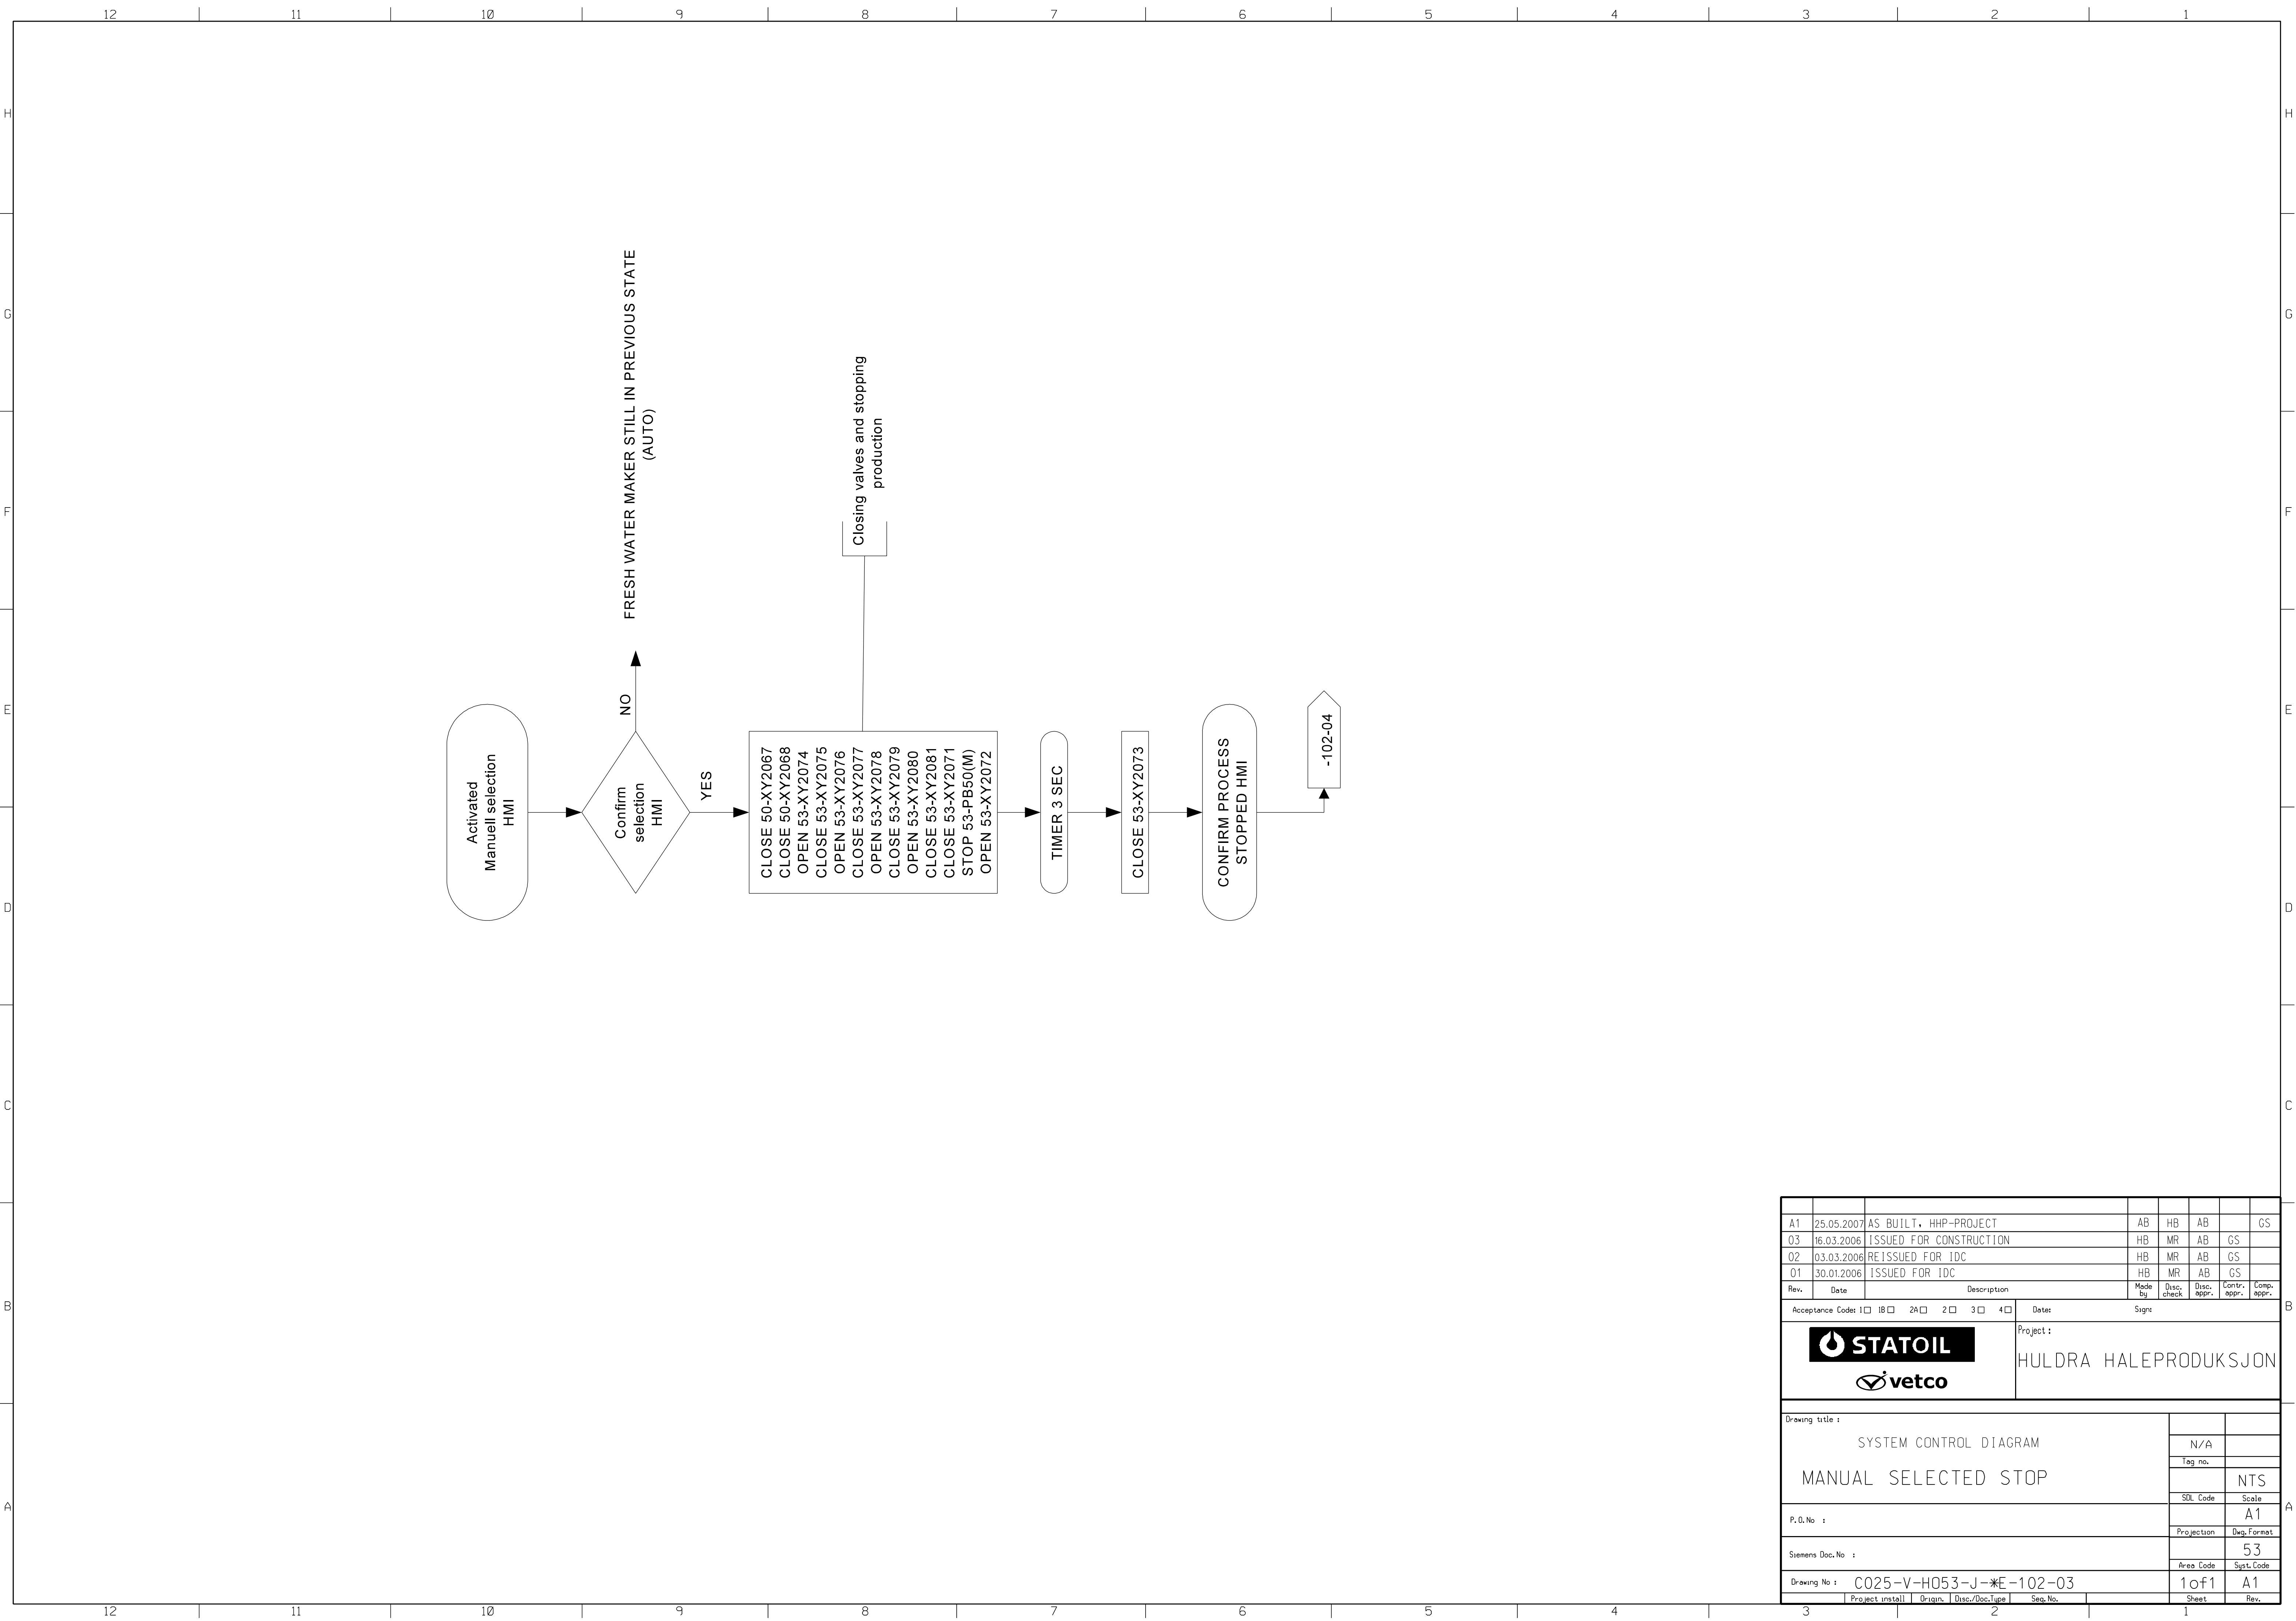

A1	25.05.2007	AS BUILT, HHP-PROJECT	AB	HB	AB			GS	
03	16.03.2006	ISSUED FOR CONSTRUCTION	HB	MR	AB	GS			
02	03.03.2006	REISSUED FOR IDC	HB	MR	AB	GS			
01	30.01.2006	ISSUED FOR IDC	HB	MR	AB	GS			
Rev.	Date	Description	Made by	Disc. check	Disc. appr.	Contr. appr.	Comp. appr.		
Acceptance Codes: 1 ☐ 1B ☐ 2A ☐ 2 ☐ 3 ☐ 4 ☐			Date: _____ Sign: _____						
 			Project : HULDRA HALEPRODUKSJON						
Drawing title : SYSTEM CONTROL DIAGRAM MANUAL SELECTED STOP									
						N/A			
						Tag no.			
						SOL Code	NTS		
P.O.No :						Scale	A1		
Siemens Doc.No :						Projection	Dwg.Format		
						Area Code	53		
						Syst.Code			
Drawing No : C025-V-H053-J-✱E-102-03						Sheet	1 of 1	A1	
			Project install	Origin.	Disc./Doc.Type	Seq.No.			
3	2	1	Sheet	Rev.					