


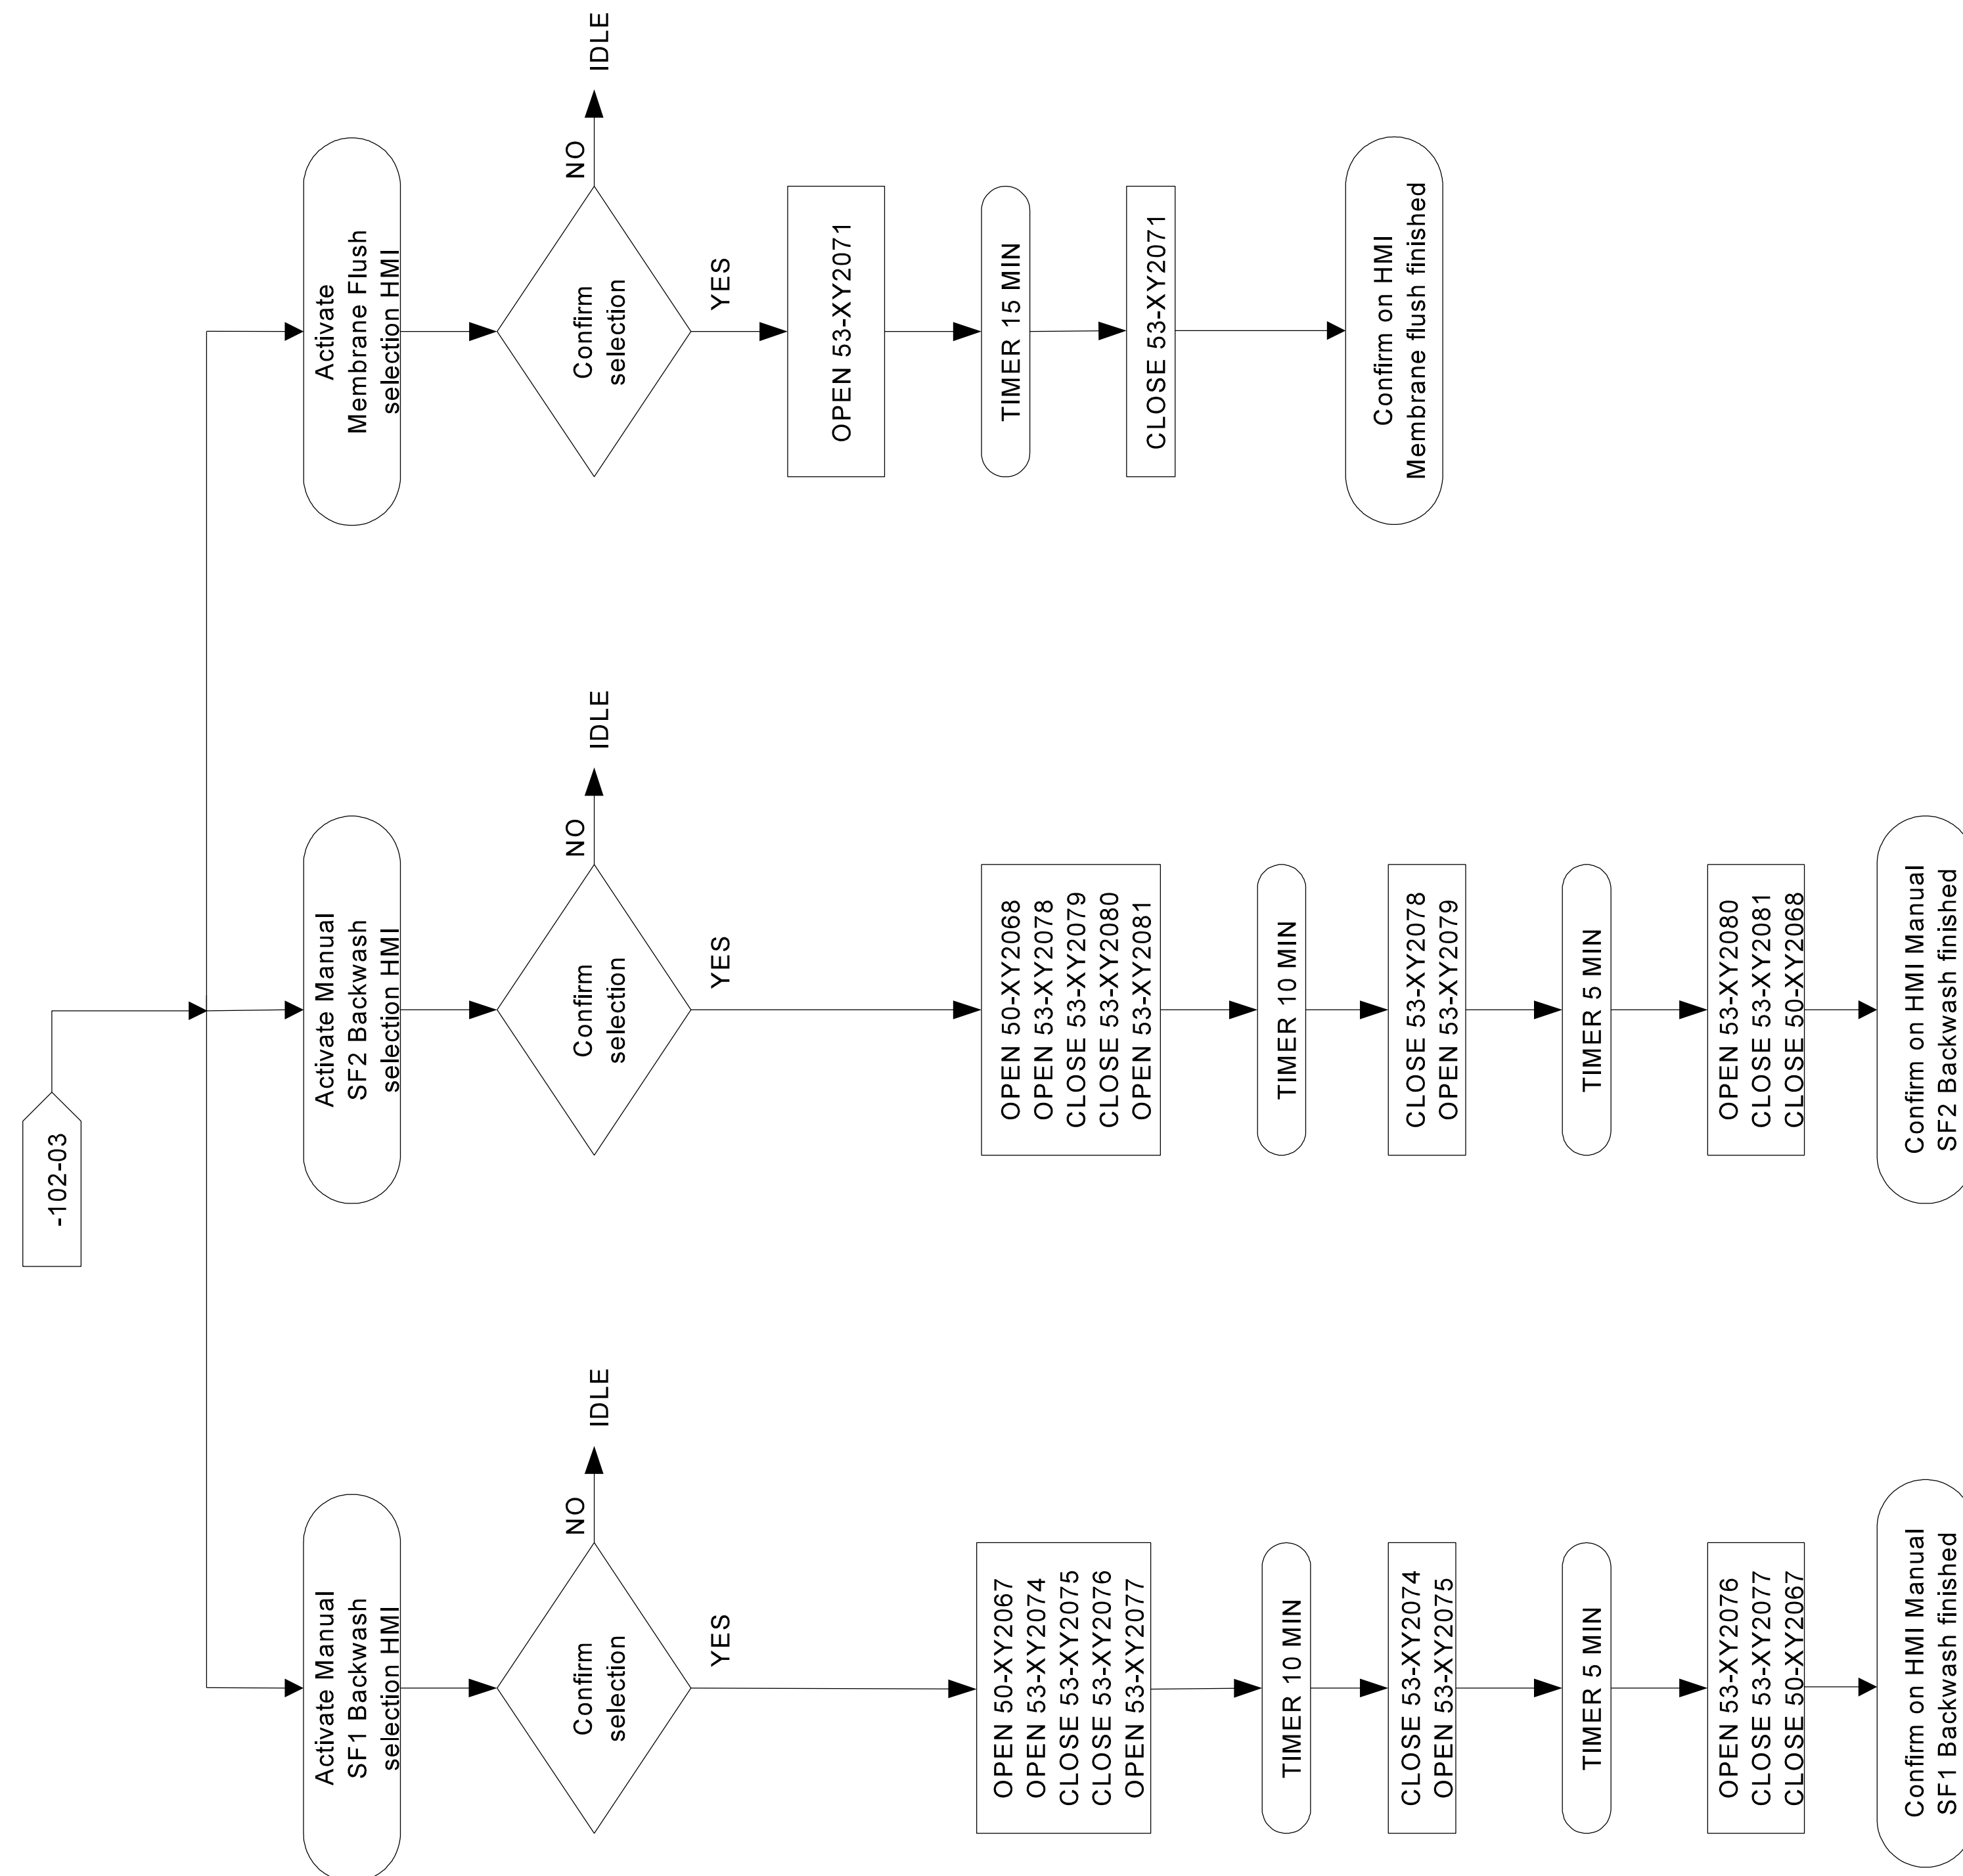

A1	25.05.2007	AS BUILT, HHP-PROJECT			AB	HB	AB	GS	GS
03	16.03.2006	ISSUED FOR CONSTRUCTION			HB	MR	AB	GS	
02	03.03.2006	REISSUED FOR IDC			HB	MR	AB	GS	
01	30.01.2006	ISSUED FOR IDC			HB	MR	AB	GS	
Rev.	Date	Description			Made by	Disc. check	Disc. appr.	Contr. appr.	Comp. appr.
Acceptance Code: 1 ☐ IB ☐ 2A ☐ 2 ☐ 3 ☐ 4 ☐					Sign:				
 STATOIL  vetco					Project : HULDRA HALEPRODUKSJON				

Drawing title : SYSTEM CONTROL DIAGRAM MANUAL SELECTED BACKWASH			
		N/A	
		Tag no.	
		NTS	
		SQL Code	Scale
P.O. No. :			A1
Siemens Doc.No. :		Projection	Dwg. Format
		53	
Drawing No. : C025-V-H053-J-✱-102-04		Area Code	Syst. Code
		1 of 1	A1
	Project install	Origin	Disc./Doc.Type
	Seq. No.		
	Sheet		Rev.