


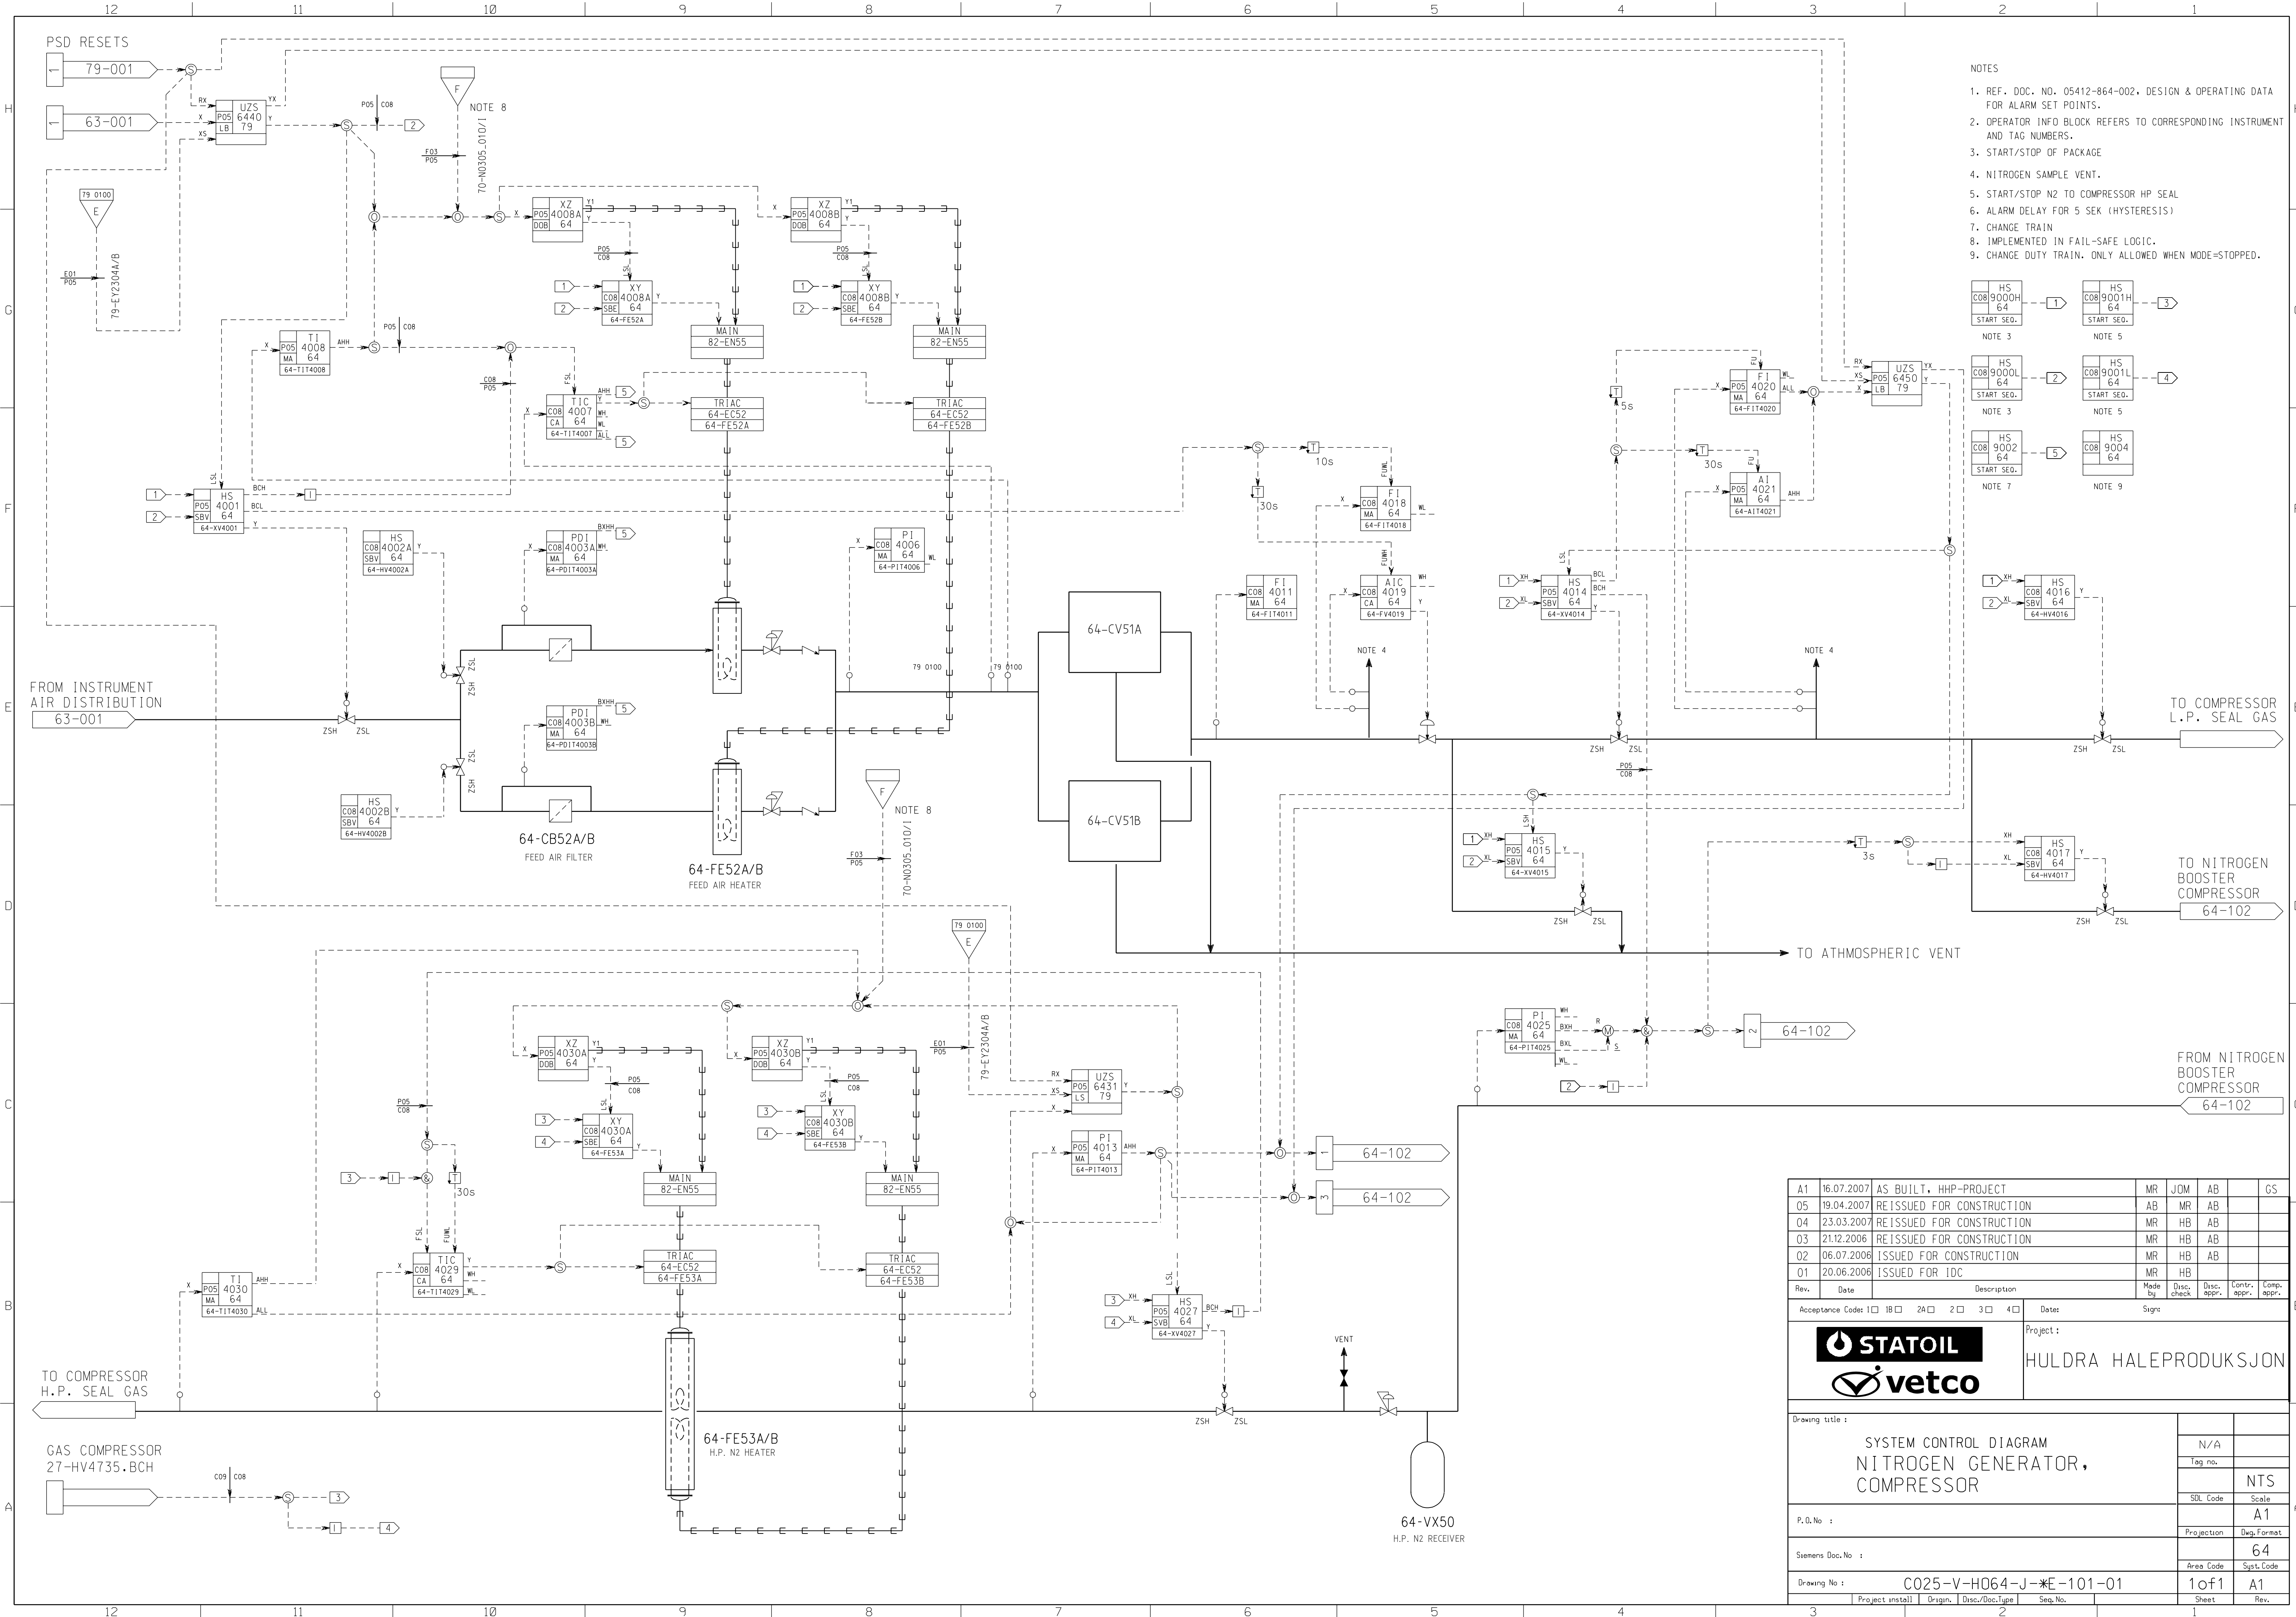

- NOTES
- 1. REF. DOC. NO. 05412-864-002, DESIGN & OPERATING DATA FOR ALARM SET POINTS.
 - 2. OPERATOR INFO BLOCK REFERS TO CORRESPONDING INSTRUMENT AND TAG NUMBERS.
 - 3. START/STOP OF PACKAGE
 - 4. NITROGEN SAMPLE VENT.
 - 5. START/STOP N2 TO COMPRESSOR HP SEAL
 - 6. ALARM DELAY FOR 5 SEK (HYSTERESIS)
 - 7. CHANGE TRAIN
 - 8. IMPLEMENTED IN FAIL-SAFE LOGIC.
 - 9. CHANGE DUTY TRAIN. ONLY ALLOWED WHEN MODE=STOPPED.

A1	16.07.2007	AS BUILT, HHP-PROJECT	MR	JOM	AB		GS
05	19.04.2007	REISSUED FOR CONSTRUCTION	AB	MR	AB		
04	23.03.2007	REISSUED FOR CONSTRUCTION	MR	HB	AB		
03	21.12.2006	REISSUED FOR CONSTRUCTION	MR	HB	AB		
02	06.07.2006	ISSUED FOR CONSTRUCTION	MR	HB	AB		
01	20.06.2006	ISSUED FOR IDC	MR	HB			
Rev.	Date	Description	Made by	Disc. check	Disc. appr.	Contr. appr.	Comp. appr.

Acceptance Codes 1 0 18 0 24 0 2 0 3 0 4 Dates: Sign:



Project :
HULDRA HALEPRODUKSJON

Drawing title :		N/A	
		Tag no.	
		NTS	
		Scale	
		A1	
P.O.No :	Projection	Dwg.Format	
		64	
Siemens Doc.No :	Area Code	Syst.Code	
Drawing No :	C025-V-H064-J-#E-101-01		
	Project install	Origins	Disc./Doc.Type
	Seq.No.		
	Sheet	Rev.	