


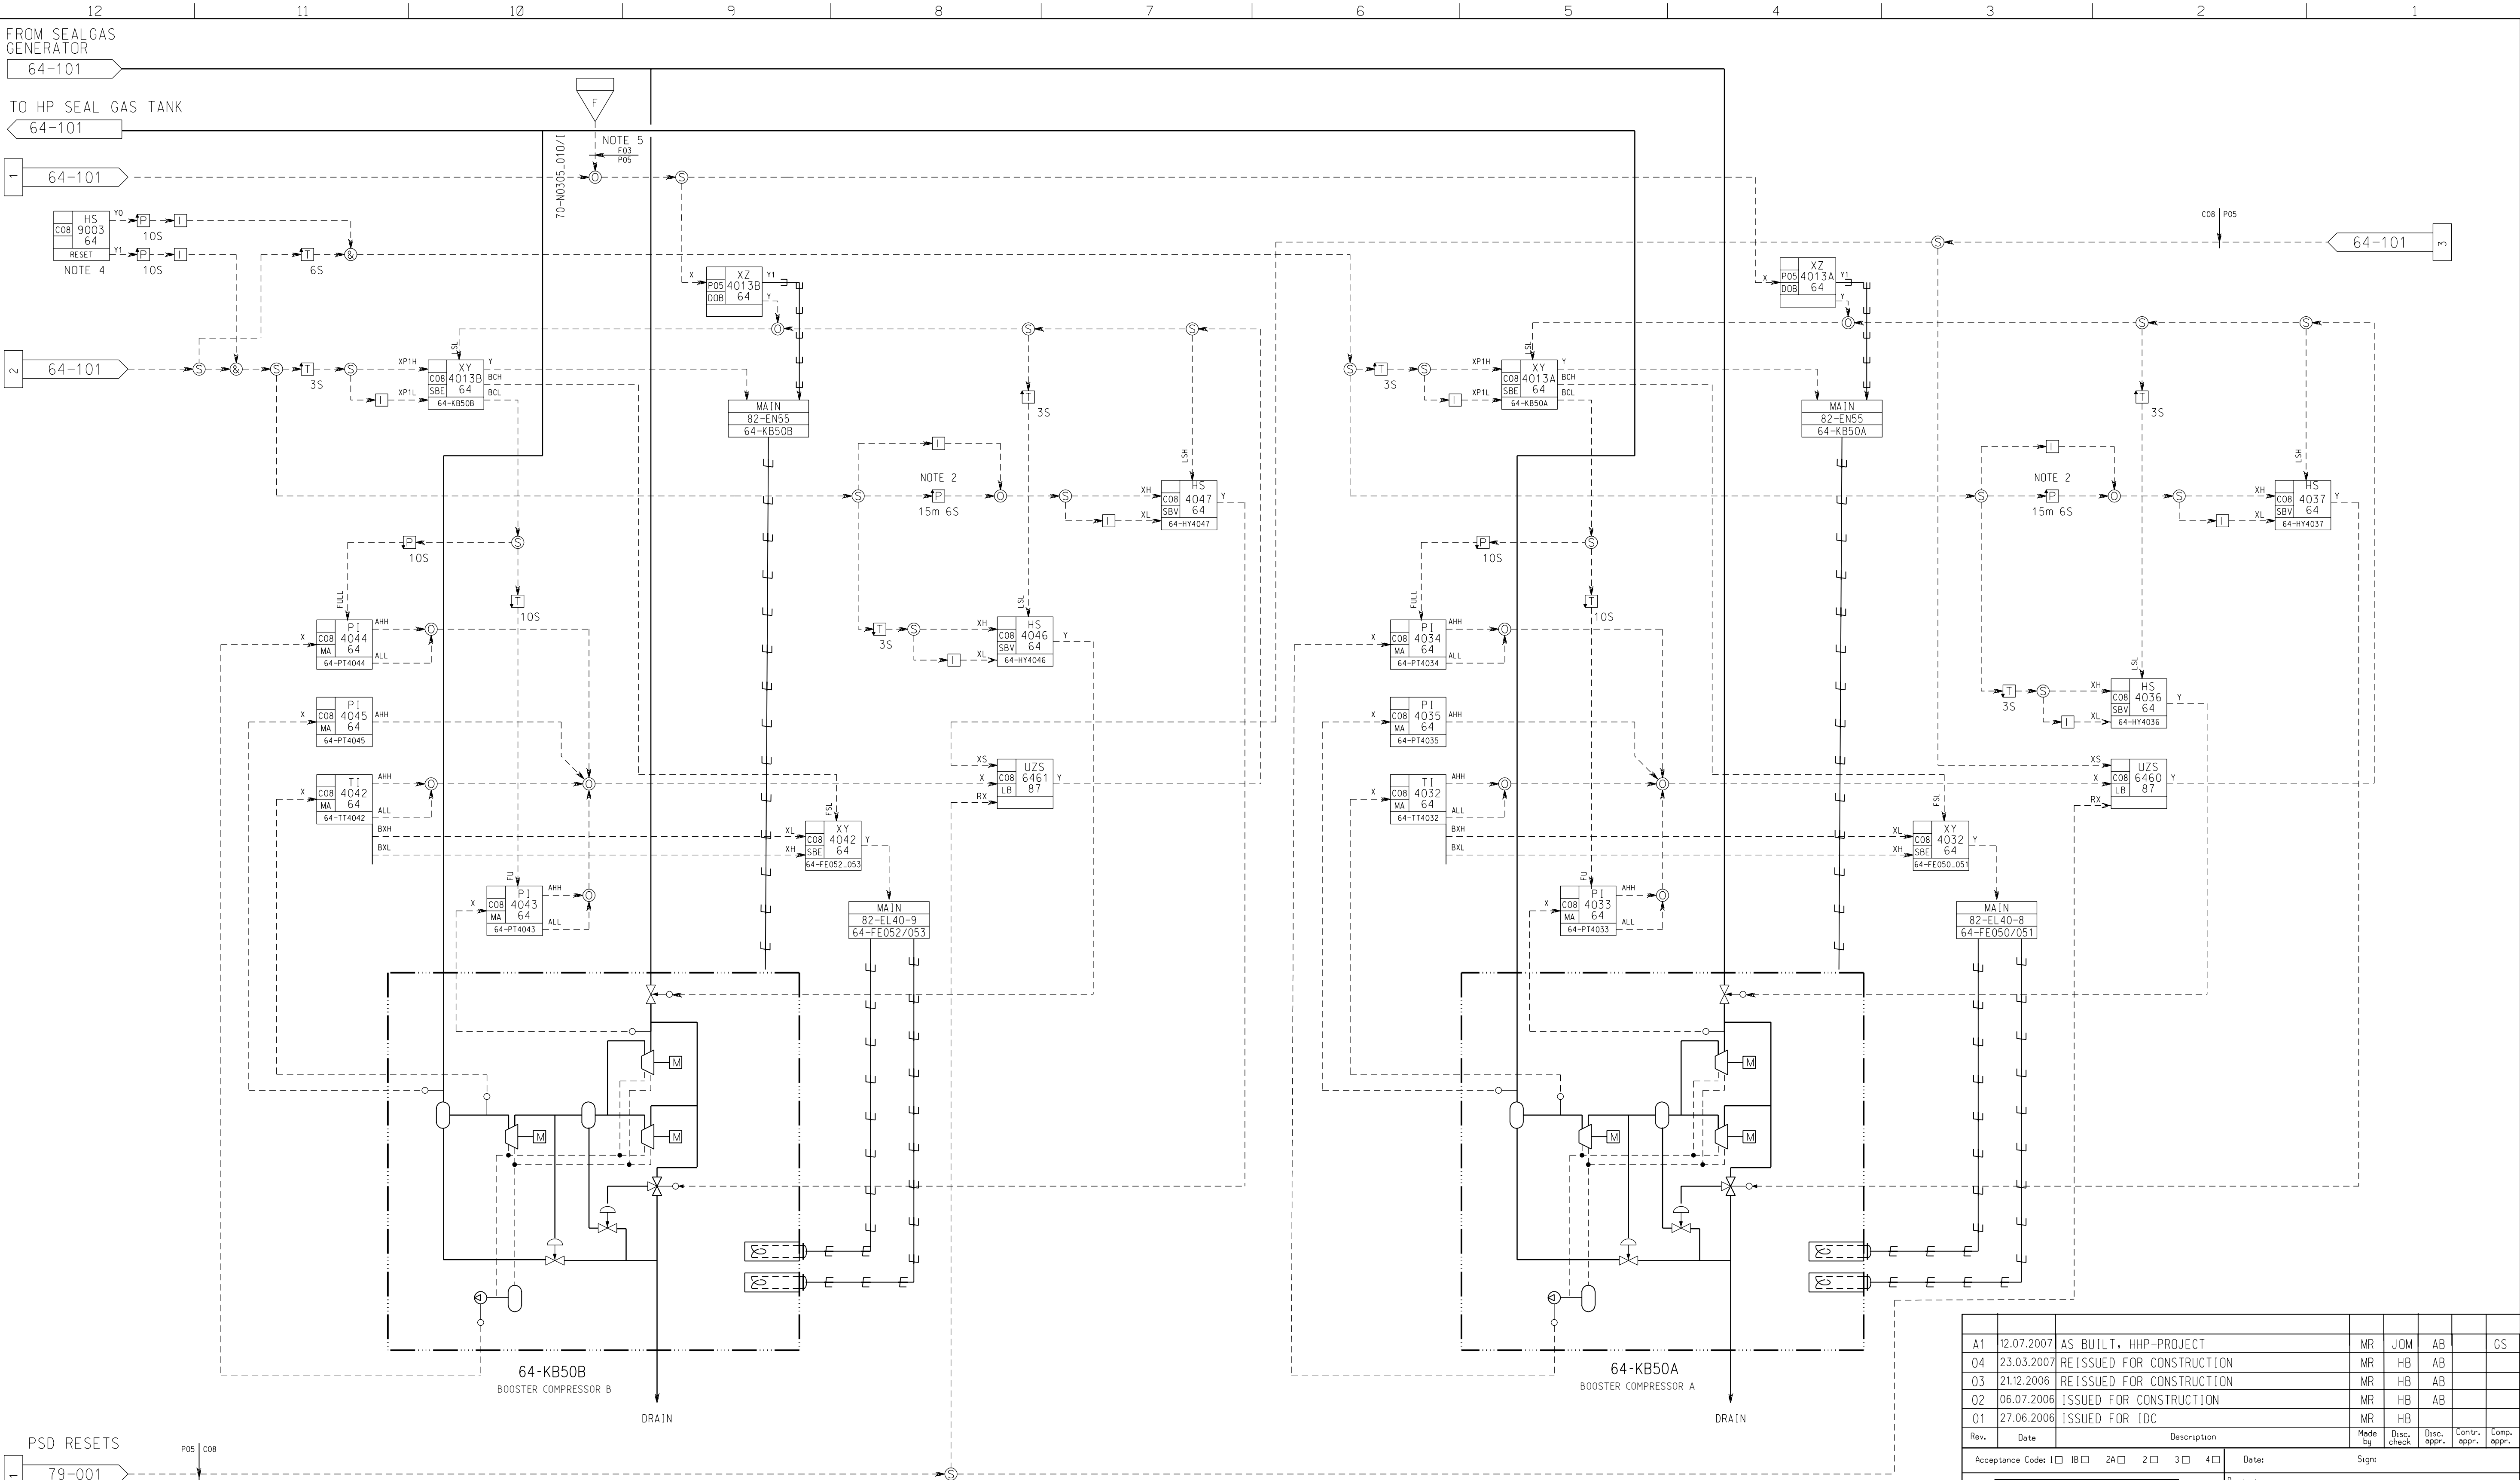

- NOTES
1. REF. DOC. NO. 05412-864-002, DESIGN & OPERATING DATA FOR ALARM SET POINTS.
 2. 6 SEC. PULSE ON POSITIVE EDGE, PLUS 6 SEC PULSE EVERY 15 M AFTER LAST PULSE.
 3. COMPRESSOR (CABINET) HEATER
 4. RESTART COMPRESSOR AFTER TRIP FROM 87-UZS6410/6411.
 5. IMPLEMENTED IN FAIL-SAFE LOGIC.

A1	12.07.2007	AS BUILT, HHP-PROJECT	MR	JOM	AB	GS
04	23.03.2007	REISSUED FOR CONSTRUCTION	MR	HB	AB	
03	21.12.2006	REISSUED FOR CONSTRUCTION	MR	HB	AB	
02	06.07.2006	ISSUED FOR CONSTRUCTION	MR	HB	AB	
01	27.06.2006	ISSUED FOR IDC	MR	HB		
Rev.	Date	Description	Made by	Disc. check	Disc. appr.	Contr. appr.
Acceptance Codes: 1 ☐ 1B ☐ 2A ☐ 2 ☐ 3 ☐ 4 ☐			Dates			
			Signe			
 			Project : HULDRA HALEPRODUKSJON			
Drawing title : SYSTEM CONTROL DIAGRAM NITROGEN GENERATOR, COMPRESSOR, HP BOOSTER COMPRESSOR			N/A		NTS	
			Tag no.			
			SDL Code		Scale	
					A1	
P. O. No. :			Projection		Dwg. Format	
					64	
Siemens Doc. No. :			Area Code		Syst. Code	
Drawing No. : C025-V-H064-J-#E-102-01			1 of 1		A1	
			Project install		Sheet	
			Origin.		Seq. No.	
					Rev.	