


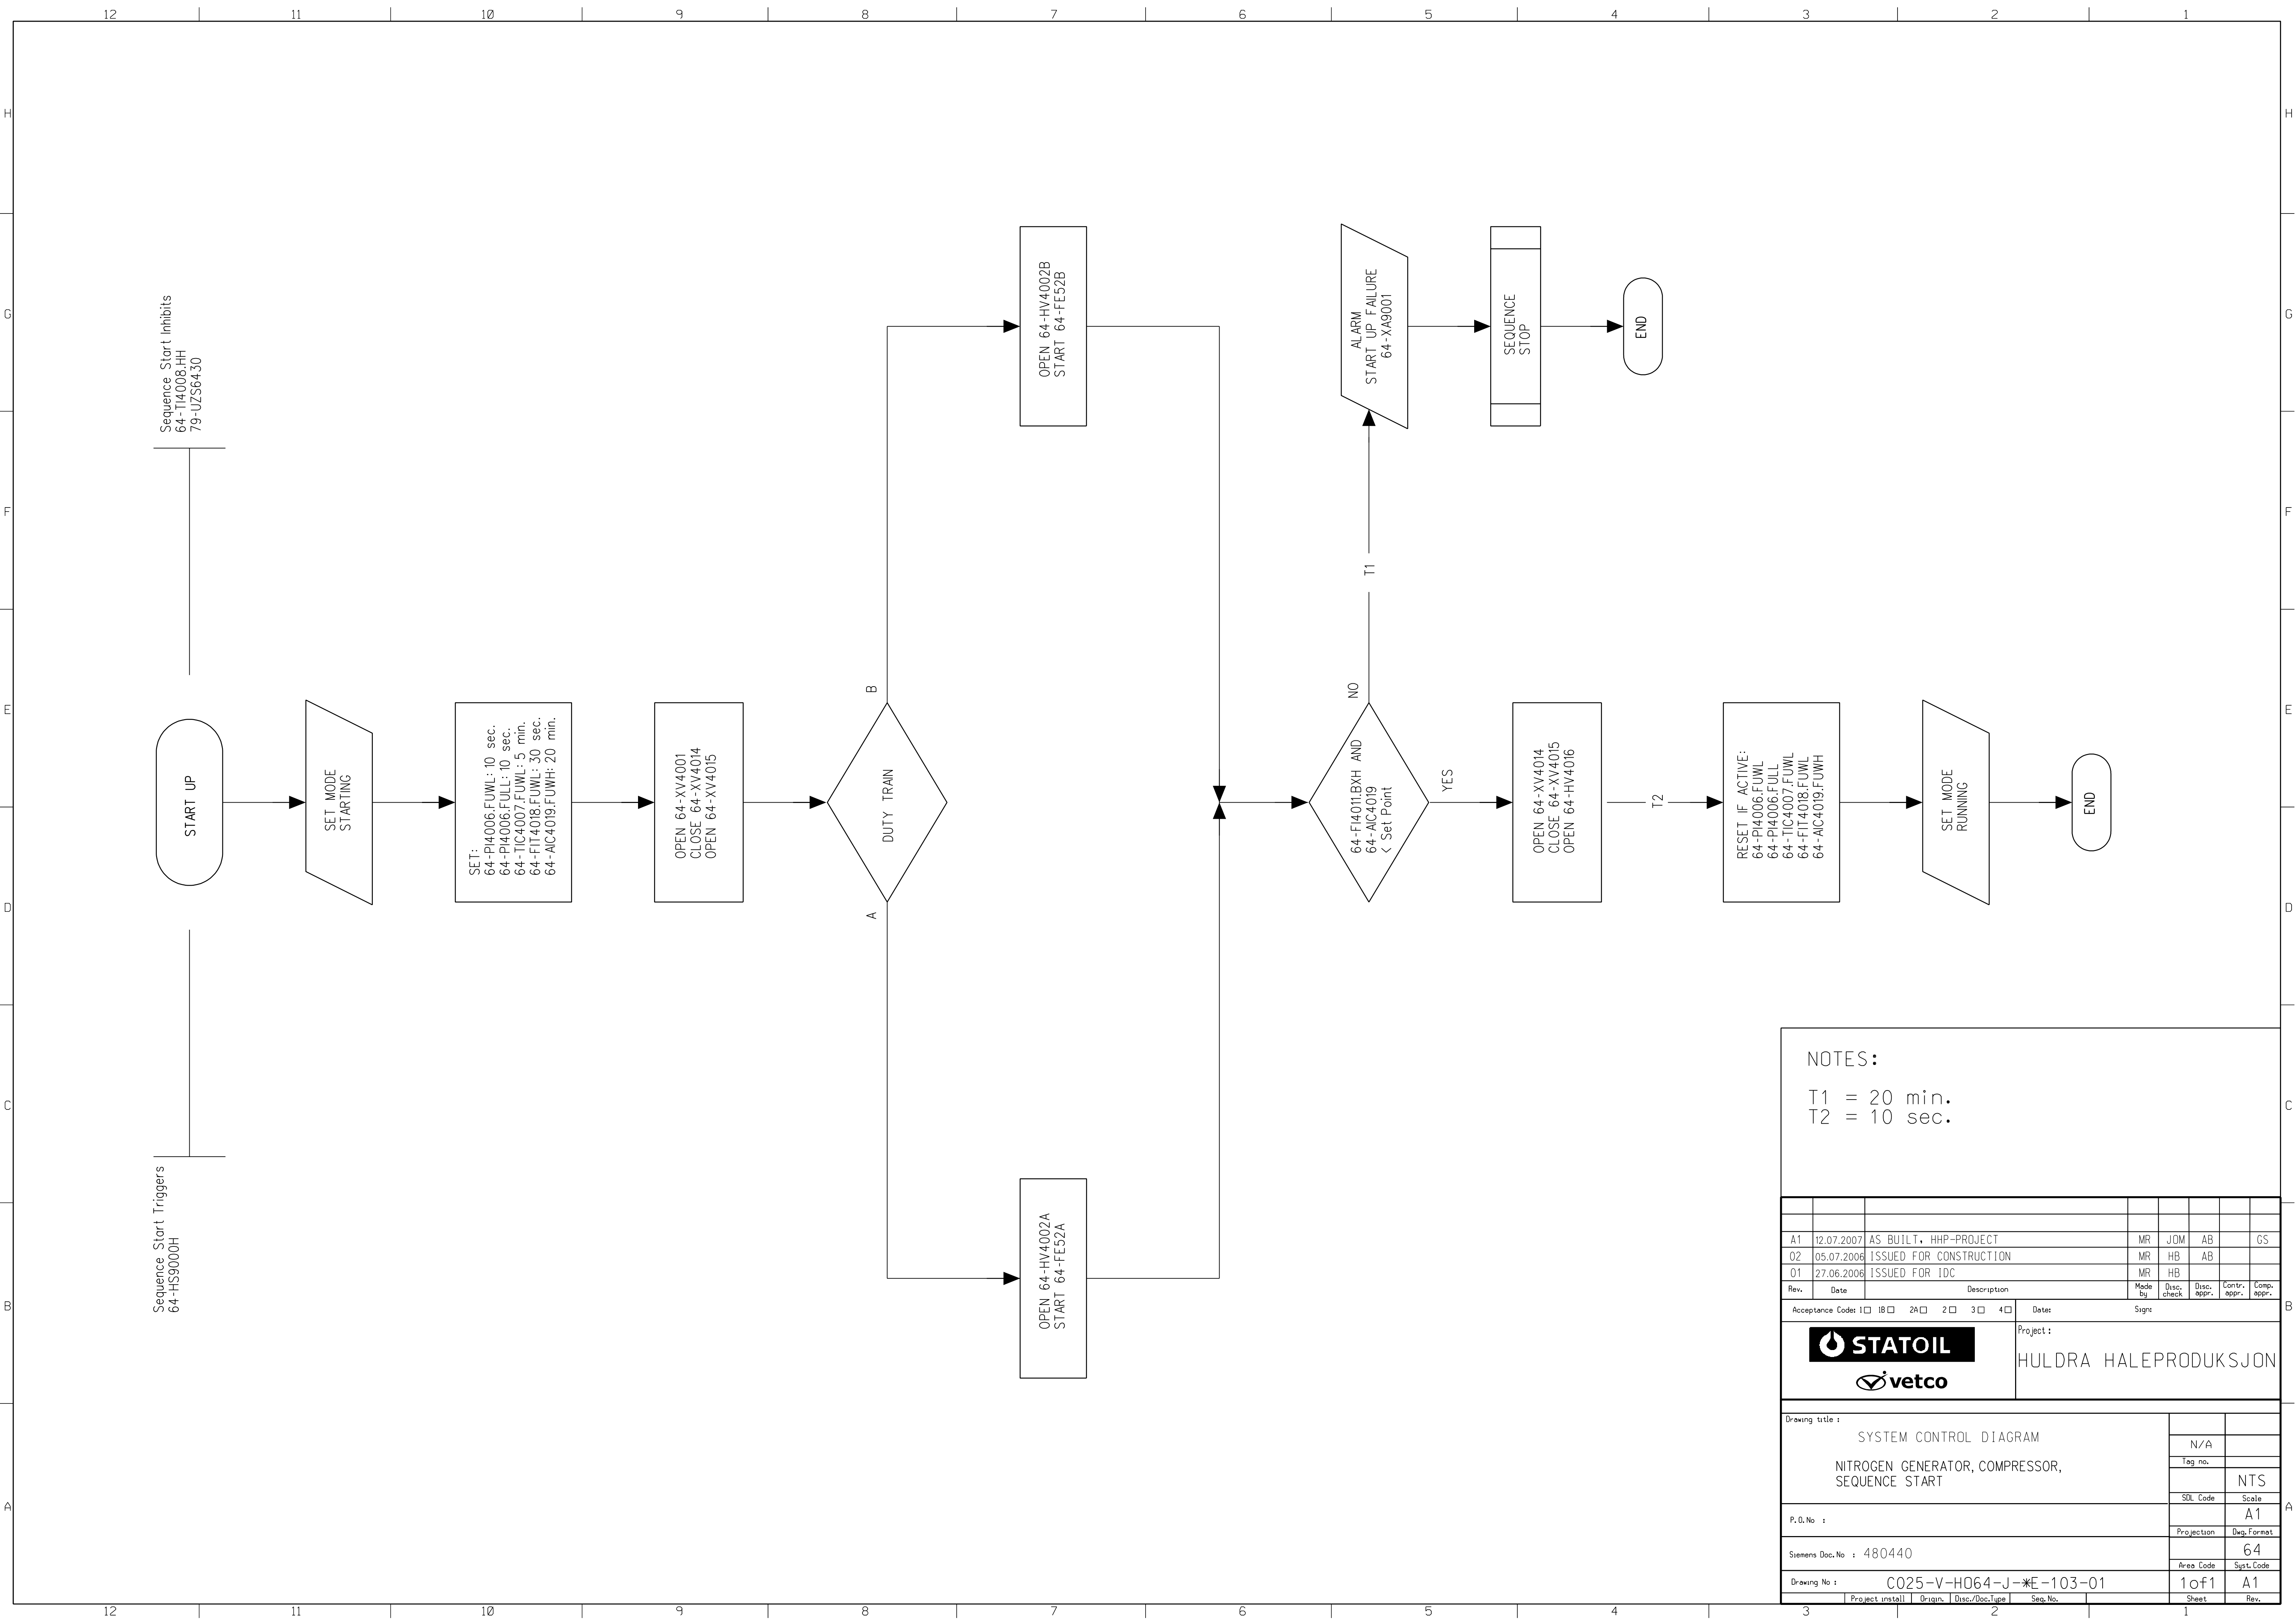

NOTES:

T1 = 20 min.
T2 = 10 sec.

A1	12.07.2007	AS BUILT. HHP-PROJECT	MR	JOM	AB			GS	
02	05.07.2006	ISSUED FOR CONSTRUCTION	MR	HB	AB				
01	27.06.2006	ISSUED FOR IDC	MR	HB					
Rev.	Date	Description	Made by	Disc. check	Disc. appr.	Contr. appr.	Comp. appr.		
Acceptance Codes: ☐ 1B ☐ 1B ☐ 2A ☐ 2 ☐ 3 ☐ 4 ☐			Signs						
			Project: HULDRA HALEPRODUKSJON						
									
Drawing title: SYSTEM CONTROL DIAGRAM									
NITROGEN GENERATOR, COMPRESSOR, SEQUENCE START								N/A	
								Tag no.	
								SOL Code	NTS
								Scale	A1
P.O.No :								Projection	Dwg.Format
									64
Siemens Doc.No : 480440								Area Code	Syst.Code
Drawing No : C025-V-H064-J-✱E-103-01								1 of 1	A1
Project install			Origin	Disc./Doc.Type	Seq.No.	Sheet	Rev.		