


Sequence Start Triggers
64-HS9000L
79-UZS6440

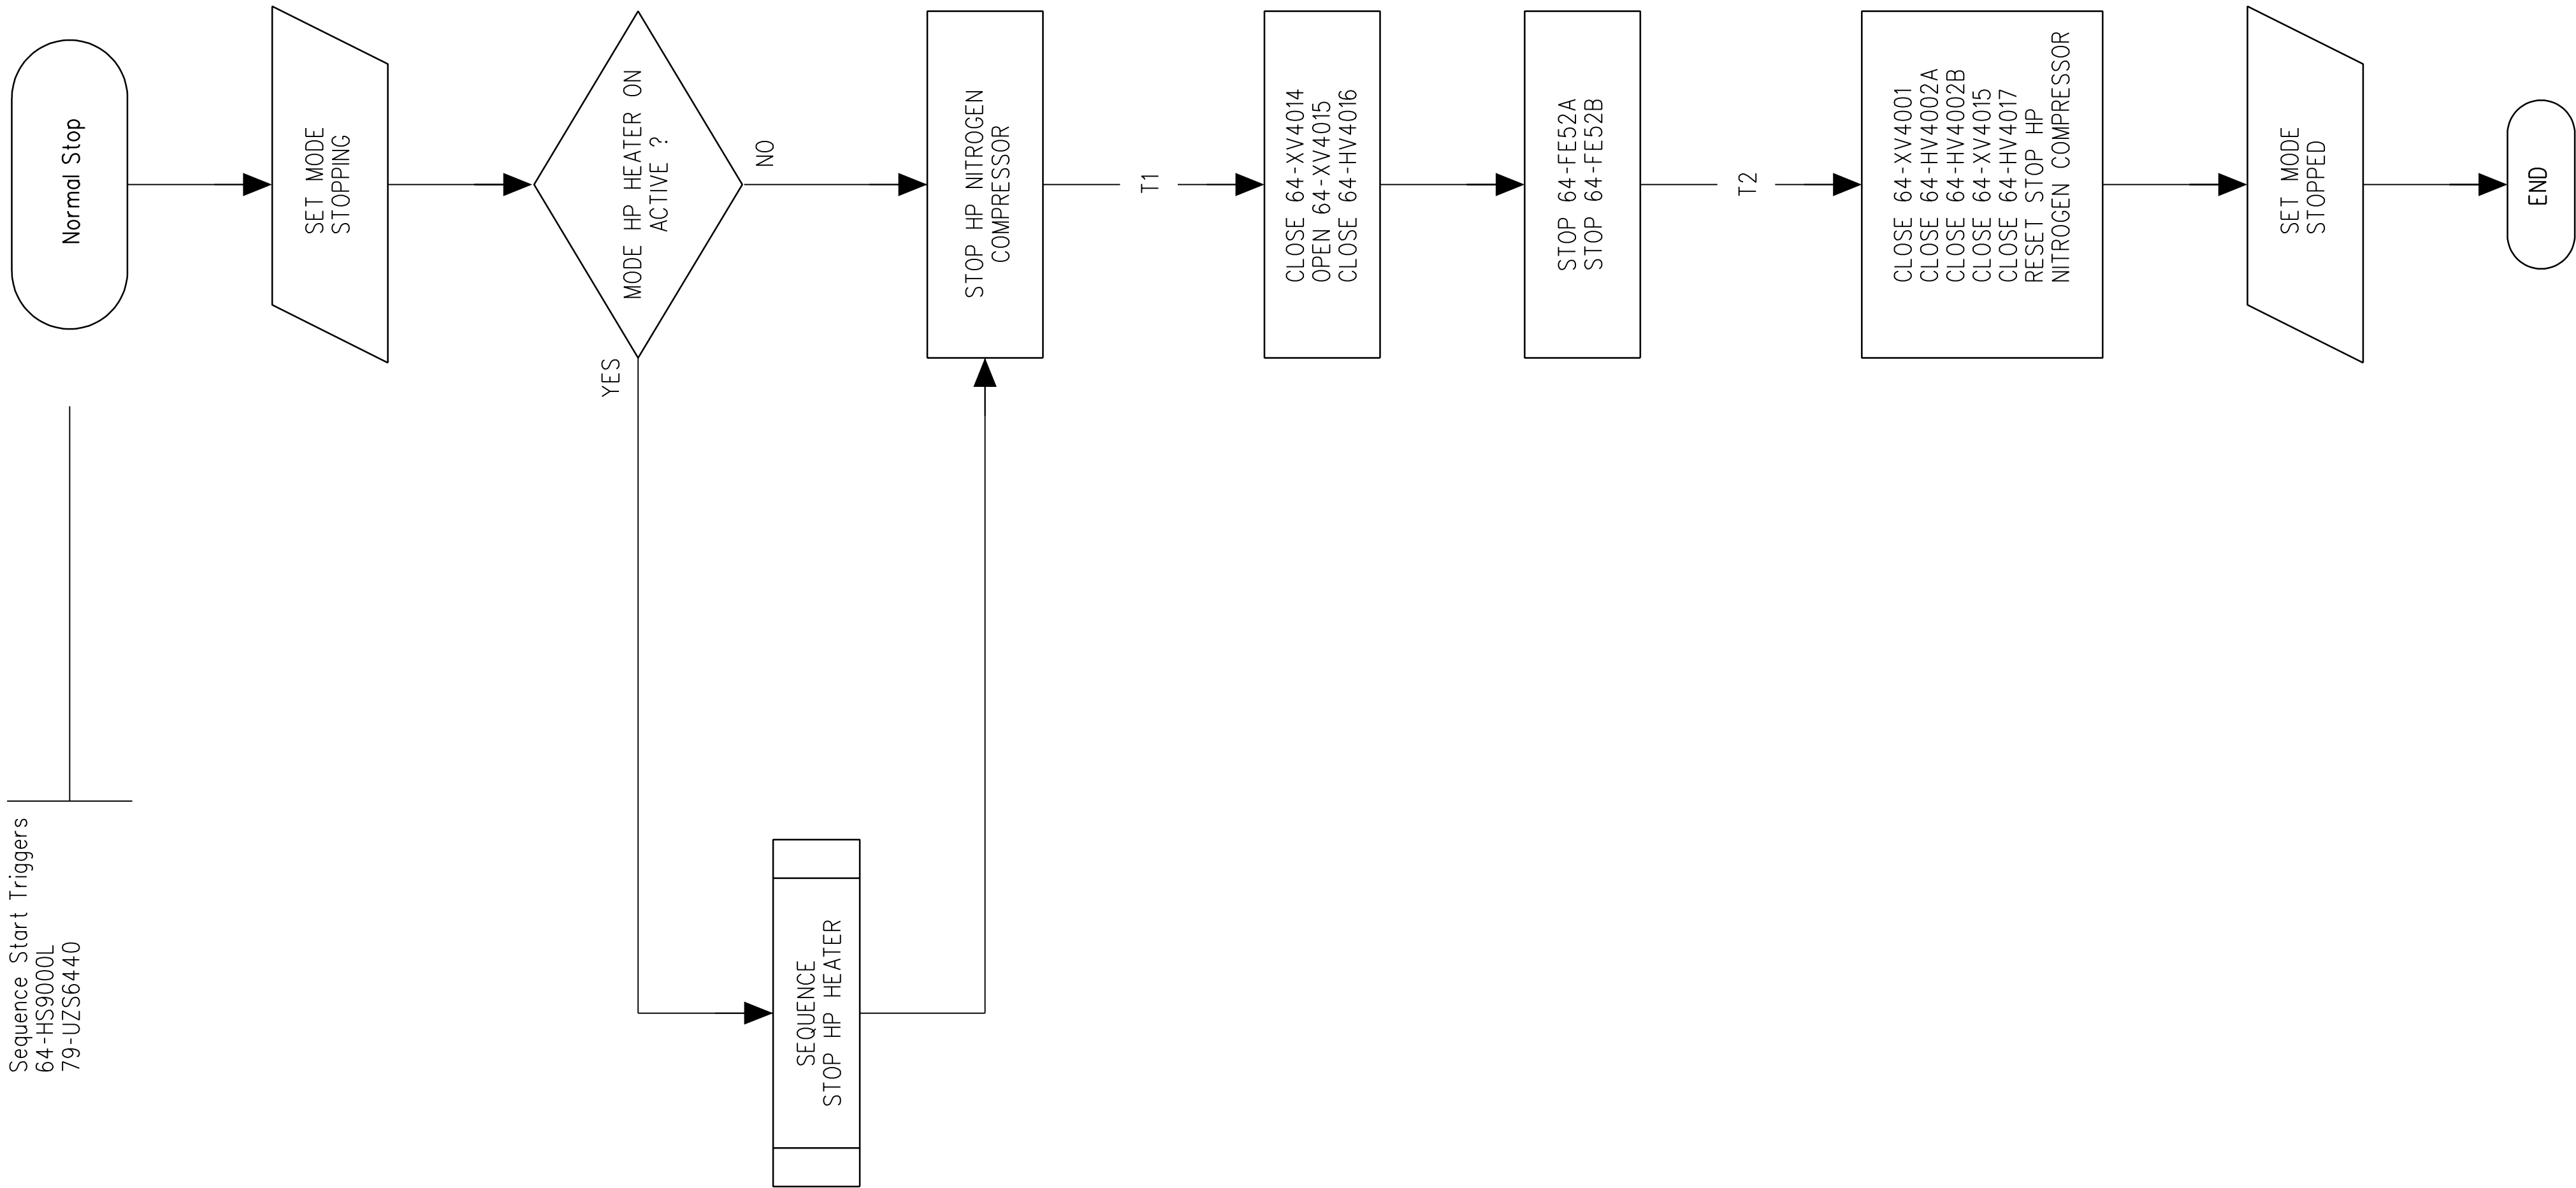

NOTES:

T1 = 10 sec.
T2 = 3 min.

A1	12.07.2007	AS BUILT, HHP-PROJECT				MR	JOM	AB	GS
02	05.07.2006	ISSUED FOR CONSTRUCTION				MR	HB	AB	
01	27.06.2006	ISSUED FOR IDC				MR	HB		
Rev.	Date	Description				Made by	Disc. check	Disc. appr.	Contr. appr.
Acceptance Codes: 1 ☐ 1B ☐ 2A ☐ 2 ☐ 3 ☐ 4 ☐						Date: _____ Sign: _____			
 						Project : _____			
						HULDRA HALEPRODUKSJON			
Drawing title : _____									
SYSTEM CONTROL DIAGRAM NITROGEN GENERATOR, COMPRESSOR, SEQUENCE STOP								N/A	
								Tag no.	
								SOL Code	NTS
								Scale	
P.O.No : _____								A1	
Siemens Doc.No : 480440								Projection	Dwg.Format
									64
Drawing No : C025-V-H064-J-✱E-103-02								Area Code	Syst.Code
								1 of 1	A1
Project install		Origin		Disc./Doc.Type		Seq.No.		Sheet	Rev.