


Sequence Start Triggers
64-HS0001L
64-PI4013.AHH
NOT 27-HV4735.BCH

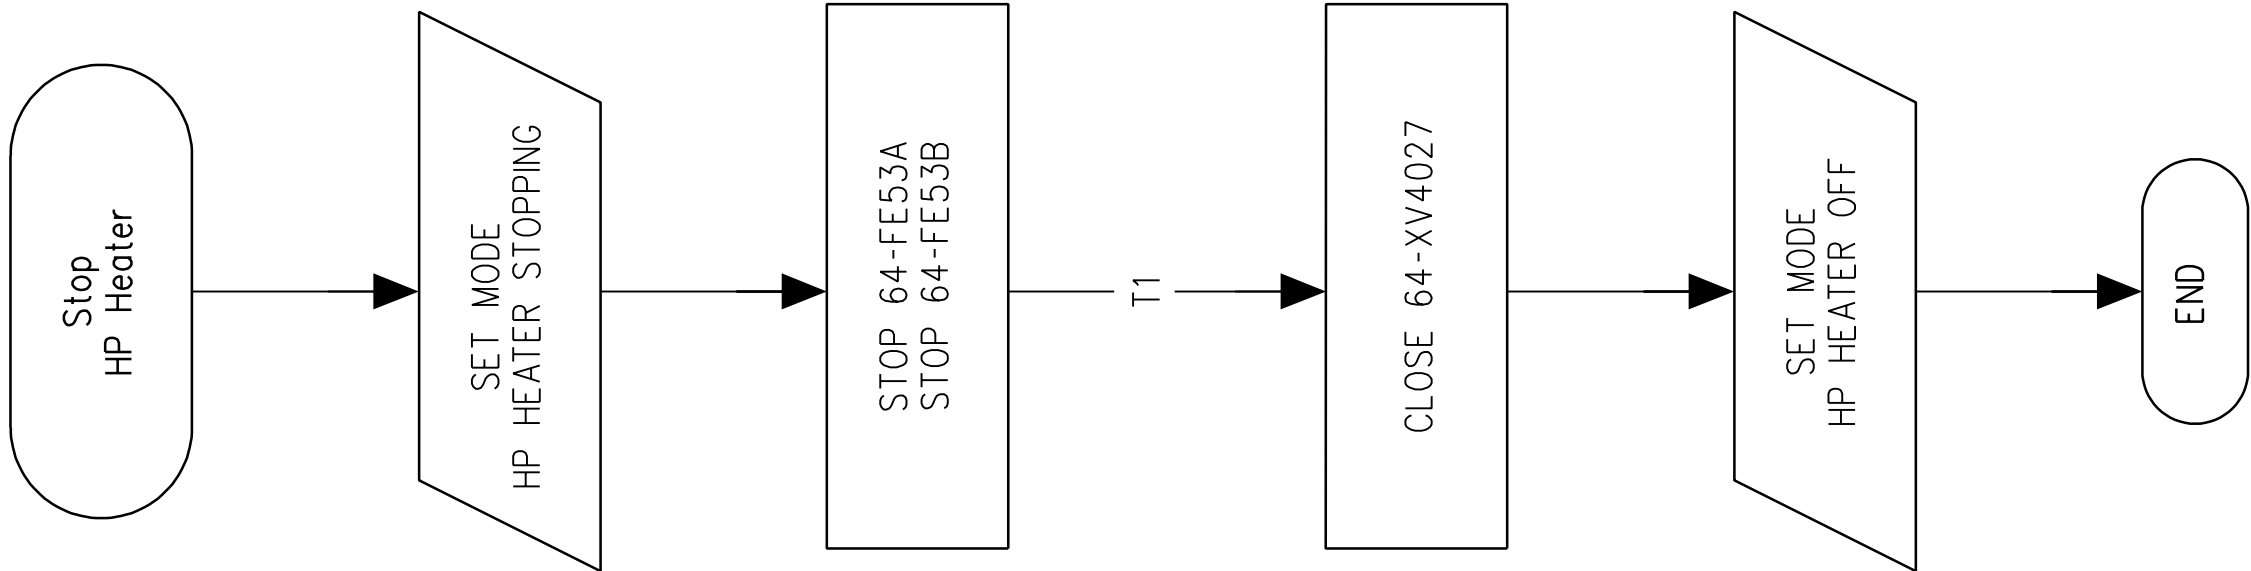

NOTES:

T1 = 10 sec.

A1	13.07.2007	AS BUILT, HHP-PROJECT					MR	JOM	AB		GS
02	05.07.2006	ISSUED FOR CONSTRUCTION					MR	HB	AB		
01	27.06.2006	ISSUED FOR IDC					MR	HB			
Rev.	Date	Description					Made by	Disc. check	Disc. appr.	Contr. appr.	Comp. appr.
Acceptance Codes: 1 ☐ 1B ☐ 2A ☐ 2 ☐ 3 ☐ 4 ☐							Date: _____ Sign: _____				
 							Project : HULDRA HALEPRODUKSJON				
Drawing title : SYSTEM CONTROL DIAGRAM NITROGEN GENERATOR, COMPRESSOR, SEQUENCE STOP HP HEATER											
P.O.No : Siemens Doc.No : 480440									N/A		
									Tag no.		
									SOL Code		NTS
									Scale		A1
Drawing No : C025-V-H064-J- M E-103-04									Projection		Dwg.Format
									Area Code		Syst.Code
									1 of 1		A1
Project install			Origin		Disc./Doc.Type		Seq.No.		Sheet		Rev.