


Sequence Start Triggers
64-HS9002
64-PDI4003A.AHH
64-PDI4003B.AHH
64-TIC4007.ALL
64-TIC4007.AHH
64-XY4008A.YF
64-XY4008B.YF

Sequence Start Inhibits
Mode Running

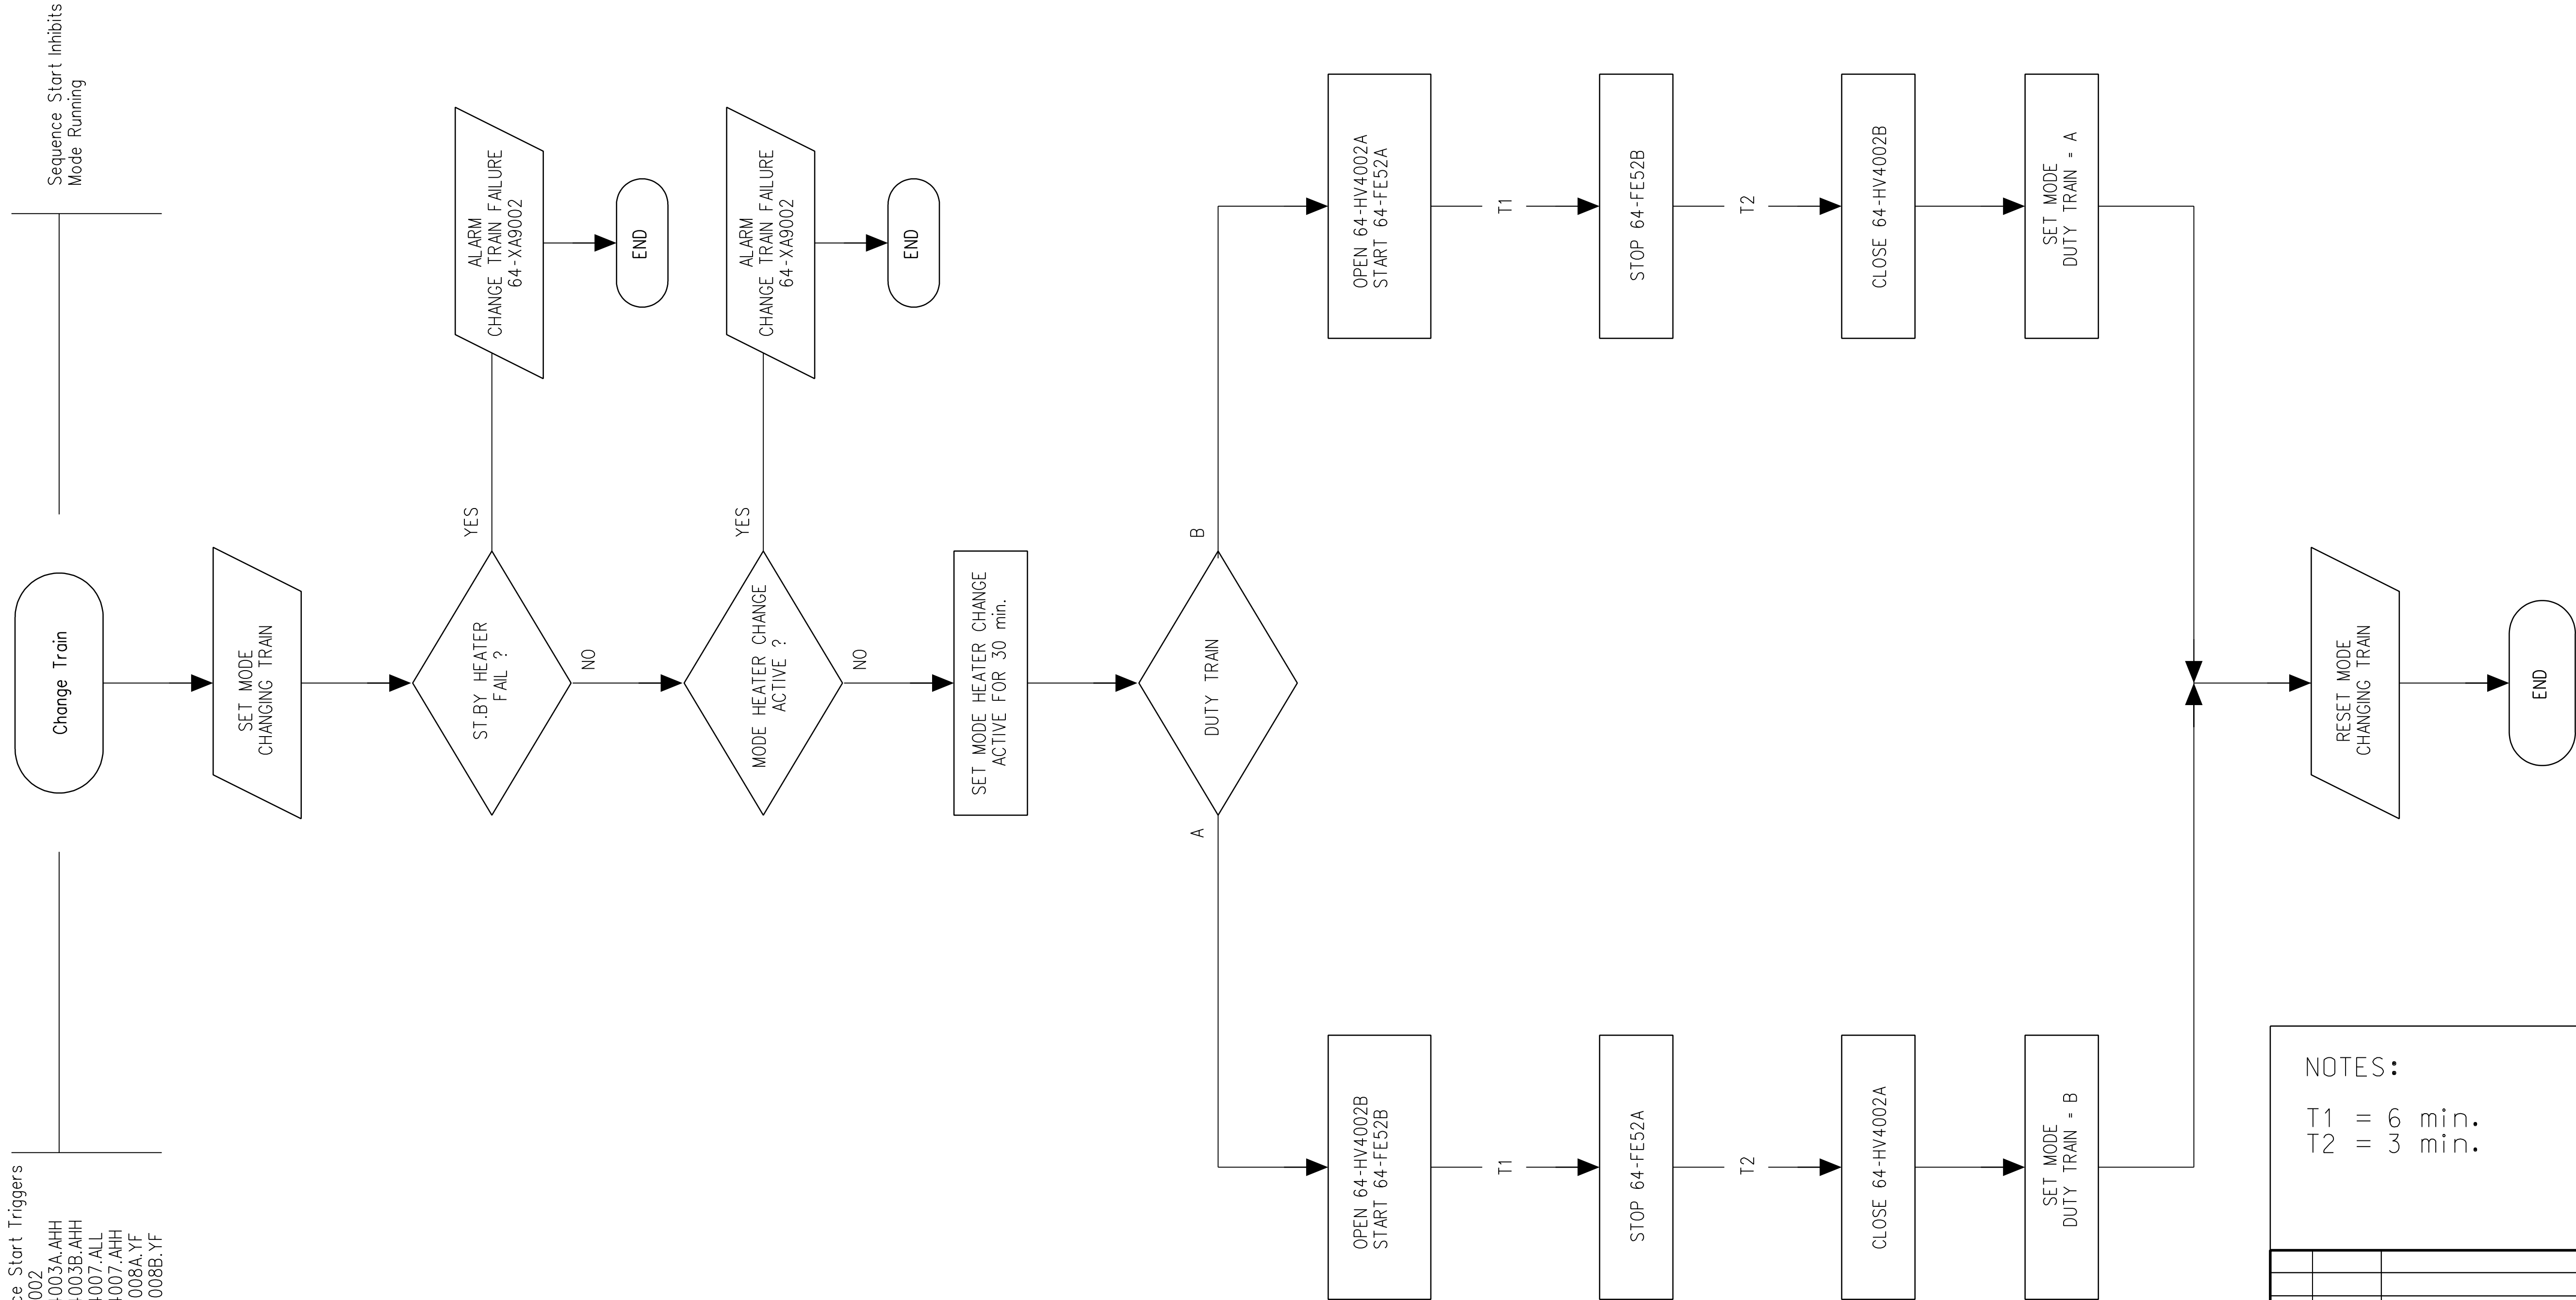

NOTES:
T1 = 6 min.
T2 = 3 min.

A1	12.07.2007	AS BUILT, HHP-PROJECT						MR	JOM	AB		GS	
02	05.07.2006	ISSUED FOR CONSTRUCTION						MR	HB	AB			
01	27.06.2006	ISSUED FOR IDC						MR	HB				
Rev.	Date	Description						Made by	Disc. check	Disc. appr.	Contr. appr.	Comp. appr.	
Acceptance Codes: 1 ☐ 1B ☐ 2A ☐ 2 ☐ 3 ☐ 4 ☐							Dates						Signs
 							Project : HULDRA HALEPRODUKSJON						
Drawing title : SYSTEM CONTROL DIAGRAM NITROGEN GENERATOR, COMPRESSOR, SEQUENCE CHANGE TRAIN													
P.O.No :							N/A						
							Tag no.						
							SOL Code		NTS				
Siemens Doc.No : 480440							A1						
							Projection		Dwg.Format				
Drawing No : C025-V-H064-J-✱E-103-05							64						
							Area Code		Syst.Code				
							1 of 1		A1				
		Project install		Origins		Disc./Doc.Type		Seq.No.		Sheet		Rev.	