


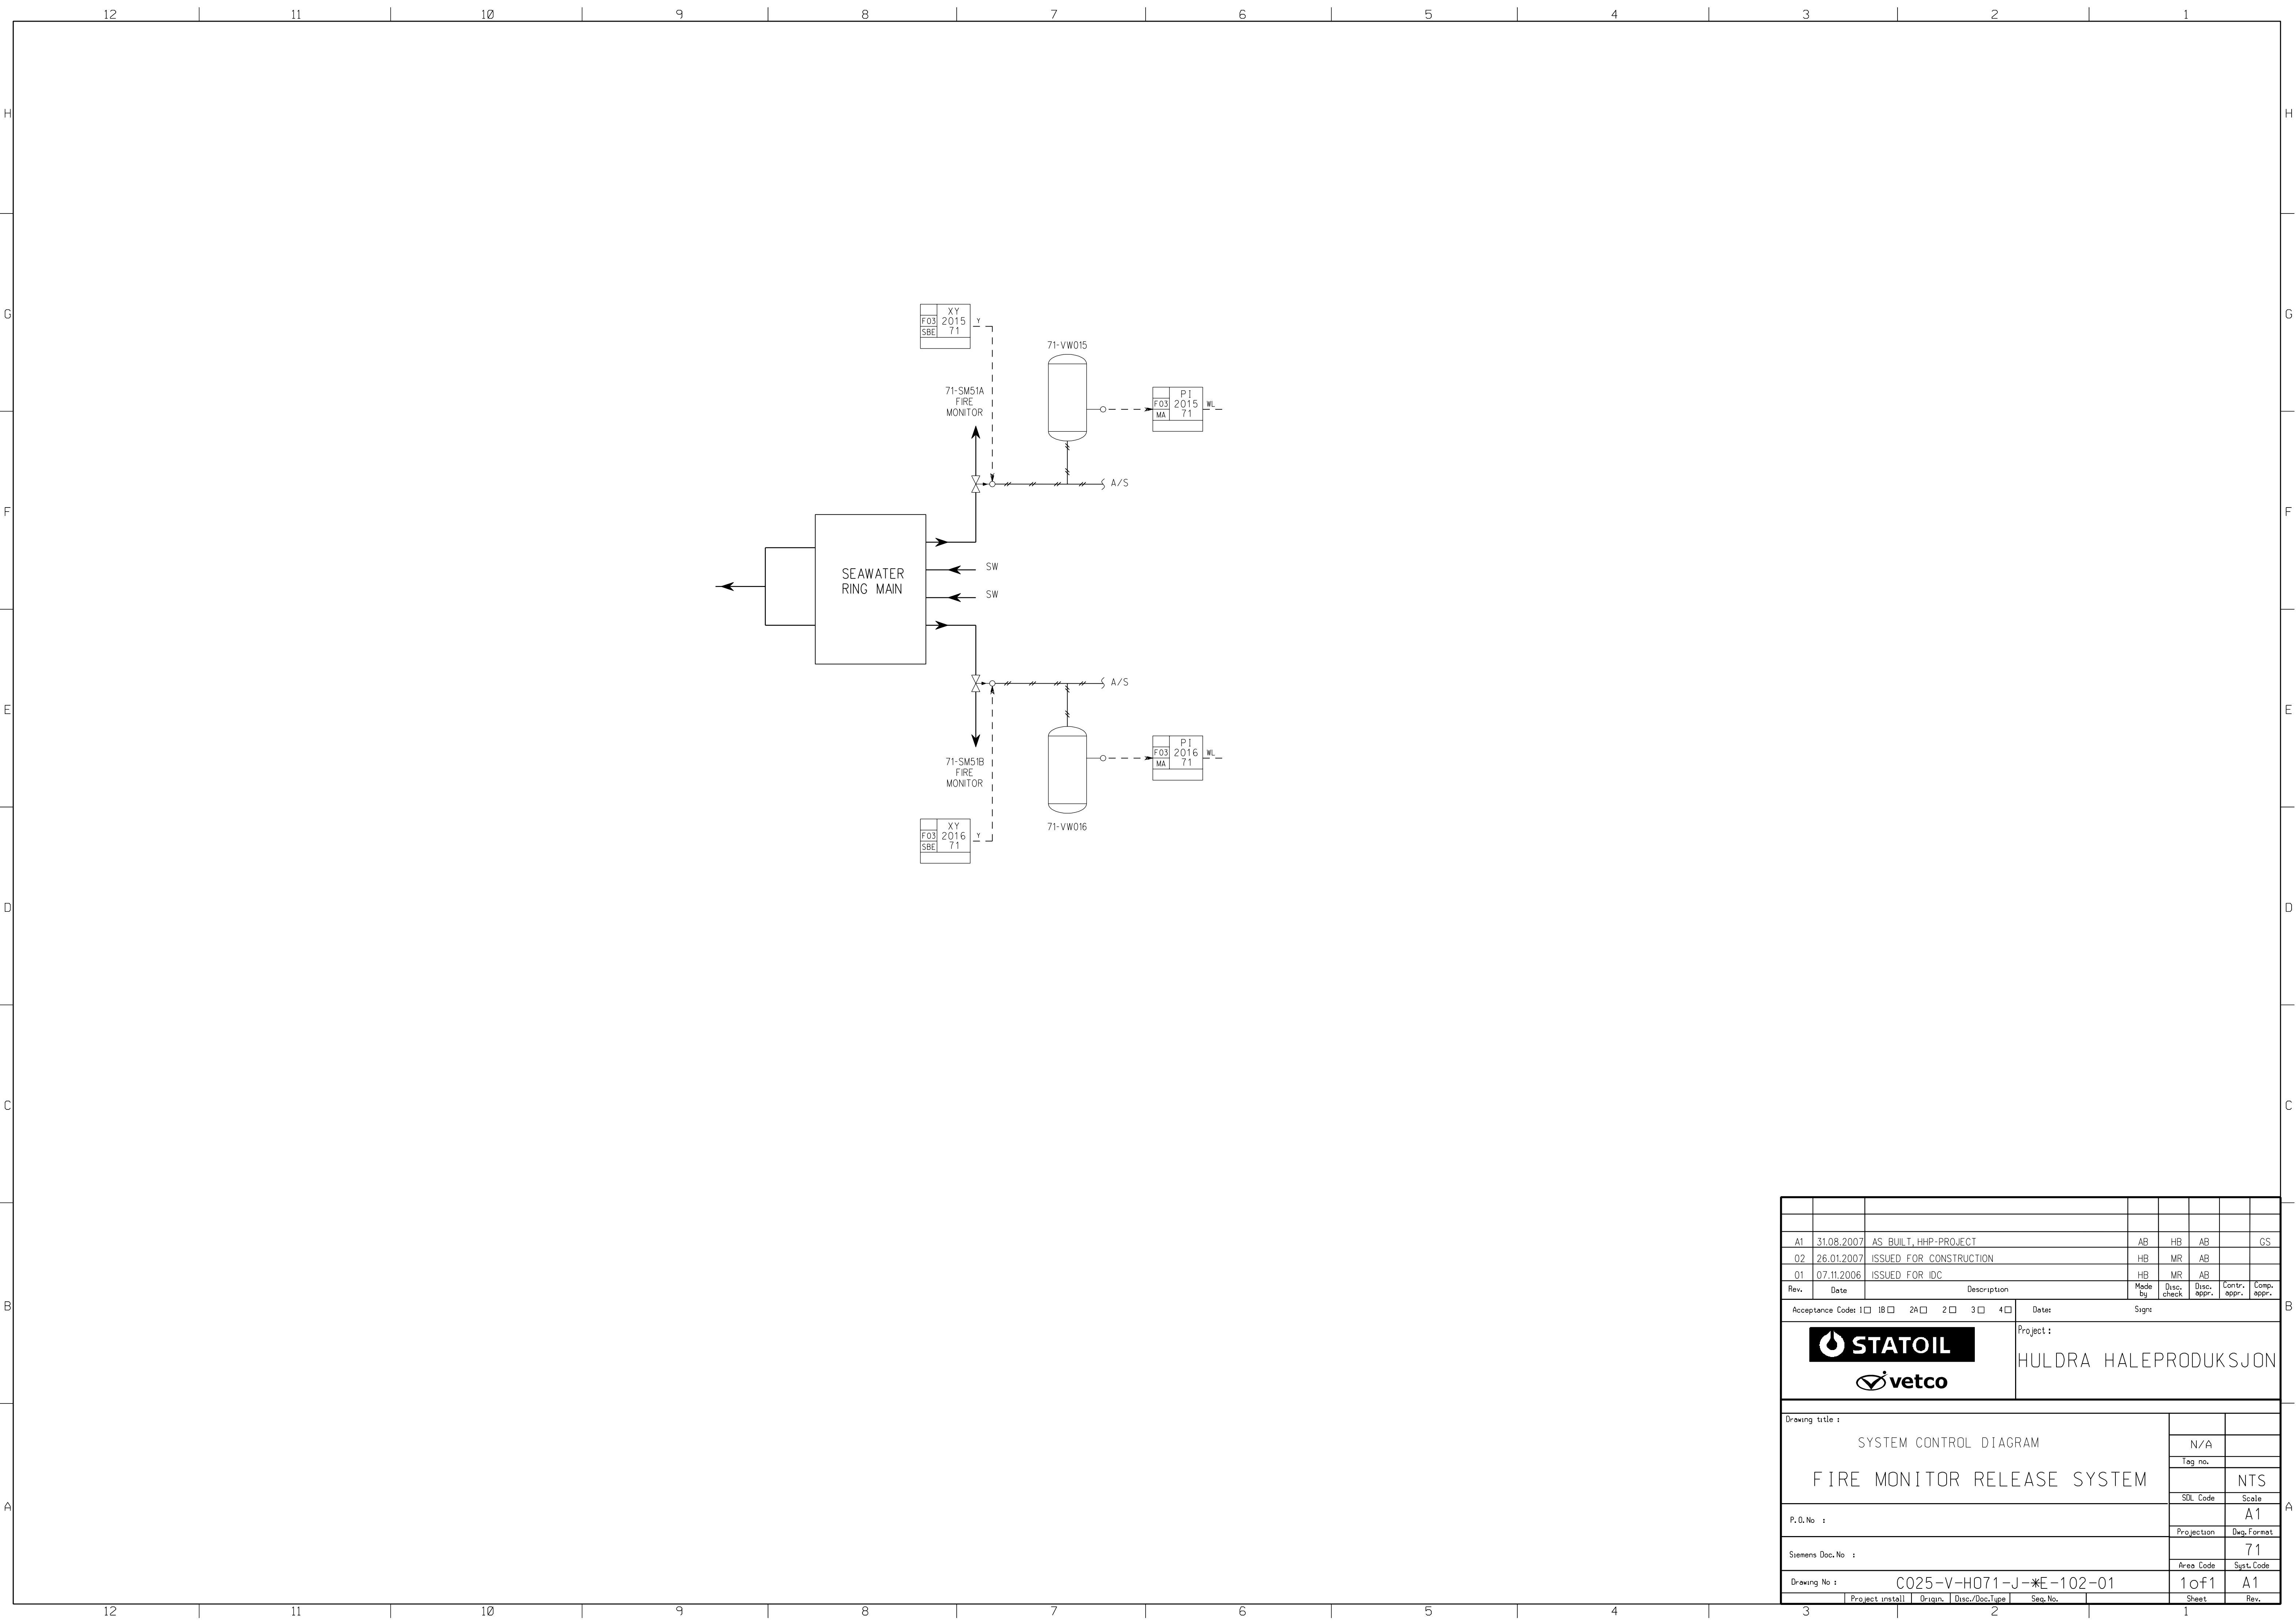

A1	31.08.2007	AS BUILT, HHP-PROJECT					AB	HB	AB		GS		
02	26.01.2007	ISSUED FOR CONSTRUCTION					HB	MR	AB				
01	07.11.2006	ISSUED FOR IDC					HB	MR	AB				
Rev.	Date	Description					Made by	Disc. check	Disc. appr.	Contr. appr.	Comp. appr.		
Acceptance Codes: 1 ☐ 1B ☐ 2A ☐ 2 ☐ 3 ☐ 4 ☐							Date:					Sign:	
 							Project :					HULDRA HALEPRODUKSJON	
Drawing title :													
SYSTEM CONTROL DIAGRAM FIRE MONITOR RELEASE SYSTEM								N/A					
								Tag no.					
								SOL Code		NTS			
								Scale		A1			
P.O.No :								Projection		Dwg.Format			
Siemens Doc. No. :								71					
Drawing No :								Area Code		Syst.Code			
C025-V-H071-J-✱E-102-01								1 of 1		A1			
		Project install		Origin		Disc./Doc.Type		Seq.No.		Sheet			
										Rev.			