


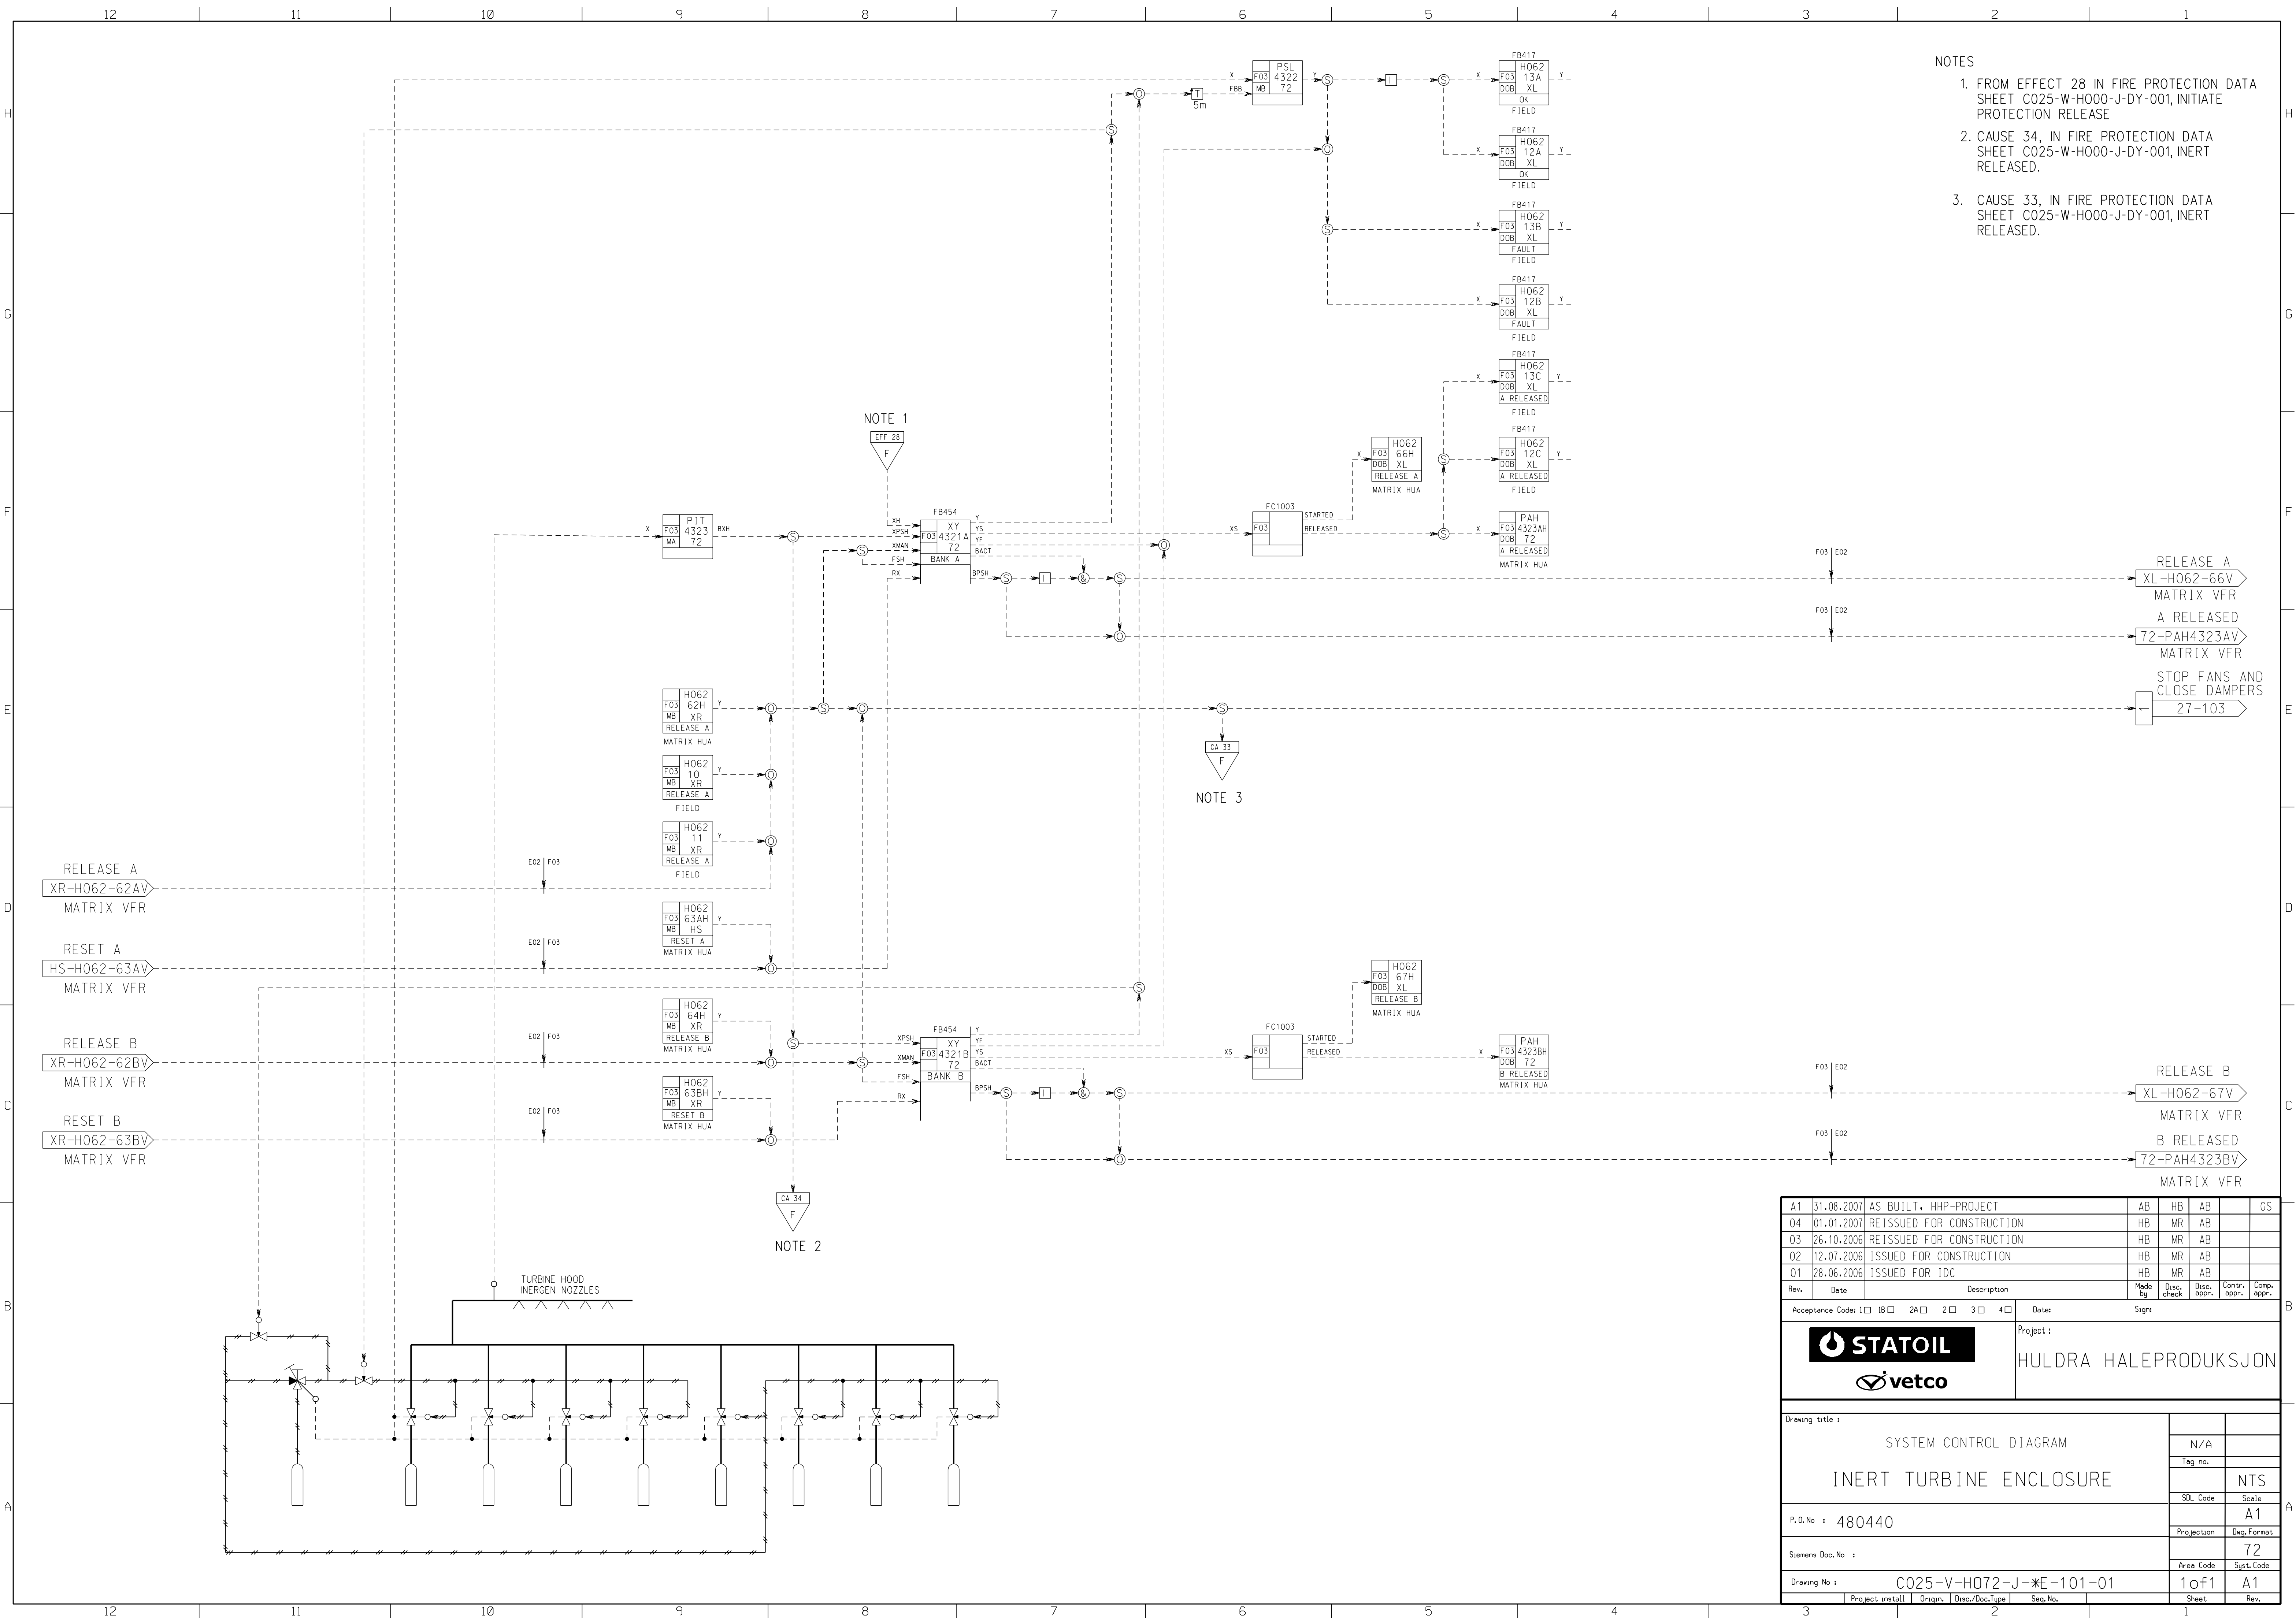

- NOTES
1. FROM EFFECT 28 IN FIRE PROTECTION DATA SHEET C025-W-H000-J-DY-001, INITIATE PROTECTION RELEASE
 2. CAUSE 34, IN FIRE PROTECTION DATA SHEET C025-W-H000-J-DY-001, INERT RELEASED.
 3. CAUSE 33, IN FIRE PROTECTION DATA SHEET C025-W-H000-J-DY-001, INERT RELEASED.

NOTE 1

NOTE 3

NOTE 2

A1	31.08.2007	AS BUILT, HHP-PROJECT	AB	HB	AB	GS
04	01.01.2007	REISSUED FOR CONSTRUCTION	HB	MR	AB	
03	26.10.2006	REISSUED FOR CONSTRUCTION	HB	MR	AB	
02	12.07.2006	ISSUED FOR CONSTRUCTION	HB	MR	AB	
01	28.06.2006	ISSUED FOR IDC	HB	MR	AB	
Rev.	Date	Description	Made by	Disc. check	Disc. appr.	Contr. appr.
Acceptance Codes: 1 0 1B 0 2A 0 2 0 3 0 4 0			Signs			
			Project: HULDRA HALEPRODUKSJON			
						
Drawing title:			N/A			
			Tag no.		NTS	
			SOL Code		Scale	
P.O.No : 480440			Projection		Dwg. Format	
Siemens Doc.No :			Area Code		Syst. Code	
Drawing No : C025-V-H072-J-✱E-101-01			1 of 1		Rev.	
Project install			Origin		Seq. No.	
			Sheet		Rev.	