


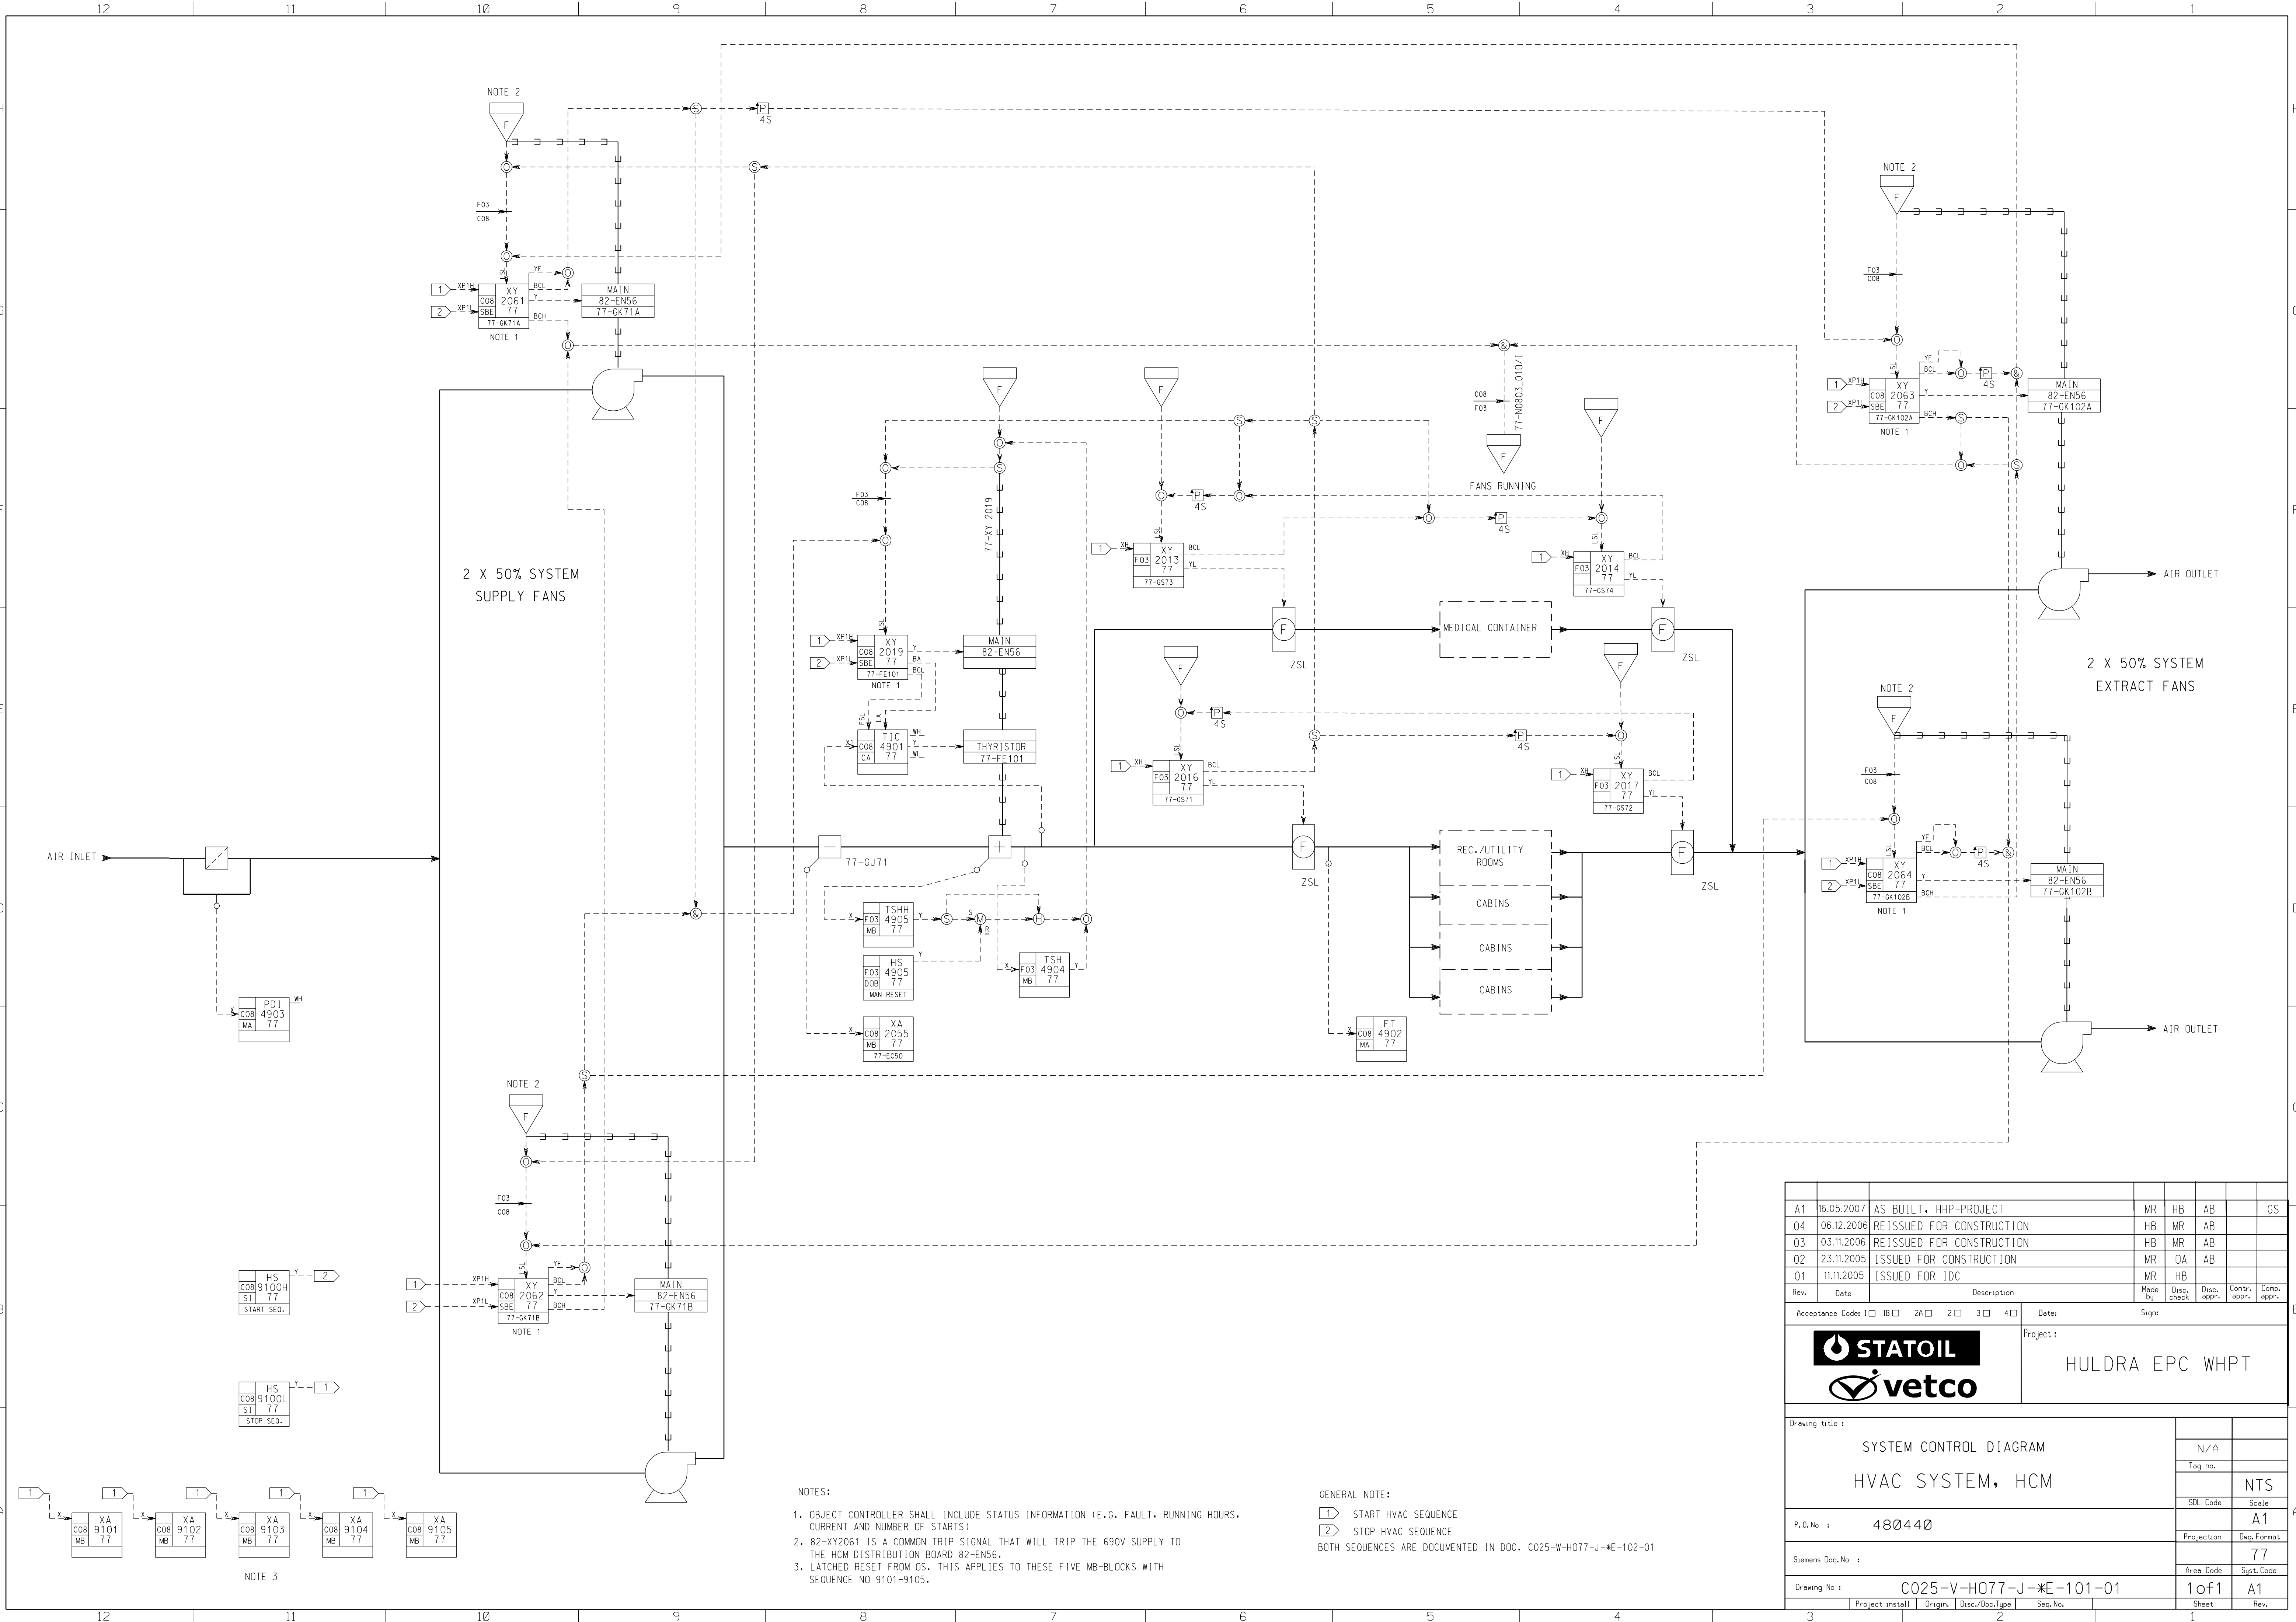

NOTES:

- OBJECT CONTROLLER SHALL INCLUDE STATUS INFORMATION (E.G. FAULT, RUNNING HOURS, CURRENT AND NUMBER OF STARTS)
- 82-XY2061 IS A COMMON TRIP SIGNAL THAT WILL TRIP THE 690V SUPPLY TO THE HCM DISTRIBUTION BOARD 82-EN56.
- LATCHED RESET FROM OS. THIS APPLIES TO THESE FIVE MB-BLOCKS WITH SEQUENCE NO 9101-9105.

GENERAL NOTE:

1 START HVAC SEQUENCE
2 STOP HVAC SEQUENCE
BOTH SEQUENCES ARE DOCUMENTED IN DOC. C025-W-H077-J-#E-102-01

A1	16.05.2007	AS BUILT, HHP-PROJECT		MR	HB	AB		GS	
04	06.12.2006	REISSUED FOR CONSTRUCTION		HB	MR	AB			
03	03.11.2006	REISSUED FOR CONSTRUCTION		HB	MR	AB			
02	23.11.2005	ISSUED FOR CONSTRUCTION		MR	QA	AB			
01	11.11.2005	ISSUED FOR IDC		MR	HB				
Rev.	Date	Description			Made by	Disc. check	Disc. appr.	Contr. appr.	Comp. appr.
Acceptance Codes: 1 0B 2A 2 3 4 0					Sign:				
 				Project :					
				HULDRA EPC WHPT					
Drawing title :									
SYSTEM CONTROL DIAGRAM						N/A			
						Tag no.			
HVAC SYSTEM, HCM						NTS			
						SDL Code		Scale	
P.O. No : 480440								A1	
Siemens Doc. No :						Projection		Dwg. Format	
								77	
C025-V-H077-J- E -101-01						Area Code		Syst. Code	
Drawing No :						1 of 1		A1	
Project install		Origin		Disc./Doc.Type		Seq. No.		Sheet	
								Rev.	