
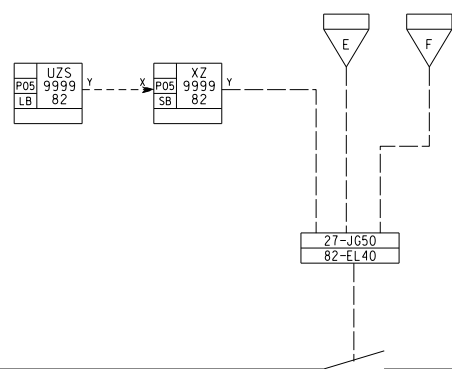


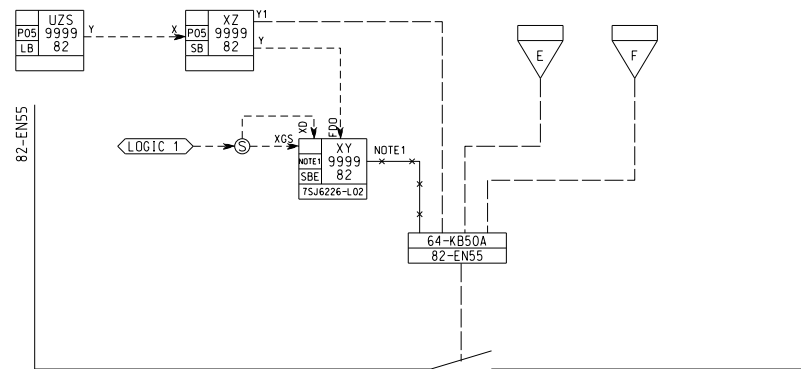

SWITCHBOARD			EQUIPMENT	DESCRIPTION	SAS UNIT	PROFIBUS NODE NO.	TAG NO.	ESD TRIP	F&G TRIP	PSD TRIP
TAG	CUBICLE	LOCALISATION								
82-EN55	01	A1A2	64-KB50A(M)	NITROGEN COMPRESSOR A	C08		64-KB50A			64-XY4013A
82-EN55	01	B1B2	64-FE52A	NITROGEN GENERATOR HEATER A	C08		64-FE52A			64-XY4008A
82-EN55	01	C1C2	64-FE53A	NITROGEN HIGH PRESSURE HEATER A	C08		64-FE53A			64-XY4030A
82-EN55	01	D1D2		PREPARED SPARE SPACE	C08					
82-EN55	01	E1G2	27-FE55A	WATER WASH RESERVOIR HEATER A	C09		27-HS4338			
82-EN55	01	H1J2	27-EC52A	SEP. STARTER FOR TURB. ENCL. VENT. FAN A	C09		27-GK52A			
82-EN55	01	K1M2		EQUIPPED SPARE	C09					
82-EN55	01	N1Q2	27-PX50(M)	HYDR. START PUMP MOTOR	C09		27-PX50			
82-EN55	02									
82-EN55	02	A1A2	27-GK51A(M)	NOISE HOOD VENT. FAN A	C09		27-GK51A			
82-EN55	02	B1B2	27-FE52A	TURBINE LUBE OIL RESERVOIR HEATER A	C09		27-FE52A			
82-EN55	02	C1C2	77-GK81A(M)	MOTOR VENT. INLET FAN A. LER/HER	C08		77-GK81A		77-XY2076	
82-EN55	02	D1D2	77-GK82A(M)	MOTOR VENT. EXTRACT FAN A. LER/HER	C08		77-GK82A		77-XY2078	
82-EN55	02	E1E2		PREPARED SPARE SPACE	C08					
82-EN55	02	F1G2	27-FE60A	LUBE OIL RESERVOIR HEATER A	C09		27-FE60A			
82-EN55	02	I1L2	27-PA51A(M)	LUBE OIL PUMP A MOTOR	C09		27-PA51A			
82-EN55	02	M1Q2	45-FE54A	TURBINE FUEL GAS HEATER A	C08		45-FE54A			45-XY4845A
82-EN55	03									
82-EN55	03	A1A2	24-PE001(M)	FLUID BARRIER PUMP MOTOR	C08		24-PE001			24-XY2002
82-EN55	03	G2H2		PREPARED SPARE SPACE	C08					
82-EN55	03	B1D2	24-PA001(M)	SCRUBBER PUMP MOTOR	C08		24-PA001			24-XY2001
82-EN55	03	E1G2	77-FE103	HVAC SYSTEM HEATER	C08		77-FE103		77-XY2075	
82-EN55	03	H1J2	50-PA52(M)	SEAWATER CIRC PUMP MOTOR	C08		50-PA52			50-XY4811
82-EN55	03	K1N2		PREPARED SPARE SPACE	C08					
82-EN55	03	O1Q2		CONTROL VOLTAGE TRANSFORMER	NA					
82-EN55	04									
82-EN55	04			INCOMING BREAKER FROM 82-EN52	C08		82-XY4864			
82-EN55	05									
82-EN55	05	A1A2	64-KB50B(M)	NITROGEN COMPRESSOR B	C08		64-KB50B			64-XY4013B
82-EN55	05	B1B2	64-FE52B	NITROGEN GENERATOR HEATER B	C08		64-FE52B			64-XY4008B
82-EN55	05	C1C2	64-FE53B	NITROGEN HIGH PRESSURE HEATER B	C08		64-FE53B			64-XY4030B
82-EN55	05	D1D2		EQUIPPED SPARE	C08					
82-EN55	05	E1G2	27-FE55B	WATER WASH RESERVOIR HEATER B	C09		27-FE55B			
82-EN55	05	H1J2	27-EC52B	SEP. STARTER FOR TURB. ENCL. VENT. FAN B	C09		27-GK52B			
82-EN55	05	K1K2		PREPARED SPARE SPACE	C09					
82-EN55	05	L1Q2	20-PA001(M)	SEPARATOR PUMP MOTOR	C08		20-PA001			20-XY2001
82-EN55	06									
82-EN55	06	A1A2	27-GK51B(M)	NOISE HOOD VENT. FAN B	C09		27-GK51B			
82-EN55	06	B1B2	27-FE52B	TURBINE LUBE OIL RESERVOIR HEATER B	C09		27-FE52B			
82-EN55	06	C1C2	77-GK81B(M)	MOTOR VENT. INLET FAN B. LER/HER	C08		77-GK81B		77-XY2077	
82-EN55	06	D1D2	77-GK82B(M)	MOTOR VENT. EXTRACT FAN B. LER/HER	C08		77-GK82B		77-XY2079	
82-EN55	06	E1E2	27-FE53	TURBINE ENCLOSURE SPACE HEATER	C09		27-FE53			
82-EN55	06	F1G2	27-FE60B	LUBE OIL RESERVOIR HEATER B	C09		27-FE60B			
82-EN55	06	I1L2	27-PA51B(M)	LUBE OIL PUMP B MOTOR	C09		27-PA51B			
82-EN55	06	M1Q2	45-FE54B	TURBINE FUEL GAS HEATER B	C08		45-FE54B			45-XY4845B
82-EN55	07									
82-EN55	07	A1A2	27-FE57/58/59	TO STAND STILL HEATERS FOR ANTI ICEING	NA					
82-EN55	07	B1B2		PREPARED SPARE SPACE	C09					
82-EN55	07	C1E2	27-FE57	TURBINE ANTI ICEING 50kw HEATER	C09		27-FE57			
82-EN55	07	F1I2	27-FE58	TURBINE ANTI ICEING 100kw HEATER	C09		27-FE58			
82-EN55	07	J1M2	27-FE59	TURBINE ANTI ICEING 150kw HEATER	C09		27-FE59			
82-EN55	07	N1Q2	63-EC051	SEP. STARTER TO AIR COMPRESSOR MOTOR	C08		63-KC051		63-XY4850	
82-EN55	07	G2H2		PREPARED SPARE SPACE	C08					

SWITCHBOARD	CIRCUIT NO.	EQUIPMENT	DESCRIPTION	ESD TRIP	F&G TRIP	PSD TRIP	PCS CONTROL	FAULT ALARM
82-EL40	1	27-JG50	UCP IGNITION, SOCKET AND LIGHT		82-XY4855			82-XA4894
82-EL40	2	ES-EF-01_82-EL40_02	SOCKET OUTLETS 16A IN MODULE		82-XY4853			82-XA4894
82-EL40	3	ES-EF-01_82-EL40_03	SOCKET OUTLETS 16A IN MODULE		82-XY4854			82-XA4894
82-EL40	4		SPARE					
82-EL40	5		SPARE					
82-EL40	6	EA-BB-01_82-EL40_06	FLOOD LIGHT					82-XA4894
82-EL40	7	63-VK050	AIR DRYER FOR AIR COMPRESSOR		82-XY4859			82-XA4894
82-EL40	8	64-FE050/051	SPACE HEATERS NITROGEN COMPR. A				64-XY4032	82-XA4894
82-EL40	9	64-FE052/053	SPACE HEATERS NITROGEN COMPR. B				64-XY4042	82-XA4894
82-EL40	10	50-F14810	FLOW TRANSMITTER SEA WATER CIRCULATION					82-XA4894
82-EL40	11	81-FE50	SPACE HEATER GENERATOR TERM BOX					82-XA4894
82-EL40	12	27-FE54	ANTI ICE HEATER JUNCTION BOX HEATER					82-XA4894
82-EL40	13	71-FE067	SPACE HEATER FIRE WATER HYDRANT					82-XA4894
82-EL40	14	45-FE55/56	SPACE HEATER FUEL GAS METERING SKID					82-XA4894
82-EL40	15	81-FE51/52A-B-C	SPACE HEATERS GENERATOR				82-XY4861	82-XA4894
82-EL40	16	87-FE050	SPACE HEATER SAS PCS REMOTE I/O					82-XA4894
82-EL40	17	EJ-H-HE27-020	HEAT TRACE SYS. 27				82-XY4862	82-XA4893
82-EL40	18	EJ-H-HE45-013	HEAT TRACE SYS. 45				82-XY4862	82-XA4891
82-EL40	19	EJ-H-HE27-010	HEAT TRACE SYS. 27				82-XY4862	82-XA4892
82-EL40	20	EJ-H-HE45-002	HEAT TRACE SYS. 45				82-XY4862	82-XA4880
82-EL40	21	EJ-H-HE27-019	HEAT TRACE SYS. 27				82-XY4862	82-XA4881
82-EL40	22	EJ-H-HE64-001	HEAT TRACE SYS. 64				82-XY4862	82-XA4882
82-EL40	23	EJ-H-HE27-034	HEAT TRACE SYS. 27				82-XY4862	82-XA4883
82-EL40	24	EJ-H-HE65-001	HEAT TRACE SYS. 65				82-XY4862	82-XA4884
82-EL40	25	EJ-H-HE69-001	HEAT TRACE SYS. 69				82-XY4862	82-XA4885
82-EL40	26	EJ-E-HE45-010	HEAT TRACE SYS. 45				82-XY4862	82-XA4886
82-EL40	27	EA-AB-01_82-EL40_27	LIGHTING MAIN DECK					82-XA4894
82-EL40	28	EA-AB-01_82-EL40_28	LIGHTING MEZZ DECK					82-XA4894
82-EL40	29	EA-AB-01_82-EL40_29	LIGHTING WEATHER DECK					82-XA4894
82-EL40	30	EA-AB-01_82-EL40_30	LIGHTING MAIN DECK					82-XA4894
82-EL40	31	EA-AB-01_82-EL40_31	LIGHTING WEATHER DECK					82-XA4894
82-EL40	32	EA-BB-01_82-EL40_32	FLOOD LIGHT					82-XA4894
82-EL40	33	EJ-H-HE50-008	HEAT TRACE SYS. 50				82-XY4865	82-XA4887
82-EL40	34	EJ-H-HE53-001	HEAT TRACE SYS. 53				82-XY4865	82-XA4888
82-EL40	35		HEAT TRACE SYS. SPARE				82-XY4865	82-XA4889
82-EL40	36		HEAT TRACE SYS. SPARE				82-XY4865	82-XA4890

NOTES:
1: SAS UNIT IDENTIFICATION AS SPECIFIED IN MATRIX.

A1	20.08.2007	AS BUILT, HHP-PROJECT	AB	HB	AB	GS
O4	23.02.2007	REISSUED FOR CONSTRUCTION	MR	SRY	AB	
O3	27.10.2006	REISSUED FOR CONSTRUCTION	MR	SRY	AB	
A2	30.05.2013	AS BUILT NW.969718 WO.21970453	HeEr	ReToIs	SvBo	
O1	14.07.2006	ISSUED FOR IDC	TS	JOM	AB	
Rev.	Date	Description	Made by	Disc. check	Disc. appr.	Contr. appr.
Acceptance Code: 1 ☐ 1B ☐ 2A ☐ 2 ☐ 3 ☐ 4 ☐			Sign:			
 			Project : HULDRA HALEPRODUKSJON			
Drawing title :						
SYSTEM CONTROL DIAGRAM 690V & 400/230V FEEDERS COMPRESSOR MODULE					N/A	
					Tag no.	
					NTS	
					SDL Code Scale	
P.O.No :					A1	
Siemens Doc.No :					Projection Dec.Format	
					82	
Drawing No : C025-V-H082-J-#E-102-01					Area Code Syst.Code	
					1 of 1 A2	
Project install			Origin		Disc./Doc.Type	
			Seq.No.			
					Sheet	
					Rev.	