



TYPICAL CONFIGURATION OF CONTACTOR FEEDER WITH SIMOCODE

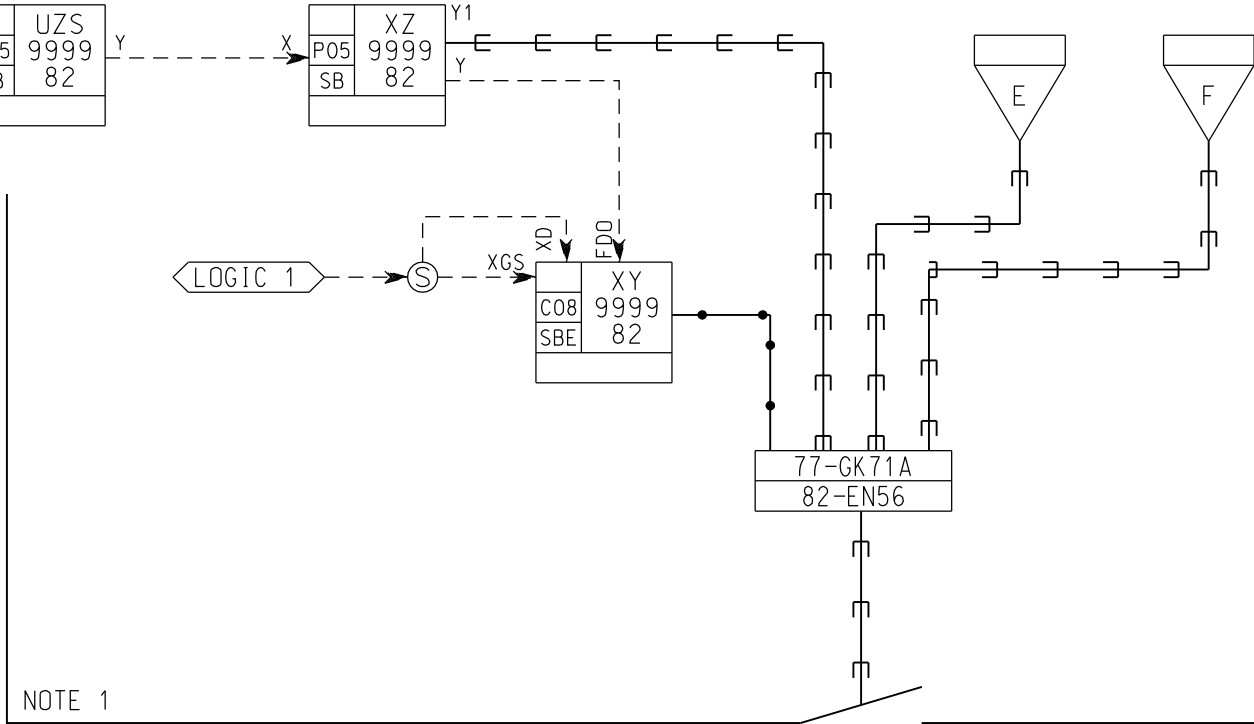

NOTE 1

| SWITCHBOARD |          | EQUIPMENT    | DESCRIPTION                | SAS UNIT | PROFIBUS NODE NO. | TAG NO.   | ESD TRIP | F&G TRIP  | PSD TRIP |
|-------------|----------|--------------|----------------------------|----------|-------------------|-----------|----------|-----------|----------|
| TAG         | POSITION |              |                            |          |                   |           |          |           |          |
| 82-EN56     | -Q01     | 77-GK71A(M)  | HVAC SUPPLY FAN A          | C08      | 50                | 77-GK71A  |          |           |          |
| 82-EN56     | -Q02     | 77-GK71B(M)  | HVAC SUPPLY FAN B          | C08      | 51                | 77-GK71B  |          |           |          |
| 82-EN56     | -Q03     | 77-GK102A(M) | HVAC EXTRACT FAN A         | C08      | 52                | 71-GK102A |          |           |          |
| 82-EN56     | -Q04     | 77-GK102B(M) | HVAC EXTRACT FAN B         | C08      | 53                | 77-GK102B |          |           |          |
| 82-EN56     | -Q05     | 77-EC50      | HVAC AIR COOLING UNIT CP   | C08      | 54                | 77-EC50   |          |           |          |
| 82-EN56     | -Q06     | 53-EC52      | WATER HEATER 53-FE052A & B | C08      | 55                | 53-EC52   |          |           |          |
| 82-EN56     | -Q07     | 77-FE101     | HVAC PREHEATER             | C08      | 56                | 77-FE101  |          | 77-XY2019 |          |

TYPICAL CONFIGURATION OF CONTACTOR FEEDER WITH TRIP RELAY

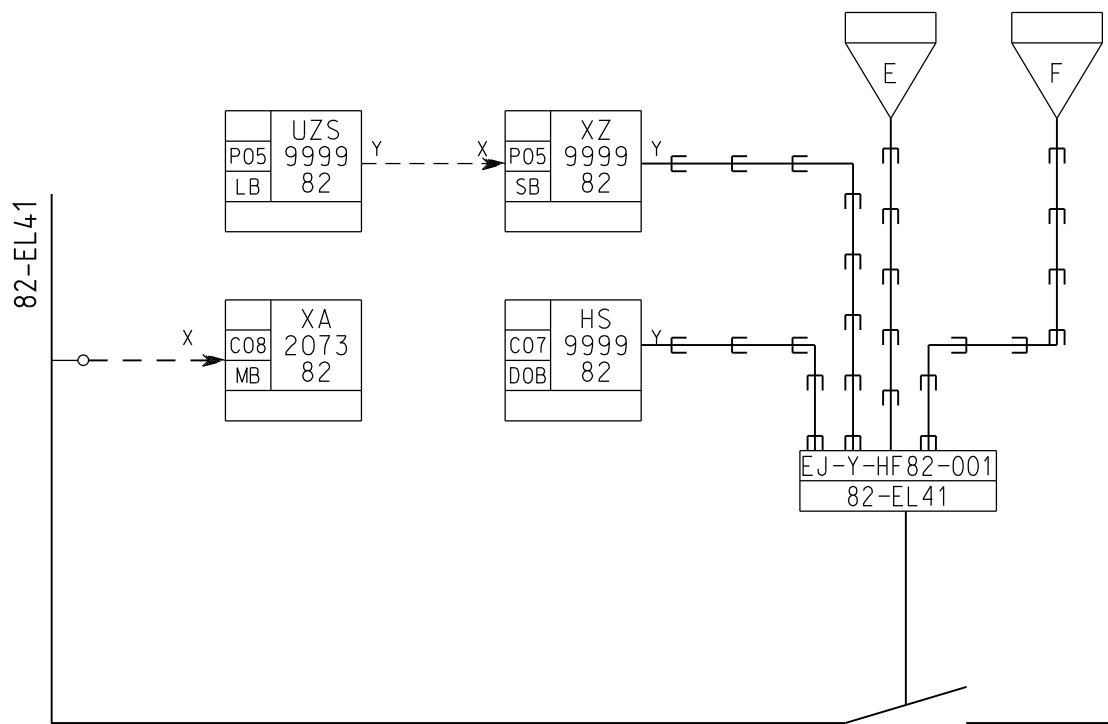

NOTE 2

| SWITCHBOARD | CIRCUIT NO. | EQUIPMENT           | DESCRIPTION                                 | ESD TRIP | F&G TRIP  | PSD TRIP  | PCS CONTROL |
|-------------|-------------|---------------------|---------------------------------------------|----------|-----------|-----------|-------------|
| 82-EL41     | 1           | EJ-Y-HF82-001       | LIGHTING & SMALL POWER IN CABIN             |          |           |           |             |
| 82-EL41     | 2           | EJ-Y-HF82-002       | LIGHTING & SMALL POWER IN CABIN             |          |           |           |             |
| 82-EL41     | 3           | EJ-Y-HF82-007       | LIGHTING & SMALL POWER IN CABIN             |          |           |           |             |
| 82-EL41     | 4           | EJ-Y-HF82-010       | LIGHTING & SMALL POWER IN CABIN             |          |           |           |             |
| 82-EL41     | 5           | EJ-Y-HF82-011       | LIGHTING & SMALL POWER IN CABIN             |          |           |           |             |
| 82-EL41     | 6           | EJ-Y-HF82-003       | LIHGTING 1ST. FLOOR                         |          |           |           |             |
| 82-EL41     | 7           | EJ-Y-HF82-005       | LIGHTING 2ND. FLOOR                         |          |           |           |             |
| 82-EL41     | 8           | EJ-Y-HF82-012       | LIGHTING 3RD. FLOOR                         |          |           |           |             |
| 82-EL41     | 9           | EJ-E-HB82-500       | LIGHTING C&F CONTAINER                      |          |           |           |             |
| 82-EL41     | 10          | EJ-Y-HF82-023       | LIGHTING MEDICAL CENTRE                     |          |           |           |             |
| 82-EL41     | 11          | EJ-Y-HF82-024       | EXAMINATION LAMP MEDICAL CENTRE             |          |           |           |             |
| 82-EL41     | 12          | EJ-Y-HF82-014       | SOCKET OUTLETS 1ST. FLOOR                   |          |           |           | 82-XY2021   |
| 82-EL41     | 13          | EJ-Y-HF82-009       | SOCKET OUTLETS 2ND. FLOOR                   |          |           |           | 82-XY2021   |
| 82-EL41     | 14          | EJ-Y-HF82-015       | SOCKET OUTLETS 3RD. FLOOR                   |          |           |           | 82-XY2021   |
| 82-EL41     | 15          | EJ-Y-HF82-020       | SOCKET OUTLET MEDICAL CENTRE                |          |           |           | 82-XY2021   |
| 82-EL41     | 16          | EJ-H-HF53-001       | HEAT TRACING HOT WATER                      |          |           |           |             |
| 82-EL41     | 17          | ES-EB-01_82-EL41_17 | OUTLET IN TELEPHONE/DATA DISTRIBUTION PANEL |          |           |           |             |
| 82-EL41     | 18          | EJ-Y-HF74-001       | PANEL HEATERS REC. ROOM/SMOKE ROOM          |          |           |           |             |
| 82-EL41     | 19          | 74-FE94             | PANEL HEATERS CHANGE ROOM                   |          |           |           |             |
| 82-EL41     | 20          | EJ-Y-HF74-002       | PANEL HEATERS MEDICAL CENTRE                |          |           |           |             |
| 82-EL41     | 21          | ES-EB-01_82-EL41_21 | TUMBLE DRYER LAUNDRY                        |          |           |           | 82-XY2021   |
| 82-EL41     | 22          | ES-EB-01_82-EL41_22 | WASHING MACHINE LAUNDRY                     |          |           |           | 82-XY2021   |
| 82-EL41     | 23          | EJ-Y-HF82-026       | DISHWASHER COFFE BAR                        |          |           |           | 82-XY2021   |
| 82-EL41     | 24          | ES-EB-01_82-EL41_24 | REFRIGERATOR COFFE BAR                      |          |           |           |             |
| 82-EL41     | 25          | ES-EB-01_82-EL41_25 | COFFE MACHINE                               |          |           |           | 82-XY2021   |
| 82-EL41     | 26          | ES-EB-01_82-EL41_26 | CVC UNIT                                    |          |           |           | 82-XY2021   |
| 82-EL41     | 27          |                     | SPARE                                       |          |           |           |             |
| 82-EL41     | 28          | EA-AB-01_82-EL41_28 | LIGHTING OUTDOOR ROOF AREA                  |          |           |           |             |
| 82-EL41     | 29          | 53-EC52             | WATER HEATER ( CONTROL VOLTAGE)             |          |           | 53-XY2086 |             |
| 82-EL41     | 30          | ES-EB-01_82-EL41_30 | WATER HEATER MEDICAL CENTRE                 |          |           | 53-XY2086 |             |
| 82-EL41     | 31          |                     | SPARE                                       |          |           |           |             |
| 82-EL41     | 32          | ES-EB-01_82-EL41_32 | SOCKET OUTLET ROOF AREA                     |          | 82-XY2062 |           |             |
| 82-EL41     | 33          | EJ-H-HF71-001       | HEAT TRACING OF FIREWATER LINES             |          |           |           |             |
| 82-EL41     | 34          | 74-EC50             | C&F CONTROL PANEL/C&F CONTAINER             |          | 82-XY2063 |           |             |
| 82-EL41     | 35          |                     |                                             |          | 82-XY2062 |           |             |
| 82-EL41     | 36          | 76-ET53             | POWER SUPPLY FREE FALL LIFE BOAT            |          | 82-XY2062 |           |             |

NOTES:

- 1: SWITCHBOARD IS TRIPPED BY 82-XY2061 ON CONTACTOR IN 82-EN52  
 2: SEE DWG. C025-W-H000-J-WE-040-01 FOR USE IN "UNMANNED MODE"

|                                                                                                                                                                                      |            |                                          |                                    |                |             |              |             |    |            |
|--------------------------------------------------------------------------------------------------------------------------------------------------------------------------------------|------------|------------------------------------------|------------------------------------|----------------|-------------|--------------|-------------|----|------------|
|                                                                                                                                                                                      |            |                                          |                                    |                |             |              |             |    |            |
| A2                                                                                                                                                                                   | 27.10.09   | AS BUILT, ACC. TO M5:40974117/A021168843 | NJ                                 | TV             | EVO         | VH           |             |    |            |
| A1                                                                                                                                                                                   | 28.08.2007 | AS BUILT, HHP-PROJECT                    | AB                                 | MR             | AB          |              |             | GS |            |
| O2                                                                                                                                                                                   | 30.10.2006 | ISSUED FOR CONSTRUCTION                  | MR                                 | SRY            | AB          |              |             |    |            |
| O1                                                                                                                                                                                   | 04.10.2006 | ISSUED FOR IDC                           | MR                                 | GL             |             |              |             |    |            |
| Rev.                                                                                                                                                                                 | Date       | Description                              | Made by                            | Disc. check    | Disc. appr. | Contr. appr. | Comp. appr. |    |            |
| Acceptance Codes 1 <input type="checkbox"/> 1B <input type="checkbox"/> 2A <input type="checkbox"/> 2 <input type="checkbox"/> 3 <input type="checkbox"/> 4 <input type="checkbox"/> |            |                                          | Signs                              |                |             |              |             |    |            |
| <br>       |            |                                          | Project :<br>HULDRA HALEPRODUKSJON |                |             |              |             |    |            |
| Drawing title :<br>SYSTEM CONTROL DIAGRAM<br>690V & 400/230V FEEDERS<br>HCM                                                                                                          |            |                                          |                                    |                |             |              |             |    |            |
|                                                                                                                                                                                      |            |                                          |                                    |                |             |              |             |    | N/A        |
|                                                                                                                                                                                      |            |                                          |                                    |                |             |              |             |    | Tag no.    |
|                                                                                                                                                                                      |            |                                          |                                    |                |             |              |             |    | NTS        |
|                                                                                                                                                                                      |            |                                          |                                    |                |             |              |             |    | Scale      |
|                                                                                                                                                                                      |            |                                          |                                    |                |             |              |             |    | A2         |
| P.O.No :                                                                                                                                                                             |            |                                          |                                    |                |             |              |             |    | Projection |
|                                                                                                                                                                                      |            |                                          |                                    |                |             |              |             |    | Dwg.Format |
| Siemens Doc.No :                                                                                                                                                                     |            |                                          |                                    |                |             |              |             |    | 82         |
|                                                                                                                                                                                      |            |                                          |                                    |                |             |              |             |    | Area Code  |
|                                                                                                                                                                                      |            |                                          |                                    |                |             |              |             |    | Syst. Code |
| Drawing No : C025-V-H082-J-WE-103-01                                                                                                                                                 |            |                                          |                                    |                |             |              |             |    | 1 of 1     |
|                                                                                                                                                                                      |            |                                          |                                    |                |             |              |             |    | Rev.       |
| Project install                                                                                                                                                                      |            |                                          | Origin.                            | Disc./Doc.Type | Seq.No.     |              |             |    |            |
|                                                                                                                                                                                      |            |                                          |                                    |                |             |              |             |    |            |