


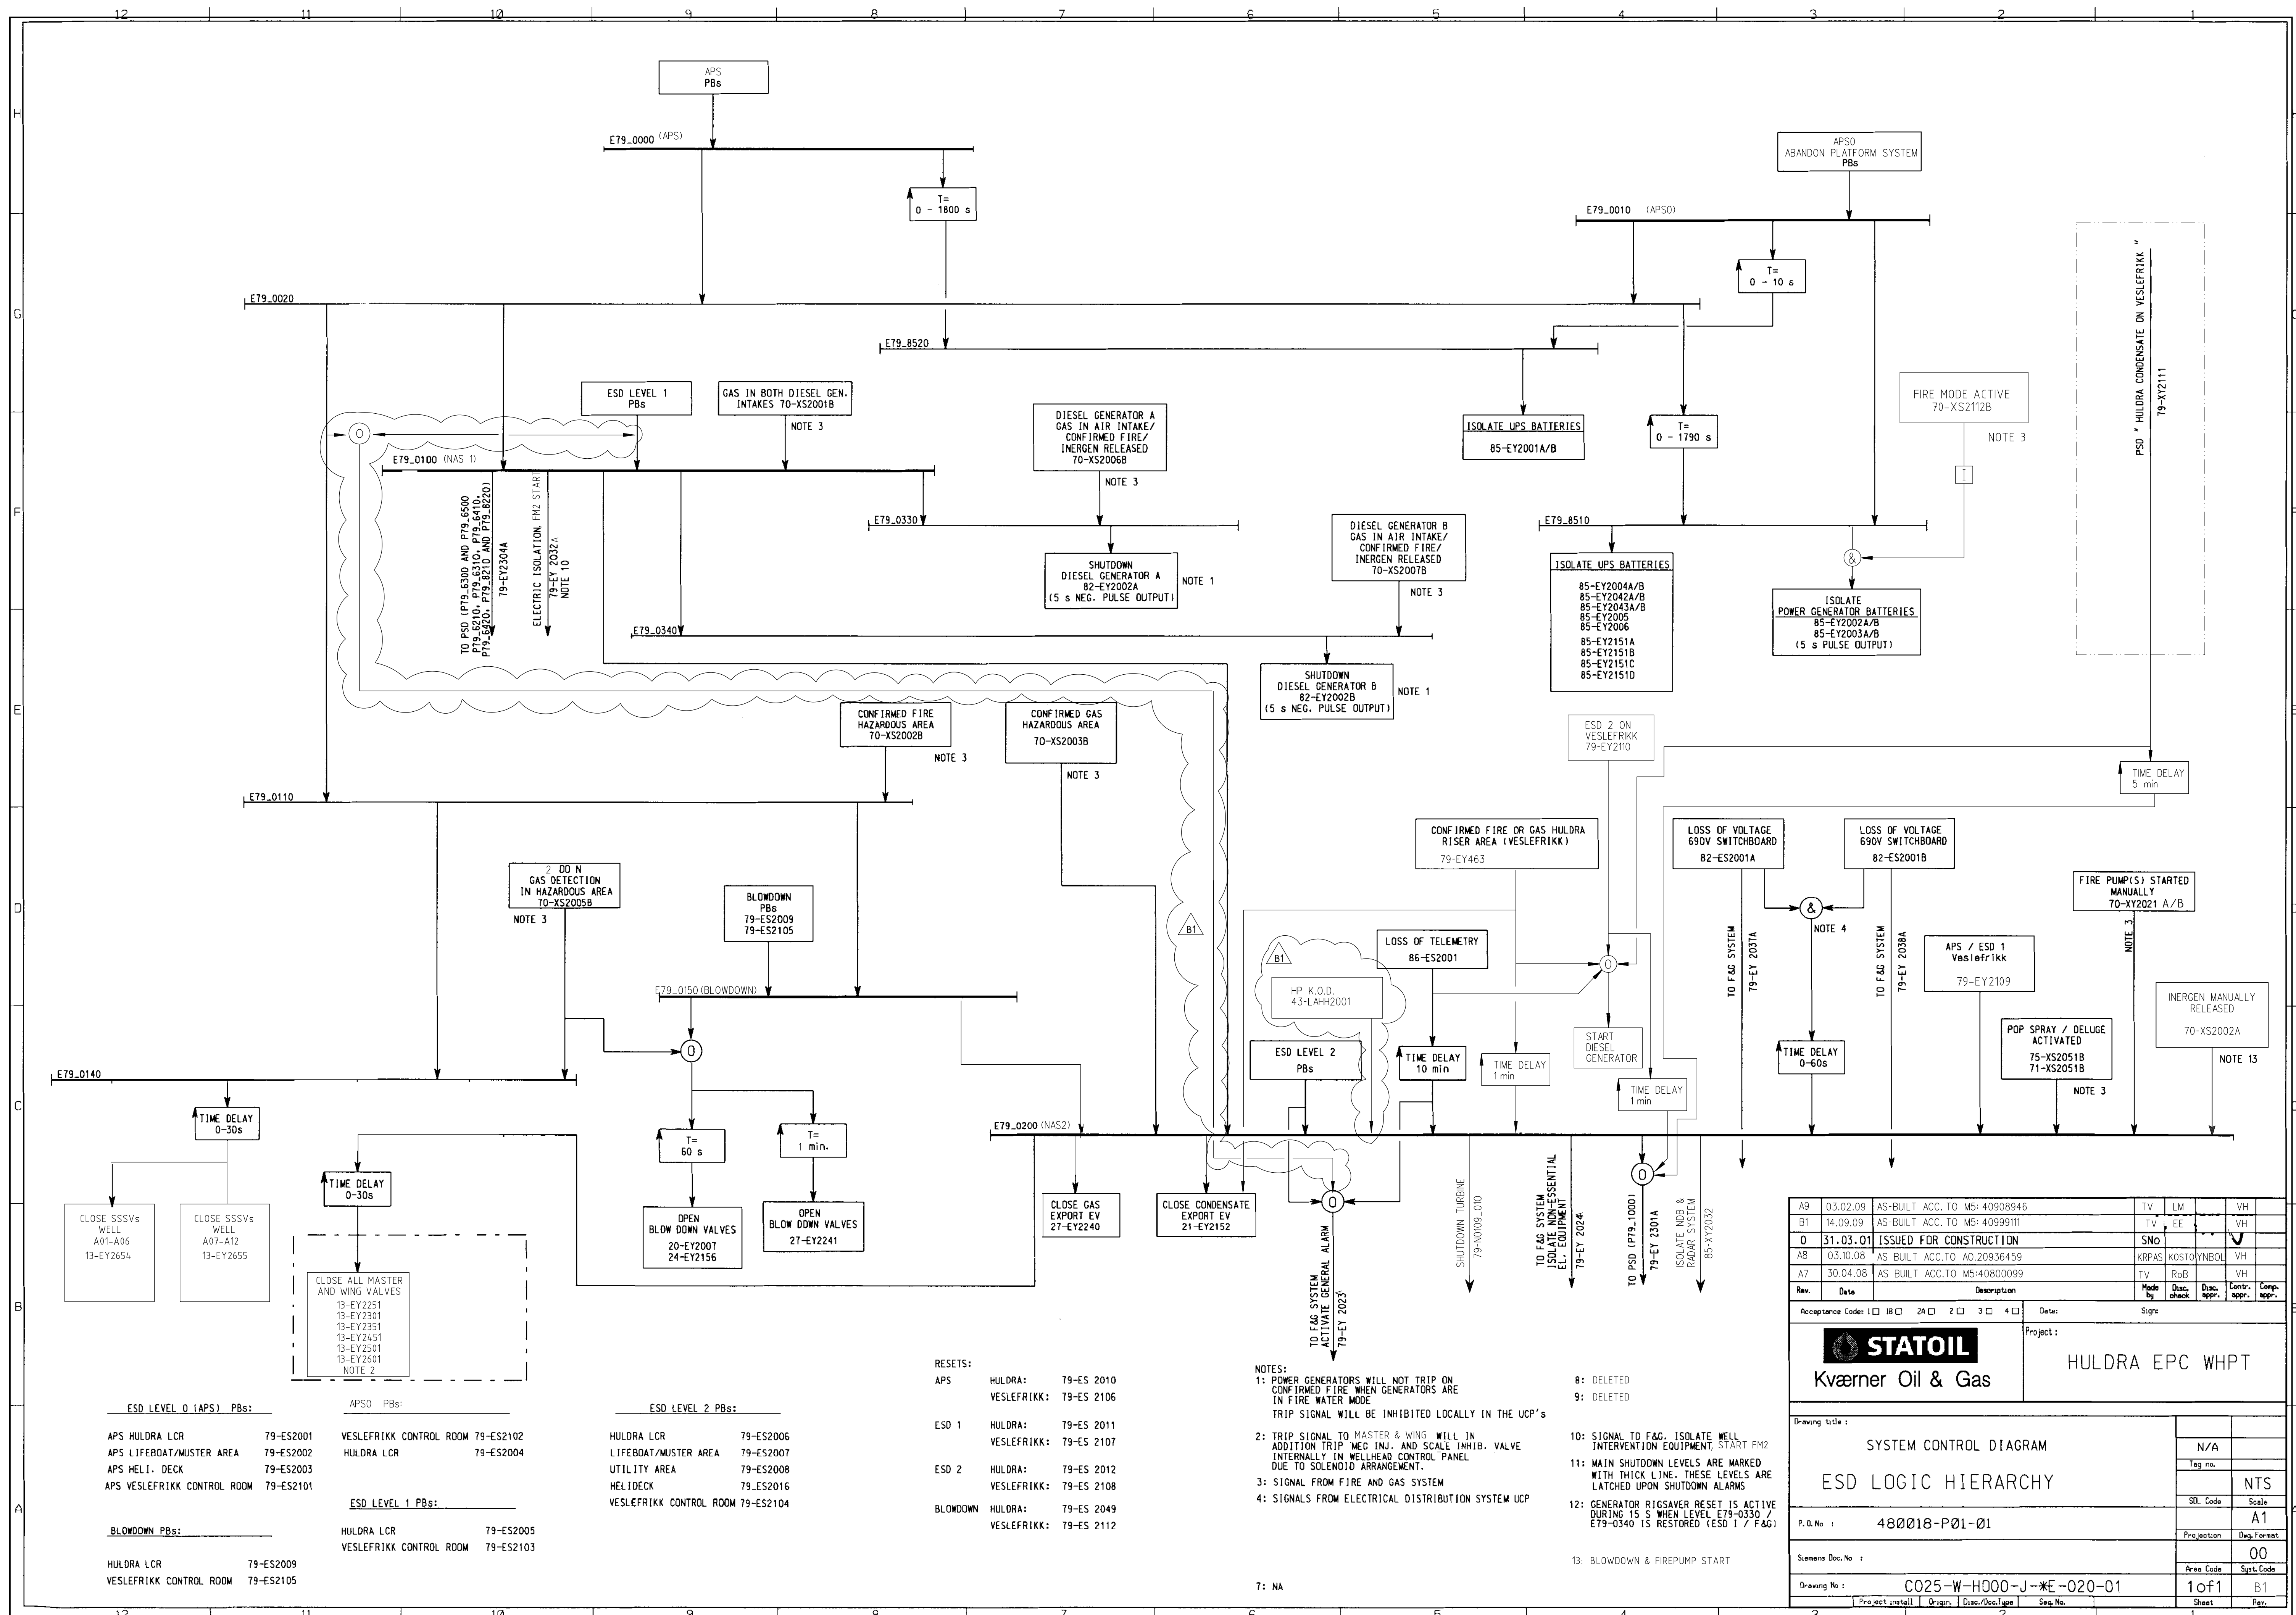

A9	03.02.09	AS-BUILT ACC. TO M5:40908946	TV	LM		VH
B1	14.09.09	AS-BUILT ACC. TO M5:40999111	TV	EE		VH
0	31.03.01	ISSUED FOR CONSTRUCTION	SNo			V
A8	03.10.08	AS BUILT ACC. TO A0.20936459	KRPAS	KOSTO	YNBOL	VH
A7	30.04.08	AS BUILT ACC. TO M5:40800099	TV	RoB		VH
Rev.	Date	Description	Made by	Disc. check	Disc. app.	Contr. app.
Acceptance Code: ☐ 1B ☐ 2A ☐ 2 ☐ 3 ☐ 4 ☐			Sign:			
 STATOIL Kværner Oil & Gas			Project : HULDRA EPC WHPT			
Drawing title :						
SYSTEM CONTROL DIAGRAM				N/A		
				Tag no.		
ESD LOGIC HIERARCHY						NTS
				Std. Code		Scale
P.O. No : 480018-P01-01						A1
				Projection		Dep. Format
Siemens Doc. No :						00
Drawing No : C025-W-H000-J--E-020-01				Area Code		Syst. Code
				1 of 1		B1
Project install			Origin	Disc./Doc./type	Seq. No.	
					Sheet	Rev.