


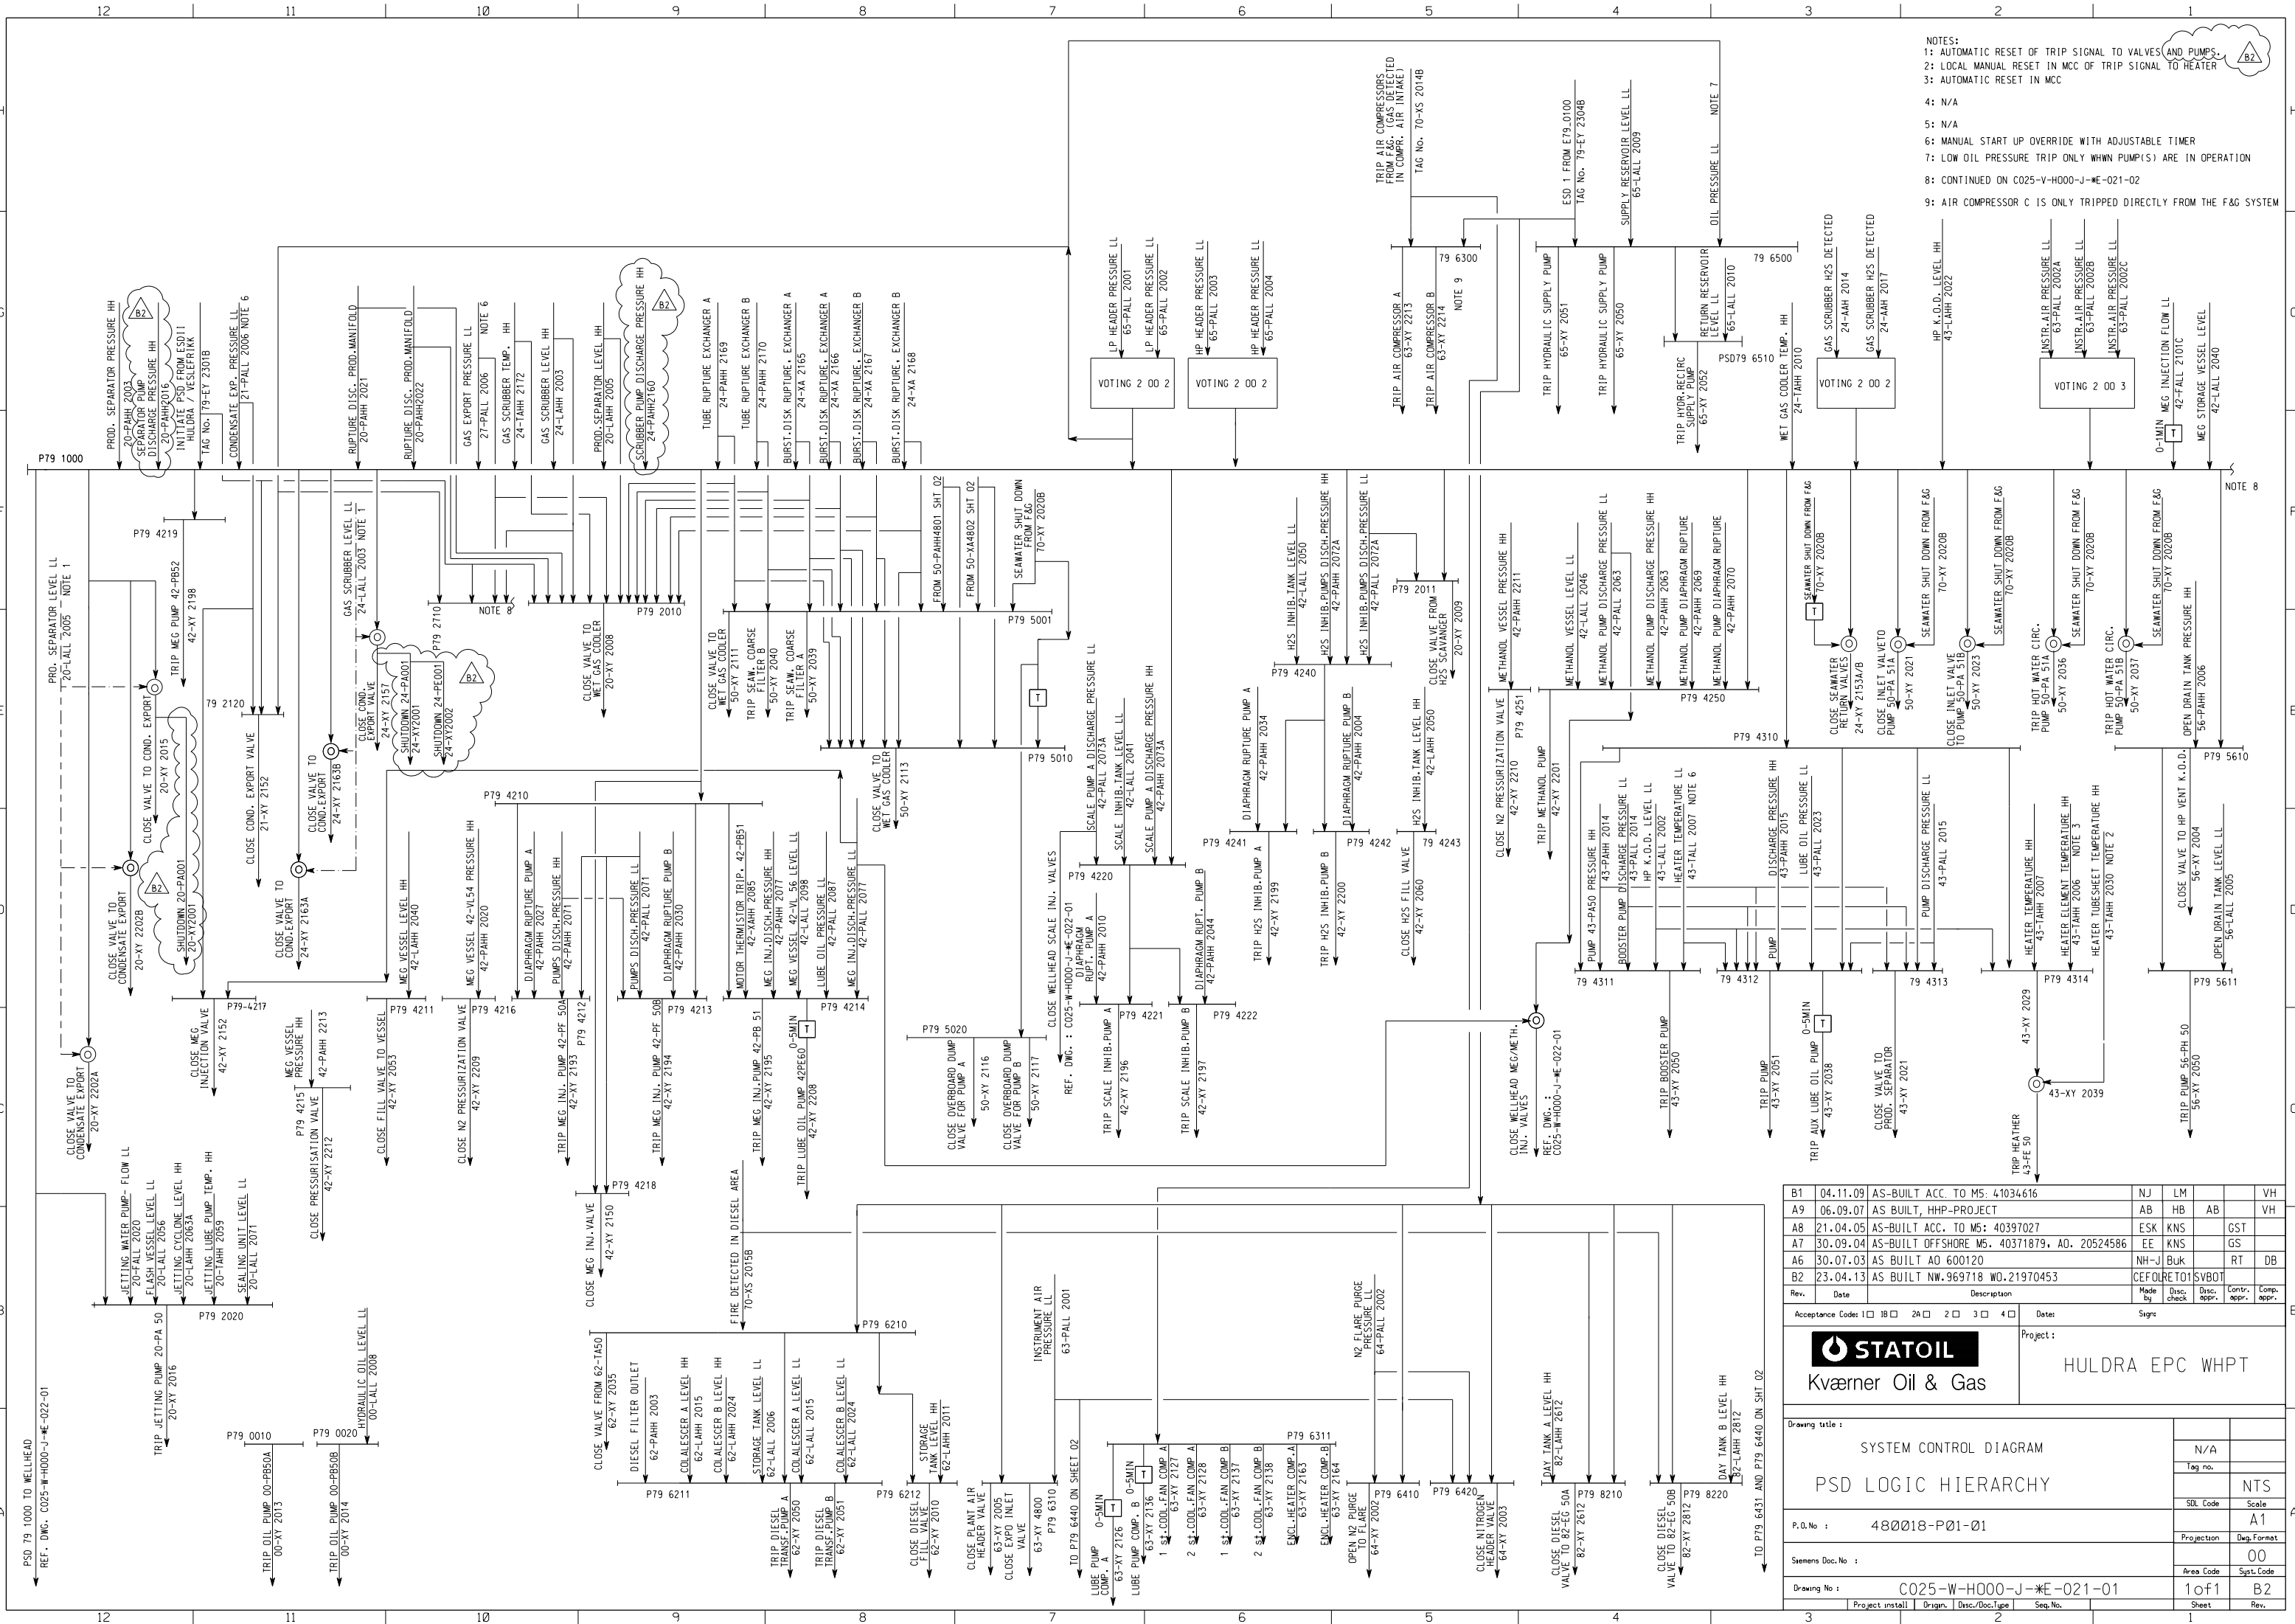

- NOTES:
- 1: AUTOMATIC RESET OF TRIP SIGNAL TO VALVES AND PUMPS.
 - 2: LOCAL MANUAL RESET IN MCC OF TRIP SIGNAL TO HEATER
 - 3: AUTOMATIC RESET IN MCC
 - 4: N/A
 - 5: N/A
 - 6: MANUAL START UP OVERRIDE WITH ADJUSTABLE TIMER
 - 7: LOW OIL PRESSURE TRIP ONLY WHEN PUMP(S) ARE IN OPERATION
 - 8: CONTINUED ON C025-W-H000-J-W-E-021-02
 - 9: AIR COMPRESSOR C IS ONLY TRIPPED DIRECTLY FROM THE F&G SYSTEM

B1	04.11.09	AS-BUILT ACC. TO M5: 41034616	NJ	LM		VH
A9	06.09.07	AS BUILT, HHP-PROJECT	AB	HB	AB	VH
A8	21.04.05	AS-BUILT ACC. TO M5: 40397027	ESK	KNS		GST
A7	30.09.04	AS-BUILT OFFSHORE M5. 40371879, AO. 20524586	EE	KNS		GS
A6	30.07.03	AS BUILT AO 600120	NH-J	Buk		RT DB
B2	23.04.13	AS BUILT NW.969718 WO.21970453	CEFOLE	RET01	SVBOT	
Rev.	Date	Description	Made by	Disc. check	Disc. appr.	Contr. appr.
Acceptance Codes: 1 ☐ 1B ☐ 2A ☐ 2 ☐ 3 ☐ 4 ☐			Sign:			
 STATOIL Kværner Oil & Gas			Project:			
			HULDRA EPC WHPT			
Drawing title:						
SYSTEM CONTROL DIAGRAM					N/A	
					Tag no.	
PSD LOGIC HIERARCHY					NTS	
					SOL Code	
P.O. No.: 480018-P01-01					Scale	
					A1	
Siemens Doc. No.:					Projection	
					Dwg.Format	
Drawing No.: C025-W-H000-J-WE-021-01					00	
					Area Code	
Sheet					Syst.Code	
					1 of 1	
3					B2	
					Rev.	
Project install			Origin		Disc./Doc.Type	
2			Seq.No.		1	