


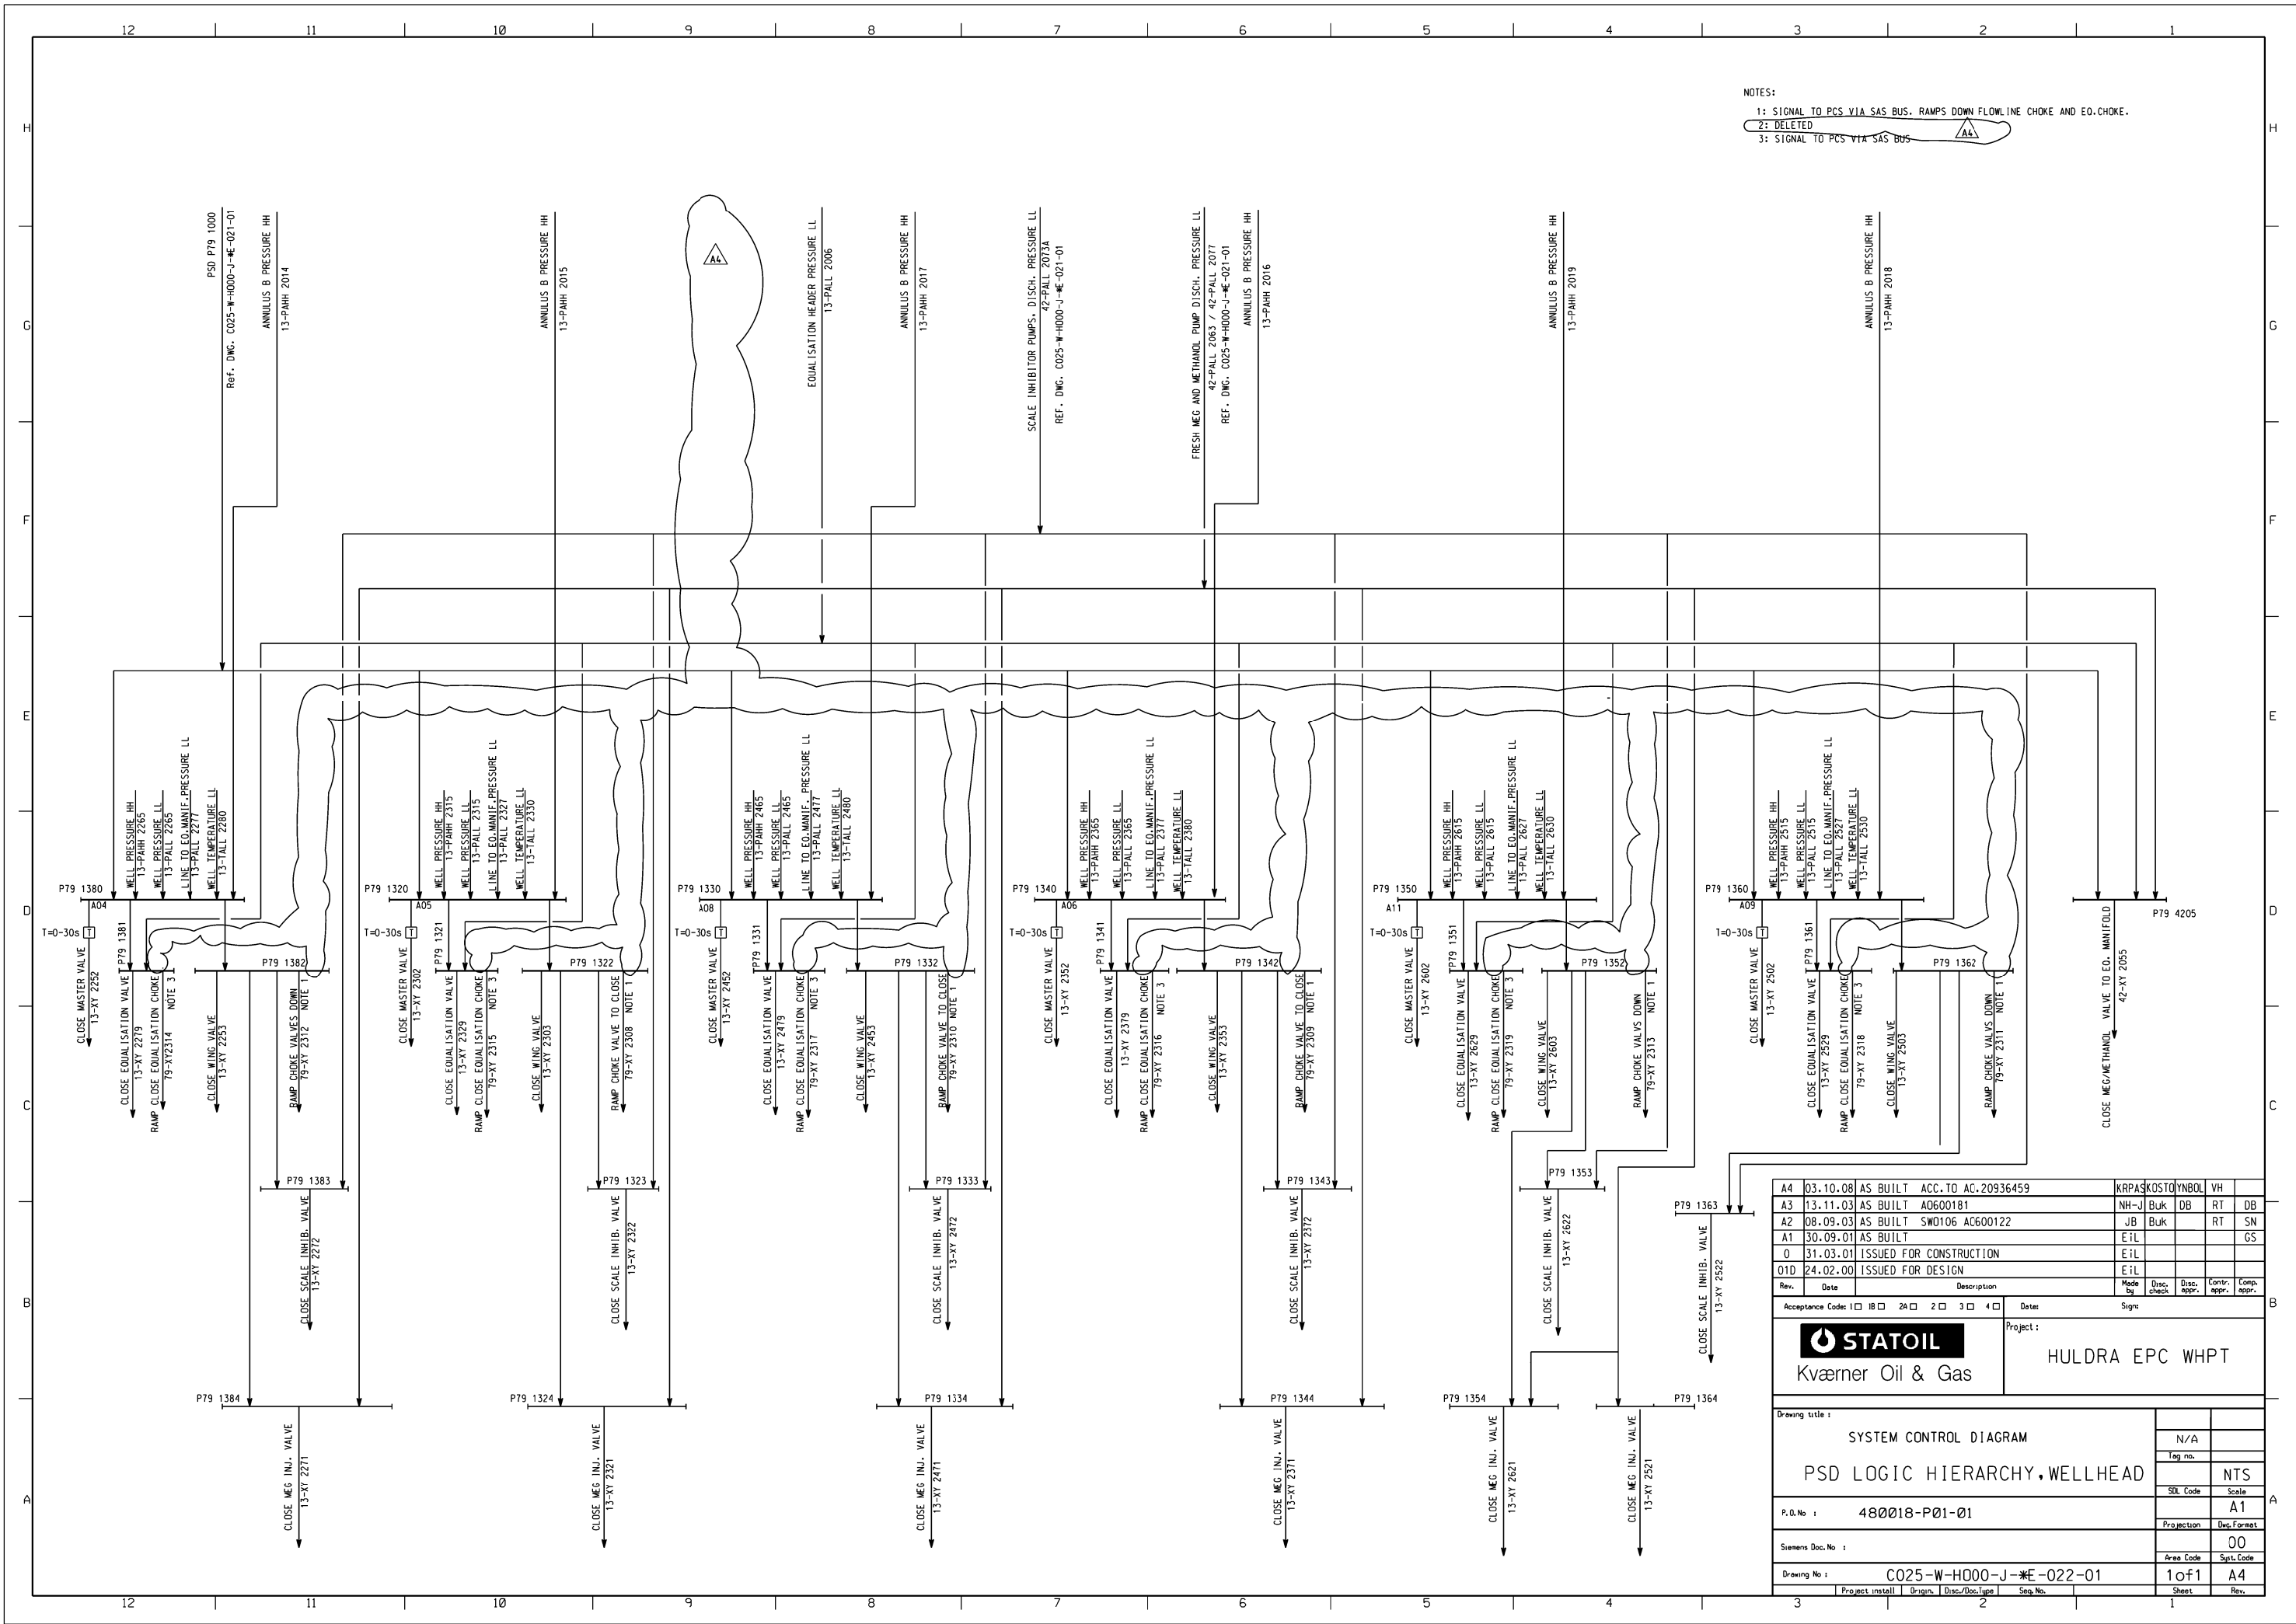

NOTES:
1: SIGNAL TO PCS VIA SAS BUS. RAMP DOWN FLOWLINE CHOKE AND EO.CHOKE.
2: DELETED
3: SIGNAL TO PCS VIA SAS BUS

A4	03.10.08	AS BUILT	ACC.TO AC.20936459	KRPASKOSTOYNBOL	VH			
A3	13.11.03	AS BUILT	A0600181	NH-J	Buk	DB	RT	DB
A2	08.09.03	AS BUILT	SW0106 AC600122	JB	Buk		RT	SN
A1	30.09.01	AS BUILT		EiL				GS
O	31.03.01	ISSUED FOR CONSTRUCTION		EiL				
01D	24.02.00	ISSUED FOR DESIGN		EiL				
Rev.	Date	Description		Made by	Disc. check	Disc. appr.	Contr. appr.	Comp. appr.
Acceptance Codes: I ☐ IB ☐ 2A ☐ 2 ☐ 3 ☐ 4 ☐				Signe				
 STATOIL Kværner Oil & Gas				Project : HULDRA EPC WHPT				
Drawing title :								
SYSTEM CONTROL DIAGRAM				N/A				
				Tag no.				
PSD LOGIC HIERARCHY, WELLHEAD				NTS				
				SDA Code		Scale		
P.O.No : 480018-P01-01				A1				
Siemens Doc.No :				Projection		Dwg.Format		
				00				
Drawing No : C025-W-H000-J-*E-022-01				Area Code		Supt.Code		
				1oF1		A4		
3				Project install		Origin		Disc./Doc.Type
2				Seq.No.		Sheet		Rev.
2				1				