


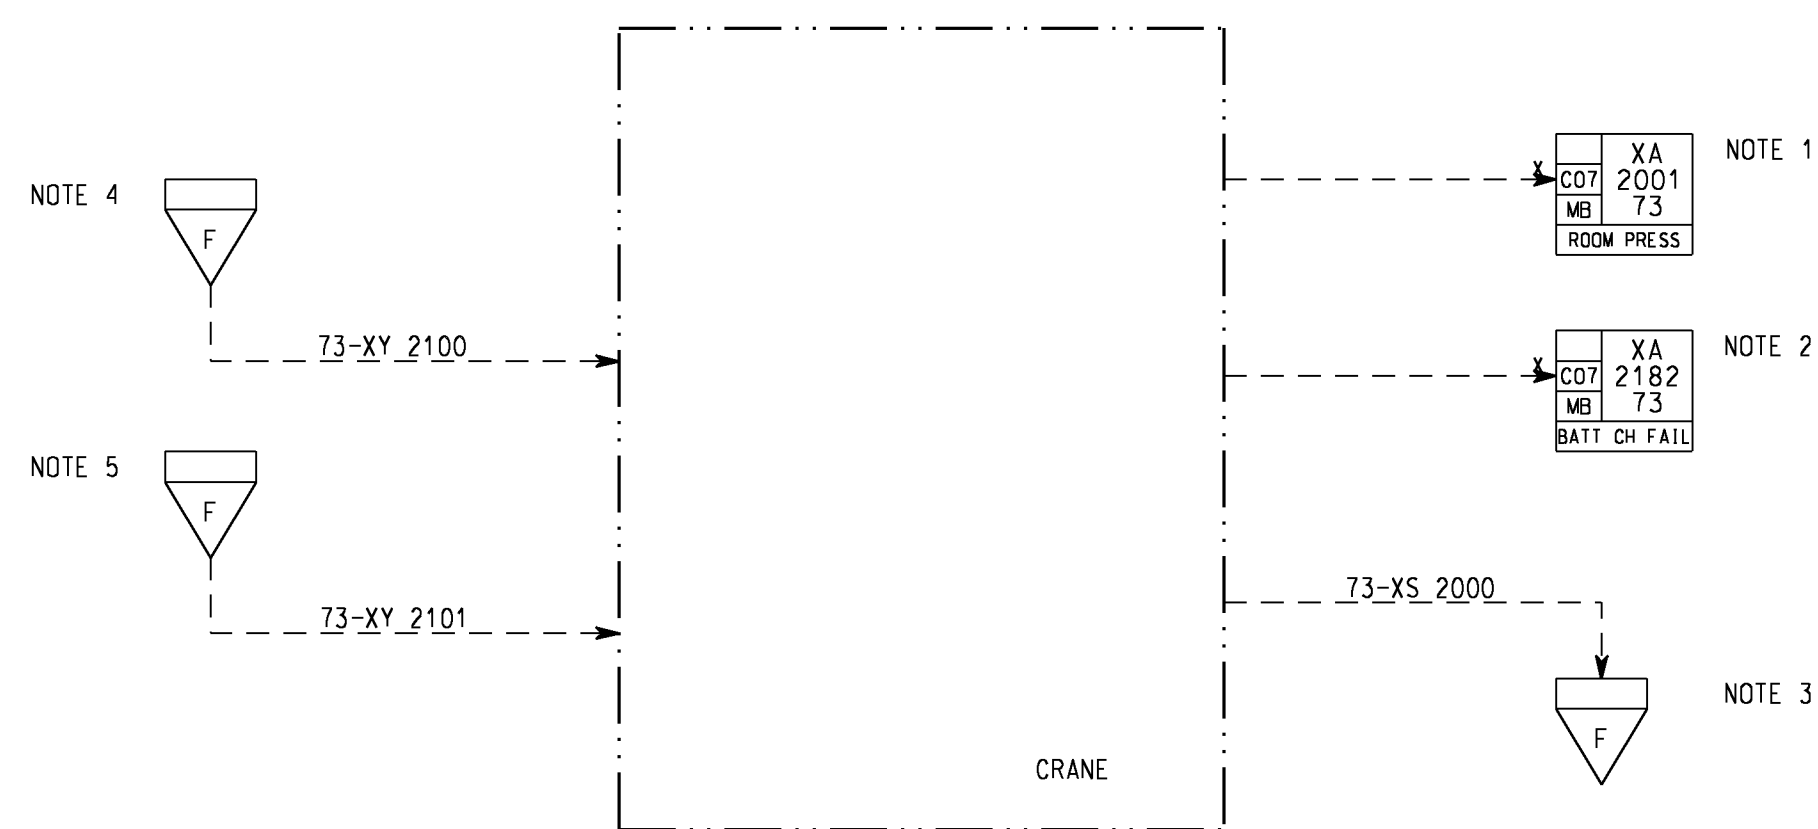

A1	30.09.01	AS BUILT				Eil			GS	
0	31.03.01	ISSUED FOR CONSTRUCTION				SNo				
Rev.	Date	Description				Made by	Disc. check	Disco. appr.	Contr. appr.	
Acceptance Codes: 1 ☐ 1B ☐ 2A ☐ 2 ☐ 3 ☐ 4 ☐						Date:				
 Kværner Oil & Gas						Project : HULDRA EPC WHPT				
Drawing title :										
SYSTEM CONTROL DIAGRAM MULTISYSTEMS										
							N/A			
							Tag no.			
							SDI Code		NTS	
P.O. No : 480018-P01-01									A1	
Siemens Doc. No :							Projection		Dwg. Format	
									00	
Drawing No : C025-W-H000-J- E -050-01							Area Code		Sysr. Code	
									1 of 1	
Project install		Origin		Disc./Doc.Type		Seq.No.		Sheet	Rev.	