


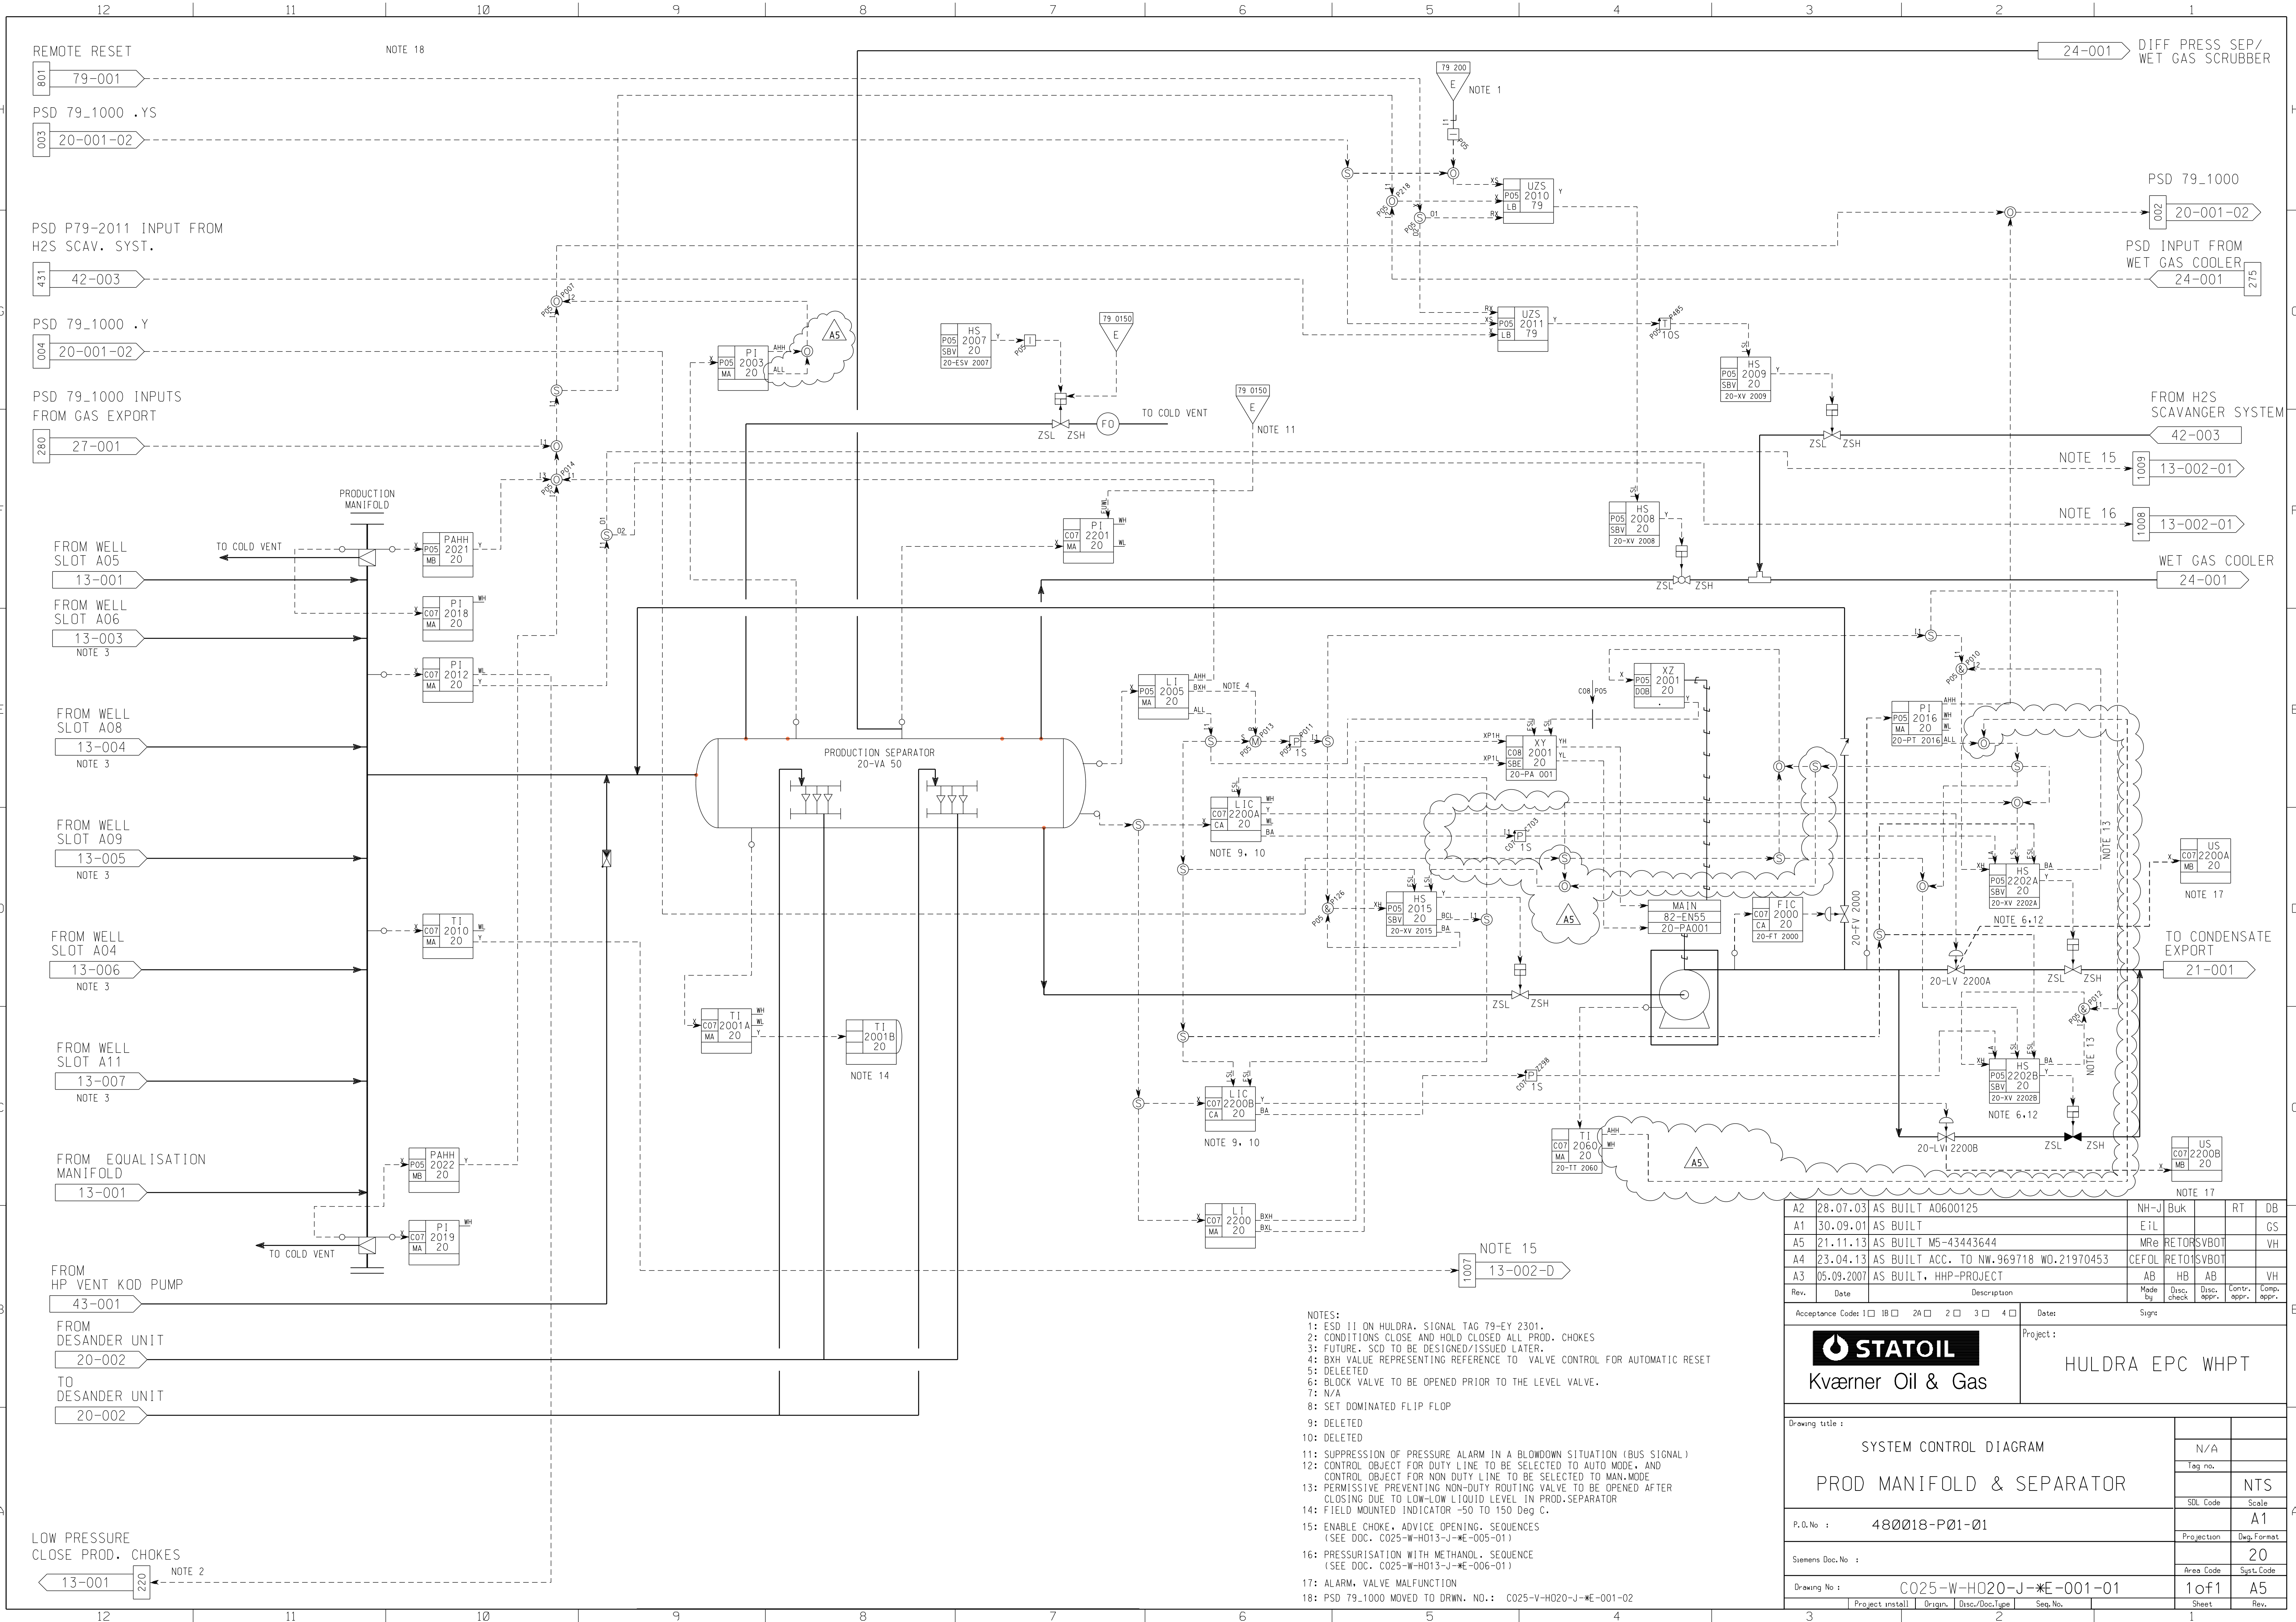

- NOTES:
- 1: ESD 11 ON HULDRA. SIGNAL TAG 79-EY 2301.
 - 2: CONDITIONS CLOSE AND HOLD CLOSED ALL PROD. CHOKES
 - 3: FUTURE. SCD TO BE DESIGNED/ISSUED LATER.
 - 4: BXH VALUE REPRESENTING REFERENCE TO VALVE CONTROL FOR AUTOMATIC RESET
 - 5: DELETED
 - 6: BLOCK VALVE TO BE OPENED PRIOR TO THE LEVEL VALVE.
 - 7: N/A
 - 8: SET DOMINATED FLIP FLOP
 - 9: DELETED
 - 10: DELETED
 - 11: SUPPRESSION OF PRESSURE ALARM IN A BLOWDOWN SITUATION (BUS SIGNAL)
 - 12: CONTROL OBJECT FOR DUTY LINE TO BE SELECTED TO AUTO MODE, AND CONTROL OBJECT FOR NON DUTY LINE TO BE SELECTED TO MAN.MODE
 - 13: PERMISSIVE PREVENTING NON-DUTY ROUTING VALVE TO BE OPENED AFTER CLOSING DUE TO LOW-LOW LIQUID LEVEL IN PROD.SEPARATOR
 - 14: FIELD MOUNTED INDICATOR -50 TO 150 Deg C.
 - 15: ENABLE CHOKE, ADVICE OPENING. SEQUENCES (SEE DOC. C025-W-H013-J-#E-005-01)
 - 16: PRESSURISATION WITH METHANOL. SEQUENCE (SEE DOC. C025-W-H013-J-#E-006-01)
 - 17: ALARM, VALVE MALFUNCTION
 - 18: PSD 79_1000 MOVED TO DRWN. NO.: C025-V-H020-J-#E-001-02

A2	28.07.03	AS BUILT A0600125	NH-J	Buk			RT	DB
A1	30.09.01	AS BUILT	EiL					GS
A5	21.11.13	AS BUILT M5-43443644	MRe	RETORSVBOT				VH
A4	23.04.13	AS BUILT ACC. TO NW.969718 WO.21970453	CEFOL	RET01SVBOT				
A3	05.09.2007	AS BUILT, HHP-PROJECT	AB	HB	AB			VH
Rev.	Date	Description	Mode by	Disc. check	Disc. appr.	Contr. appr.	Comp. appr.	
Acceptance Codes 1 ☐ 1B ☐ 2A ☐ 2 ☐ 3 ☐ 4 ☐			Sign:					
 STATOIL Kværner Oil & Gas			Project : HULDRA EPC WHPT					
Drawing title :								
SYSTEM CONTROL DIAGRAM PROD MANIFOLD & SEPARATOR								
						N/A		
						Tag no.		
						NTS		
P.O. No : 480018-P01-01						SOL Code		
						Scale		
Siemens Doc.No :						A1		
						Projection		
Drawing No : C025-W-H020-J- E -001-01						Dwg.Format		
						20		
						Area Code		
						Syst.Code		
						1 of 1		
						A5		
Project install			Origin			Disc./Doc.Type		
			Seq.No.			Sheet		
			2			1		