


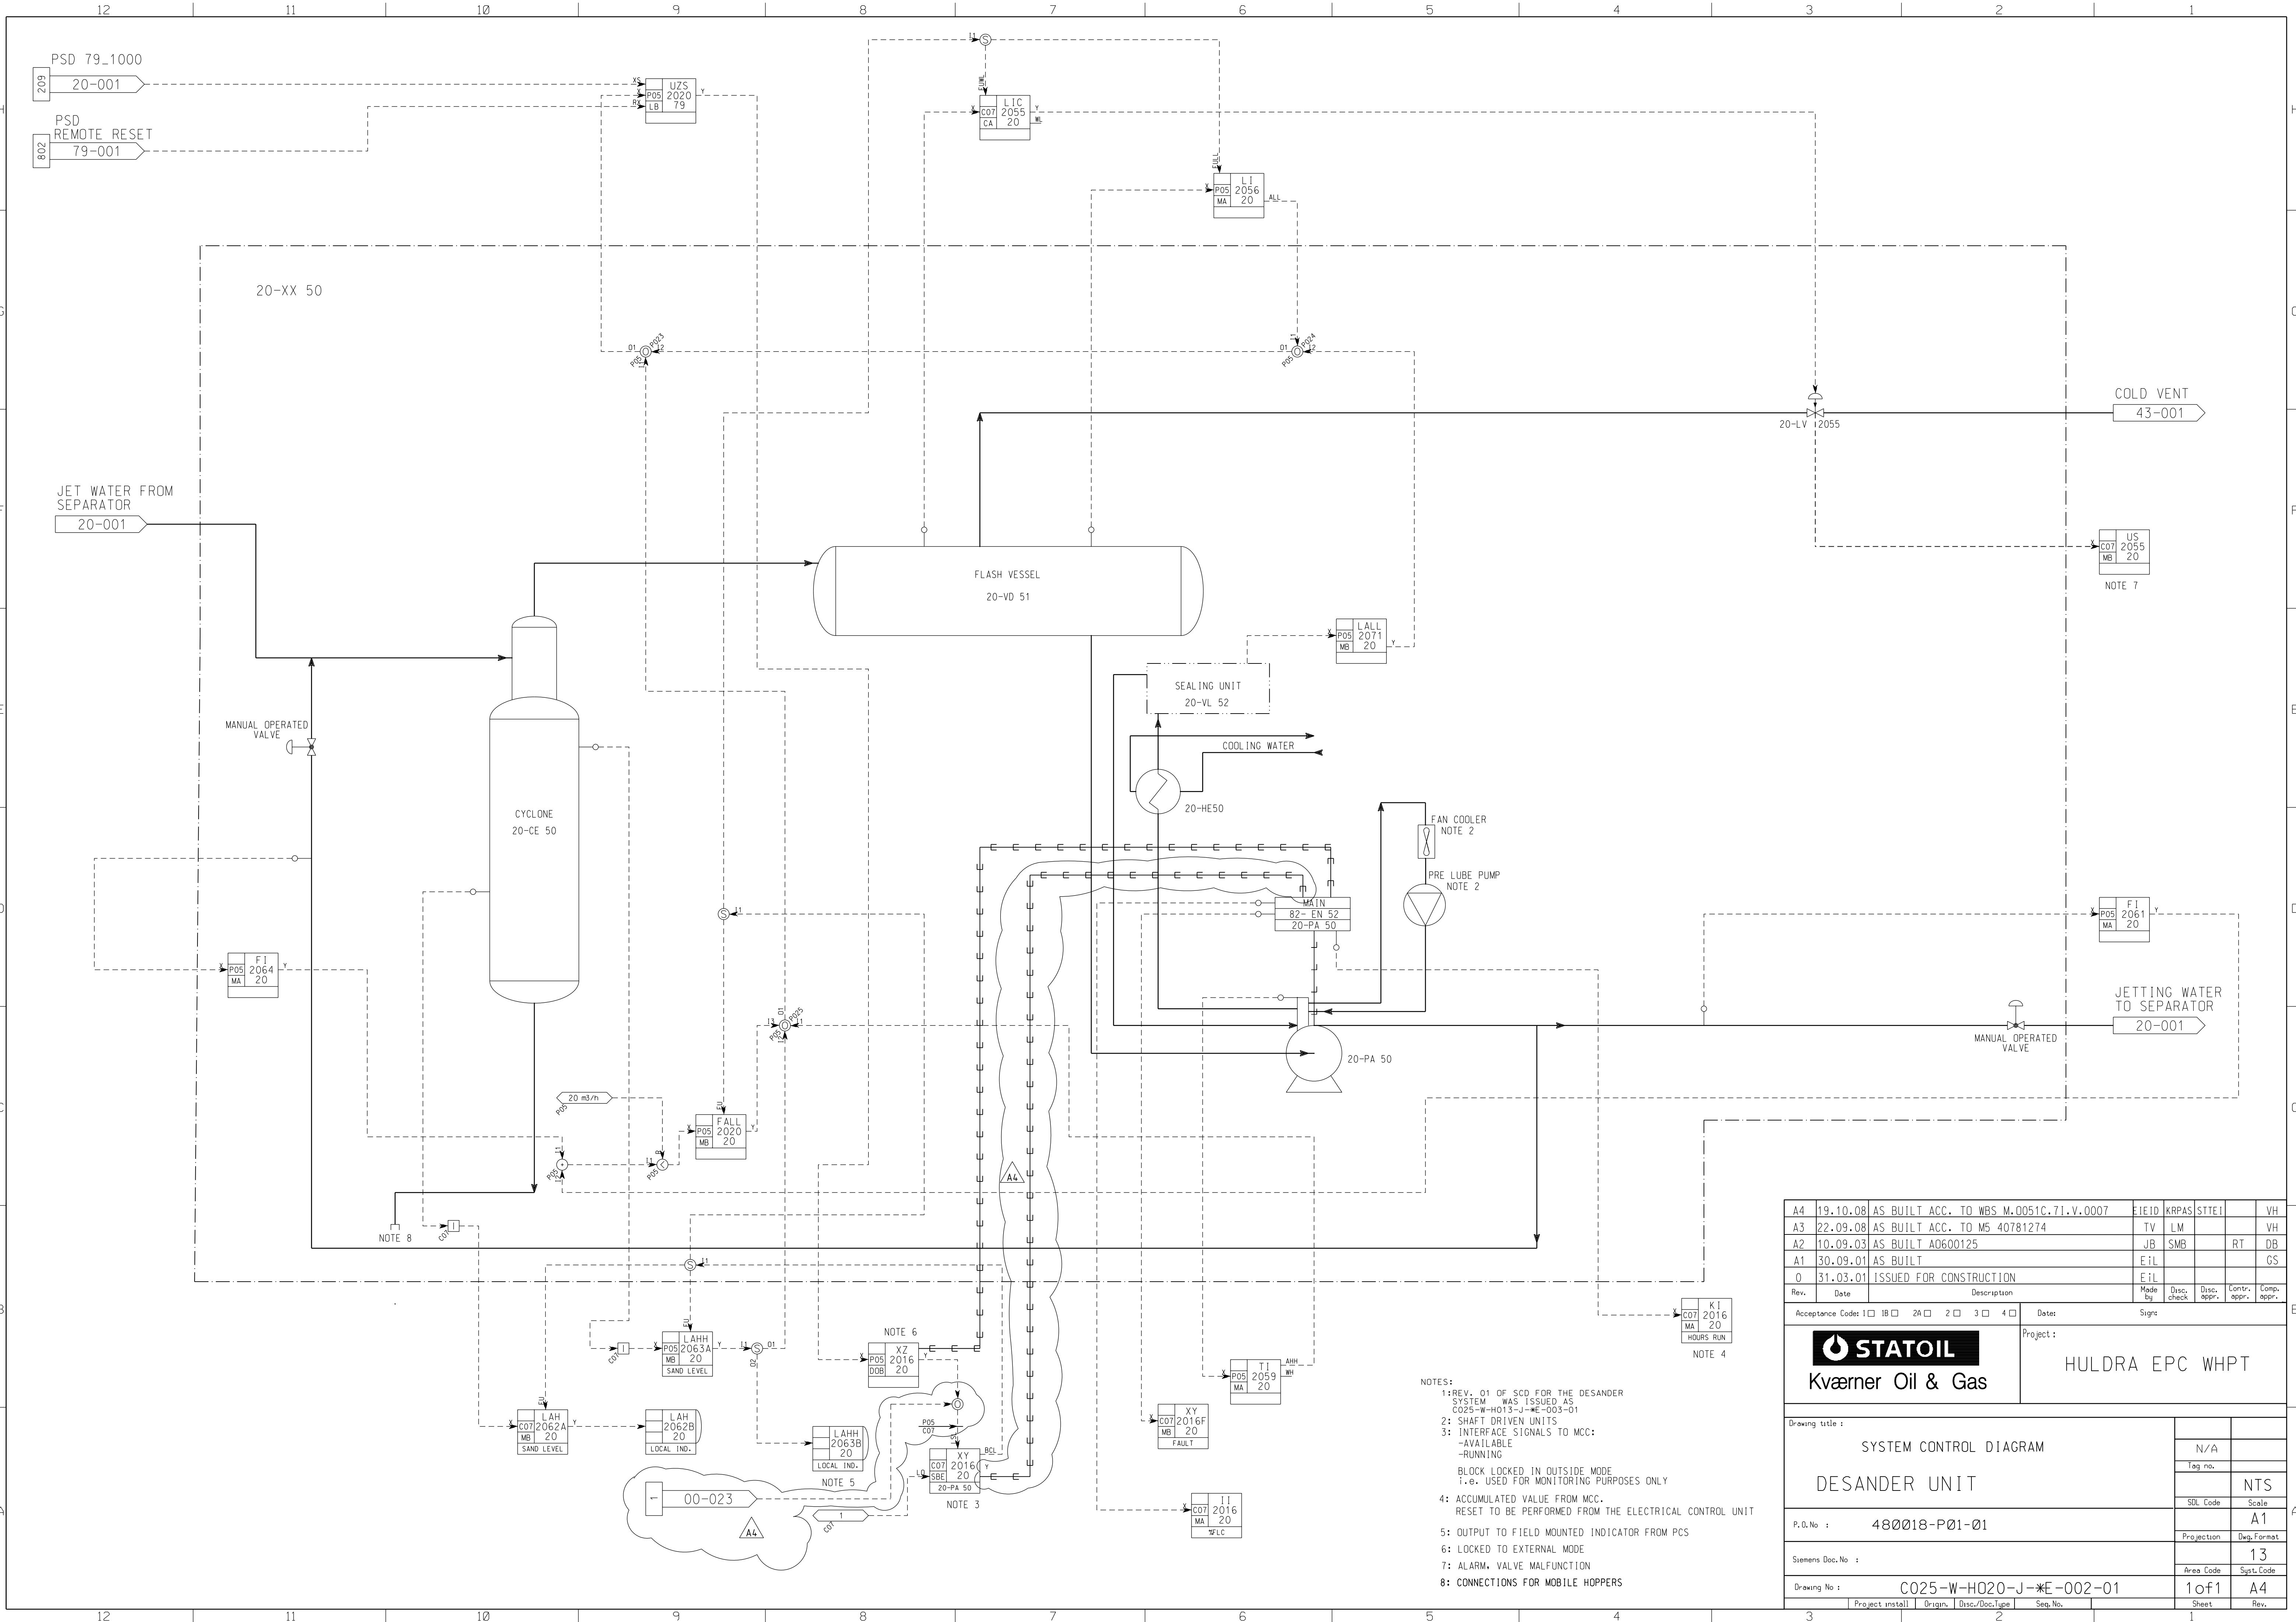

- NOTES:
- 1: REV. 01 OF SCD FOR THE DESANDER SYSTEM WAS ISSUED AS C025-W-H013-J-ME-003-01
 - 2: SHAFT DRIVEN UNITS
 - 3: INTERFACE SIGNALS TO MCC:
 - AVAILABLE
 - RUNNING
 - BLOCK LOCKED IN OUTSIDE MODE i.e. USED FOR MONITORING PURPOSES ONLY
 - 4: ACCUMULATED VALUE FROM MCC. RESET TO BE PERFORMED FROM THE ELECTRICAL CONTROL UNIT
 - 5: OUTPUT TO FIELD MOUNTED INDICATOR FROM PCS
 - 6: LOCKED TO EXTERNAL MODE
 - 7: ALARM: VALVE MALFUNCTION
 - 8: CONNECTIONS FOR MOBILE HOPPERS

A4	19.10.08	AS BUILT ACC. TO WBS M.0051C.71.V.0007	E I E I D	K R P A S	S T E I		V H	
A3	22.09.08	AS BUILT ACC. TO M5 40781274	T V	L M			V H	
A2	10.09.03	AS BUILT A0600125	J B	S M B		R T	D B	
A1	30.09.01	AS BUILT	E i l				G S	
0	31.03.01	ISSUED FOR CONSTRUCTION	E i l					
Rev.	Date	Description	Mode by	Disc. check	Disc. appr.	Contr. appr.	Comp. appr.	
Acceptance Codes 1 ☐ 1B ☐ 2A ☐ 2 ☐ 3 ☐ 4 ☐			Date: _____ Sign: _____					
 STATOIL Kværner Oil & Gas			Project : HULDRA EPC WHPT					
Drawing title : SYSTEM CONTROL DIAGRAM DESANDER UNIT								
P.O. No : 480018-P01-01						N/A		
						Tag no.		
						NTS		
						SOL Code Scale		
Siemens Doc. No : _____						A1		
						Projection Desig.Format		
Drawing No : C025-W-H020-J-✱E-002-01						13		
						Area Code Syst.Code		
Drawing No : _____						1 of 1		
Project install		Origin	Disc./Doc.Type	Seq.No.	Sheet			Rev.