


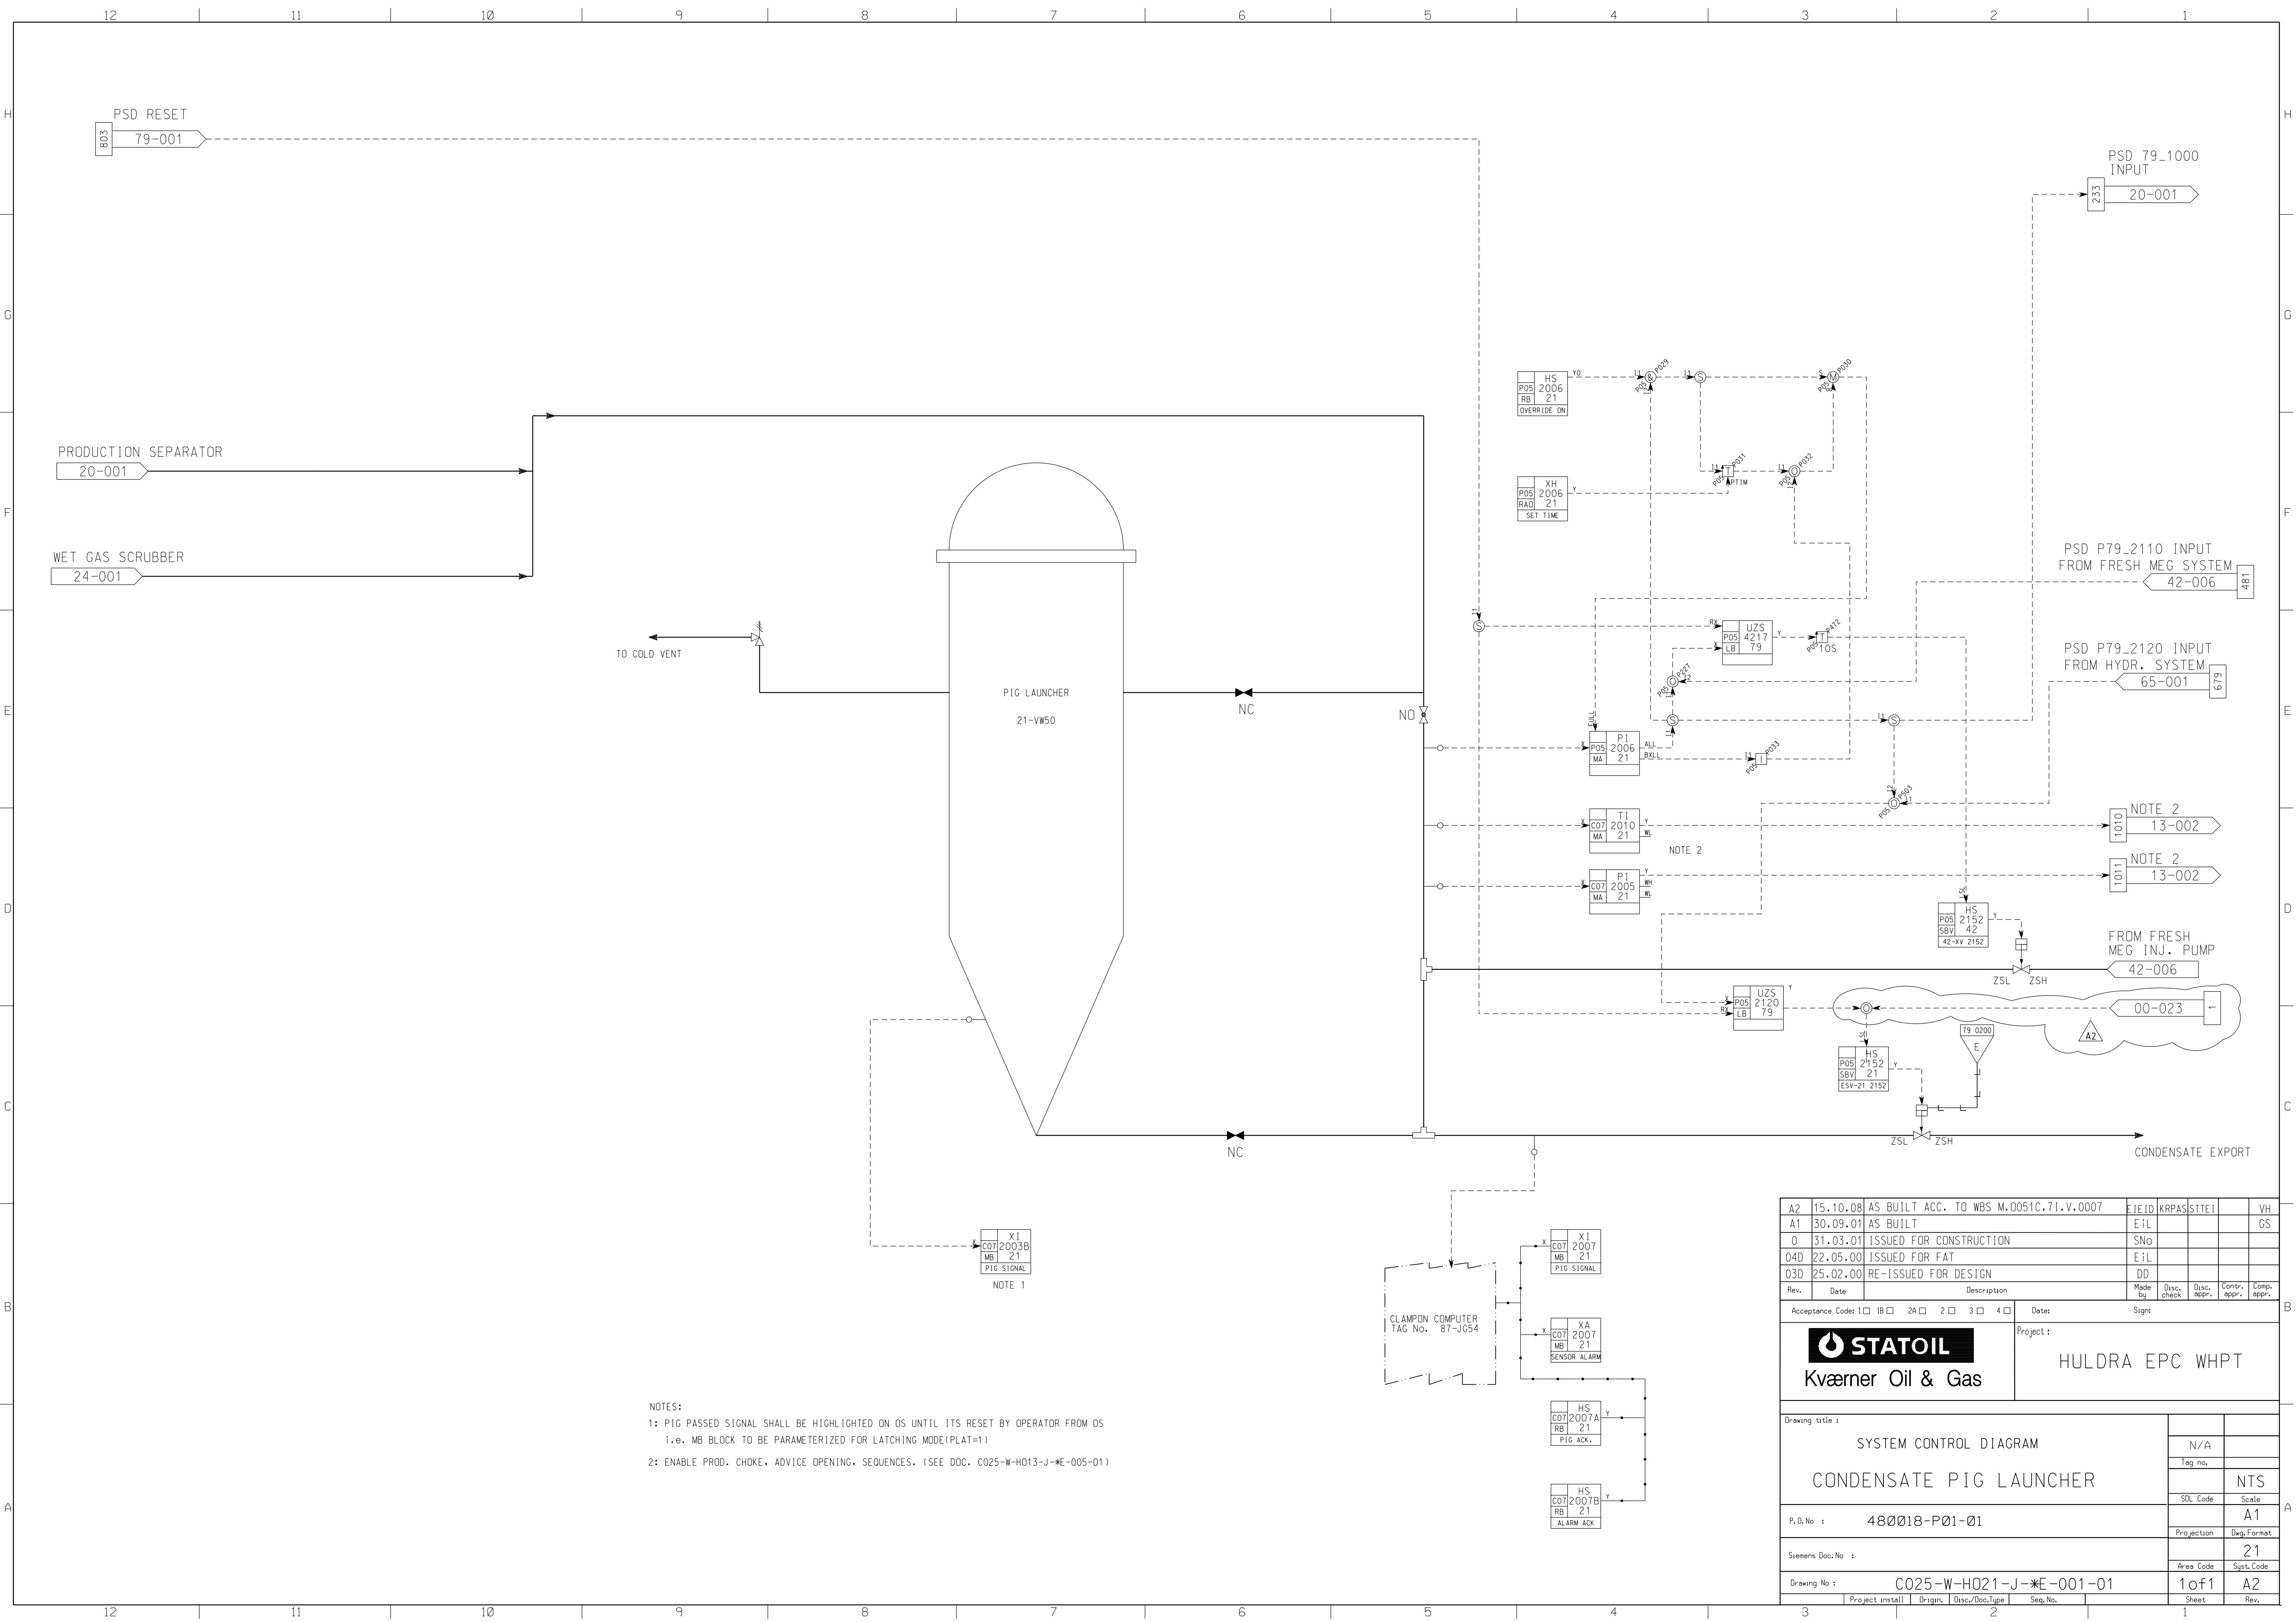

NOTES:
1: PIG PASSED SIGNAL SHALL BE HIGHLIGHTED ON OS UNTIL ITS RESET BY OPERATOR FROM OS
i.e. MB BLOCK TO BE PARAMETERIZED FOR LATCHING MODE(PLAT=1)
2: ENABLE PROD. CHOKE, ADVICE OPENING, SEQUENCES. (SEE DOC. C025-W-H013-J-#E-005-01)

A2	15.10.08	AS BUILT ACC. TO WBS M.0051C.71.V.0007	EIEID	KRPAS	STIEI		VH
A1	30.09.01	AS BUILT	EiL				GS
0	31.03.01	ISSUED FOR CONSTRUCTION	SNo				
04D	22.05.00	ISSUED FOR FAT	EiL				
03D	25.02.00	RE-ISSUED FOR DESIGN	DD				
Rev.	Date	Description	Mode by	Disc. check	Disc. appr.	Contr. appr.	Comp. appr.
Acceptance Codes 1 ☐ 1B ☐ 2A ☐ 2 ☐ 3 ☐ 4 ☐			Sign:				
 STATOIL Kværner Oil & Gas			Project : HULDRA EPC WHPT				
Drawing title :							
SYSTEM CONTROL DIAGRAM CONDENSATE PIG LAUNCHER				N/A			
				Tag no.			
				SQL Code		NTS	
				Scale		A1	
P.O.No : 480018-P01-01				Projection		Dwg.Format	
Siemens Doc.No :						21	
Drawing No : C025-W-H021-J-#E-001-01				Area Code		Syst.Code	
				1 of 1		A2	
Project install		Origin	Disc./Doc.Type	Seq.No.	Sheet		Rev.