


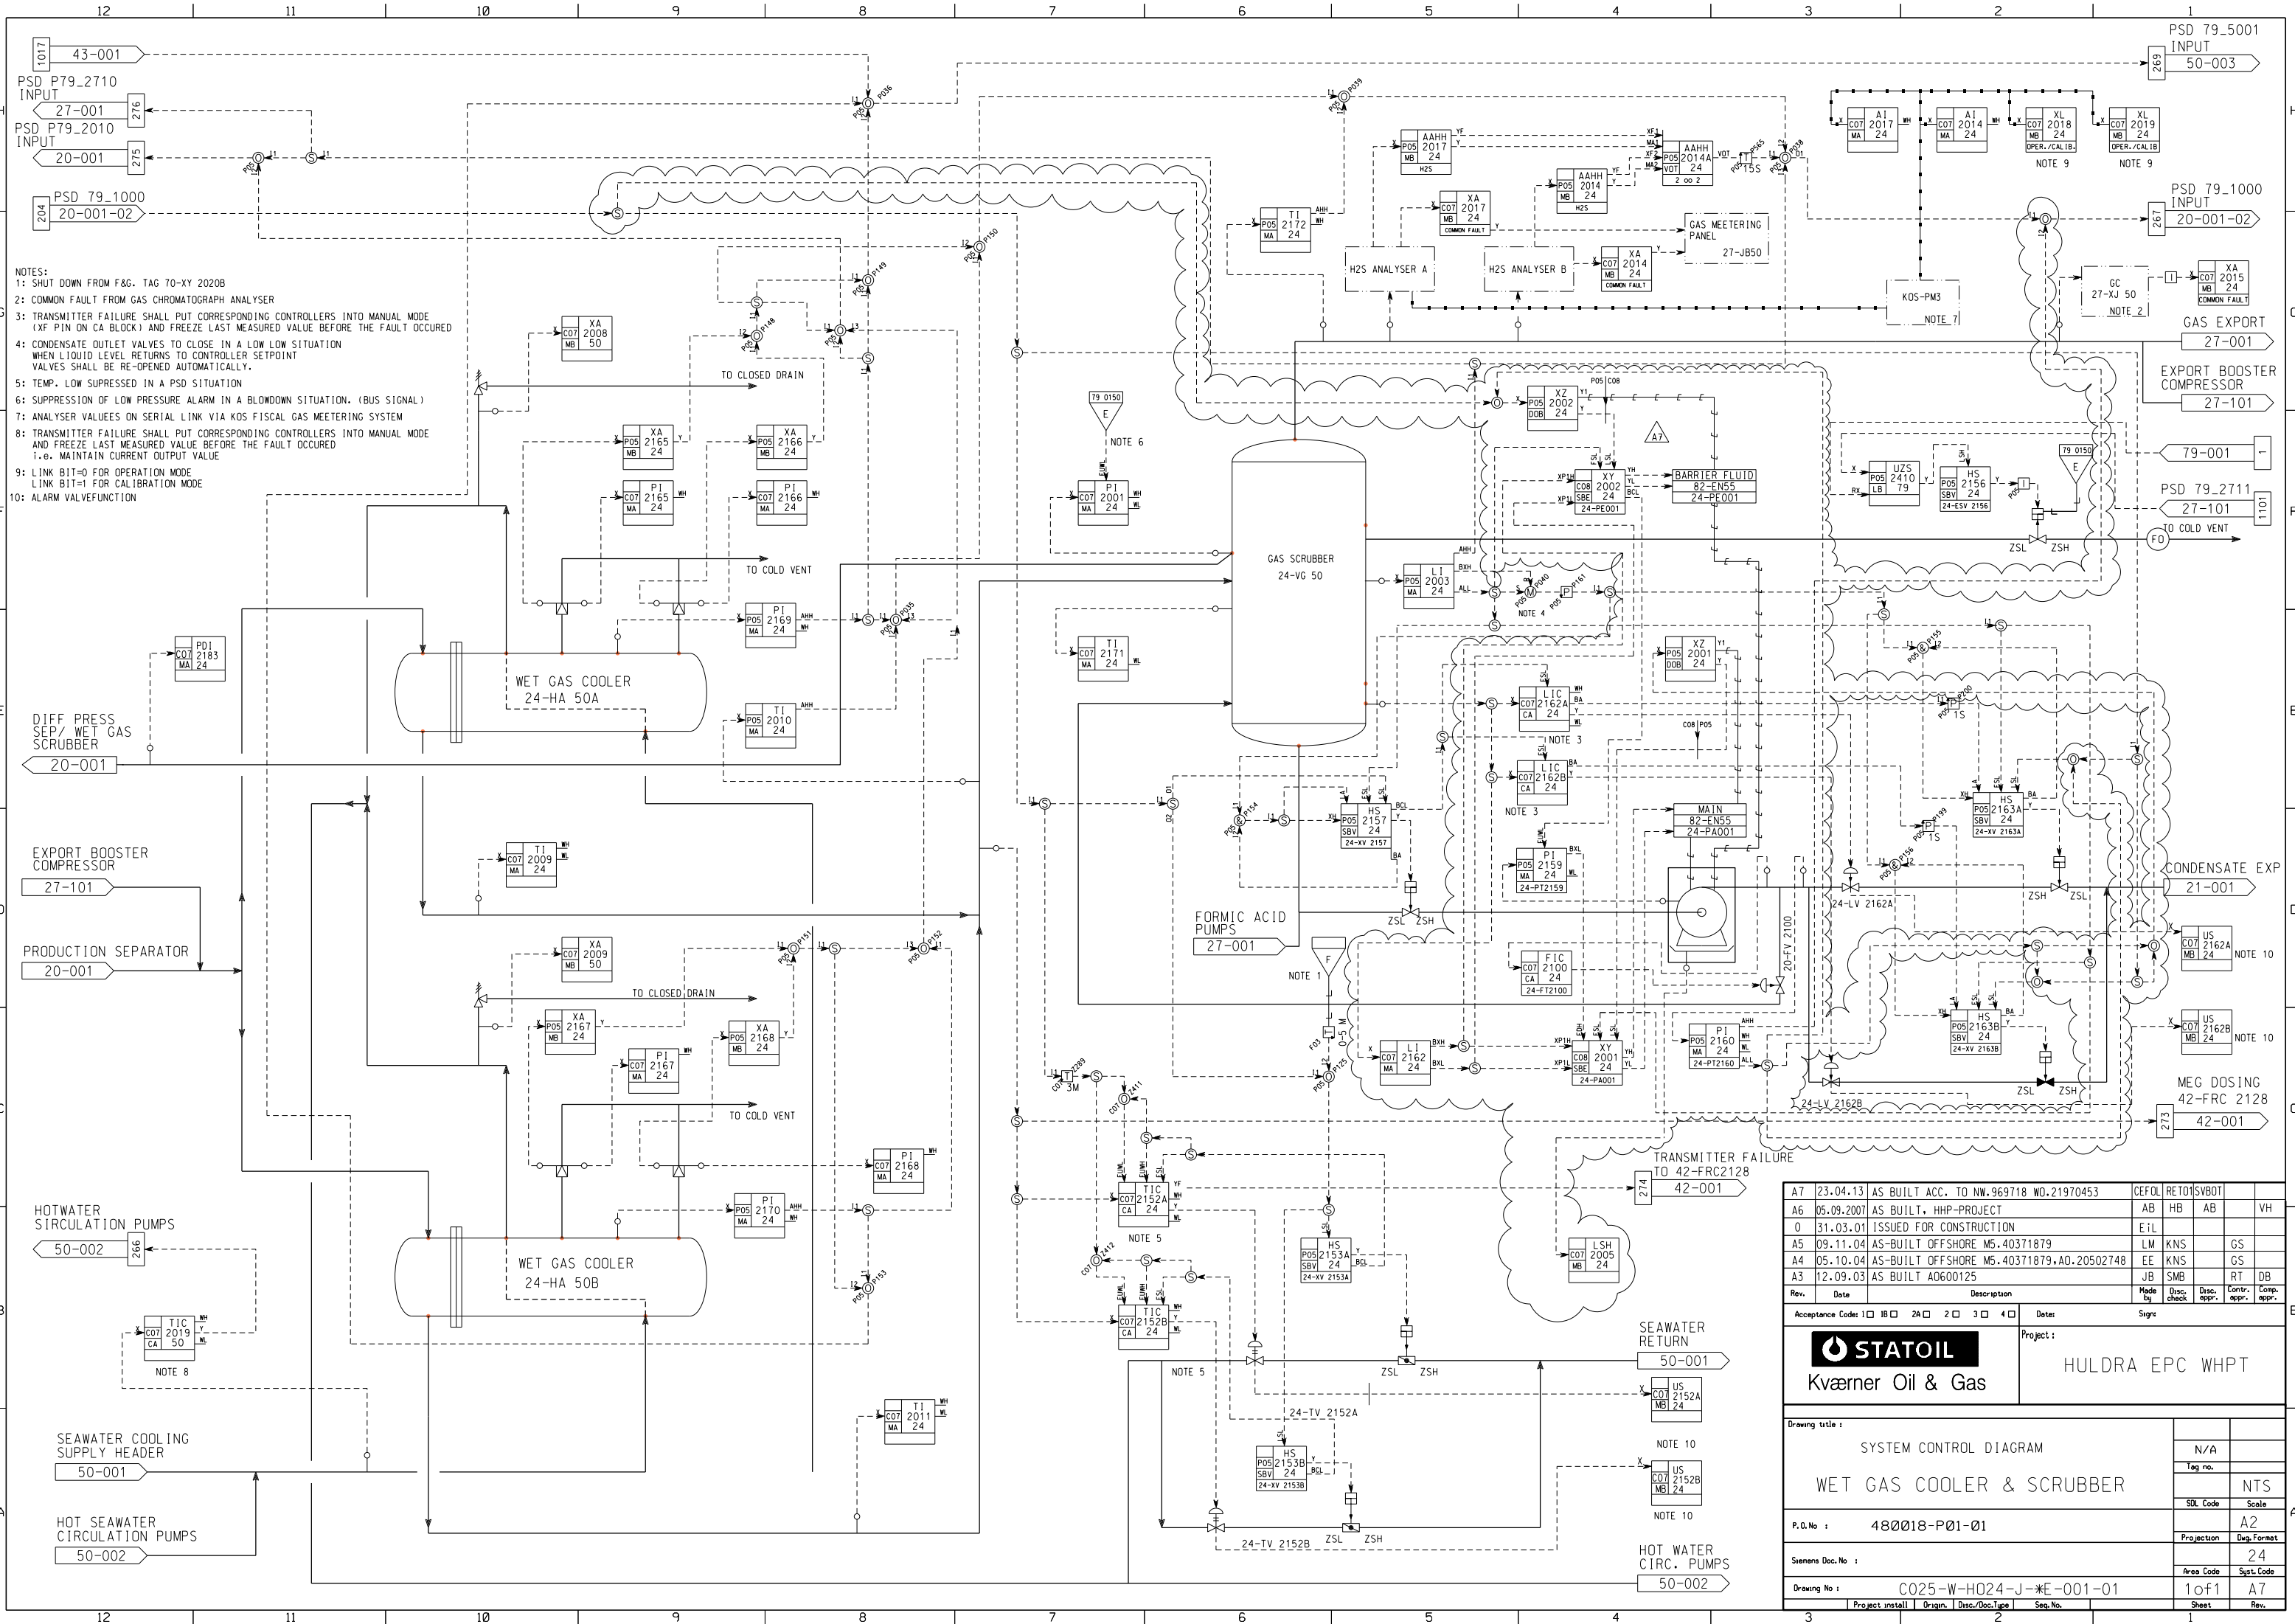

- NOTES:
- 1: SHUT DOWN FROM F&G. TAG 70-XY 2020B
 - 2: COMMON FAULT FROM GAS CHROMATOGRAPH ANALYSER
 - 3: TRANSMITTER FAILURE SHALL PUT CORRESPONDING CONTROLLERS INTO MANUAL MODE (XF PIN ON CA BLOCK) AND FREEZE LAST MEASURED VALUE BEFORE THE FAULT OCCURED
 - 4: CONDENSATE OUTLET VALVES TO CLOSE IN A LOW LOW SITUATION WHEN LIQUID LEVEL RETURNS TO CONTROLLER SETPOINT VALVES SHALL BE RE-OPENED AUTOMATICALLY.
 - 5: TEMP. LOW SUPPRESSED IN A PSD SITUATION
 - 6: SUPPRESSION OF LOW PRESSURE ALARM IN A BLOWDOWN SITUATION. (BUS SIGNAL)
 - 7: ANALYSER VALUEES ON SERIAL LINK VIA KOS FISCAL GAS MEETING SYSTEM
 - 8: TRANSMITTER FAILURE SHALL PUT CORRESPONDING CONTROLLERS INTO MANUAL MODE AND FREEZE LAST MEASURED VALUE BEFORE THE FAULT OCCURED i.e. MAINTAIN CURRENT OUTPUT VALUE
 - 9: LINK BIT=0 FOR OPERATION MODE
LINK BIT=1 FOR CALIBRATION MODE
 - 10: ALARM VALVEFUNCTION

A7	23.04.13	AS BUILT ACC. TO NW.969718 WD.21970453	CEFOL	RET01SVB01		
A6	05.09.2007	AS BUILT. HHP-PROJECT	AB	HB	AB	VH
0	31.03.01	ISSUED FOR CONSTRUCTION	EIL			
A5	09.11.04	AS-BUILT OFFSHORE M5.40371879	LM	KNS		GS
A4	05.10.04	AS-BUILT OFFSHORE M5.40371879.A0.20502748	EE	KNS		GS
A3	12.09.03	AS BUILT A0600125	JB	SMB		RT DB
Rev.	Date	Description	Mode	Disc. check	Disc. appr.	Contr. appr.
Acceptance Code 1 0 1B 0 2A 0 2 0 3 0 4 0			Sign			
STATOIL			Project:			
Kværner Oil & Gas			HULDRA EPC WHPT			
Drawing title:						
SYSTEM CONTROL DIAGRAM						N/A
WET GAS COOLER & SCRUBBER						Tag no. NTS
P.O.No : 480018-P01-01						Scale A2
Siemens Doc.No :						Projection 24
Drawing No : C025-W-H024-J-NE-001-01						Area Code 24
Project install						1 of 1
Origin						Sheet A7
Disc/Doc.Type						Rev.
Seq.No						