


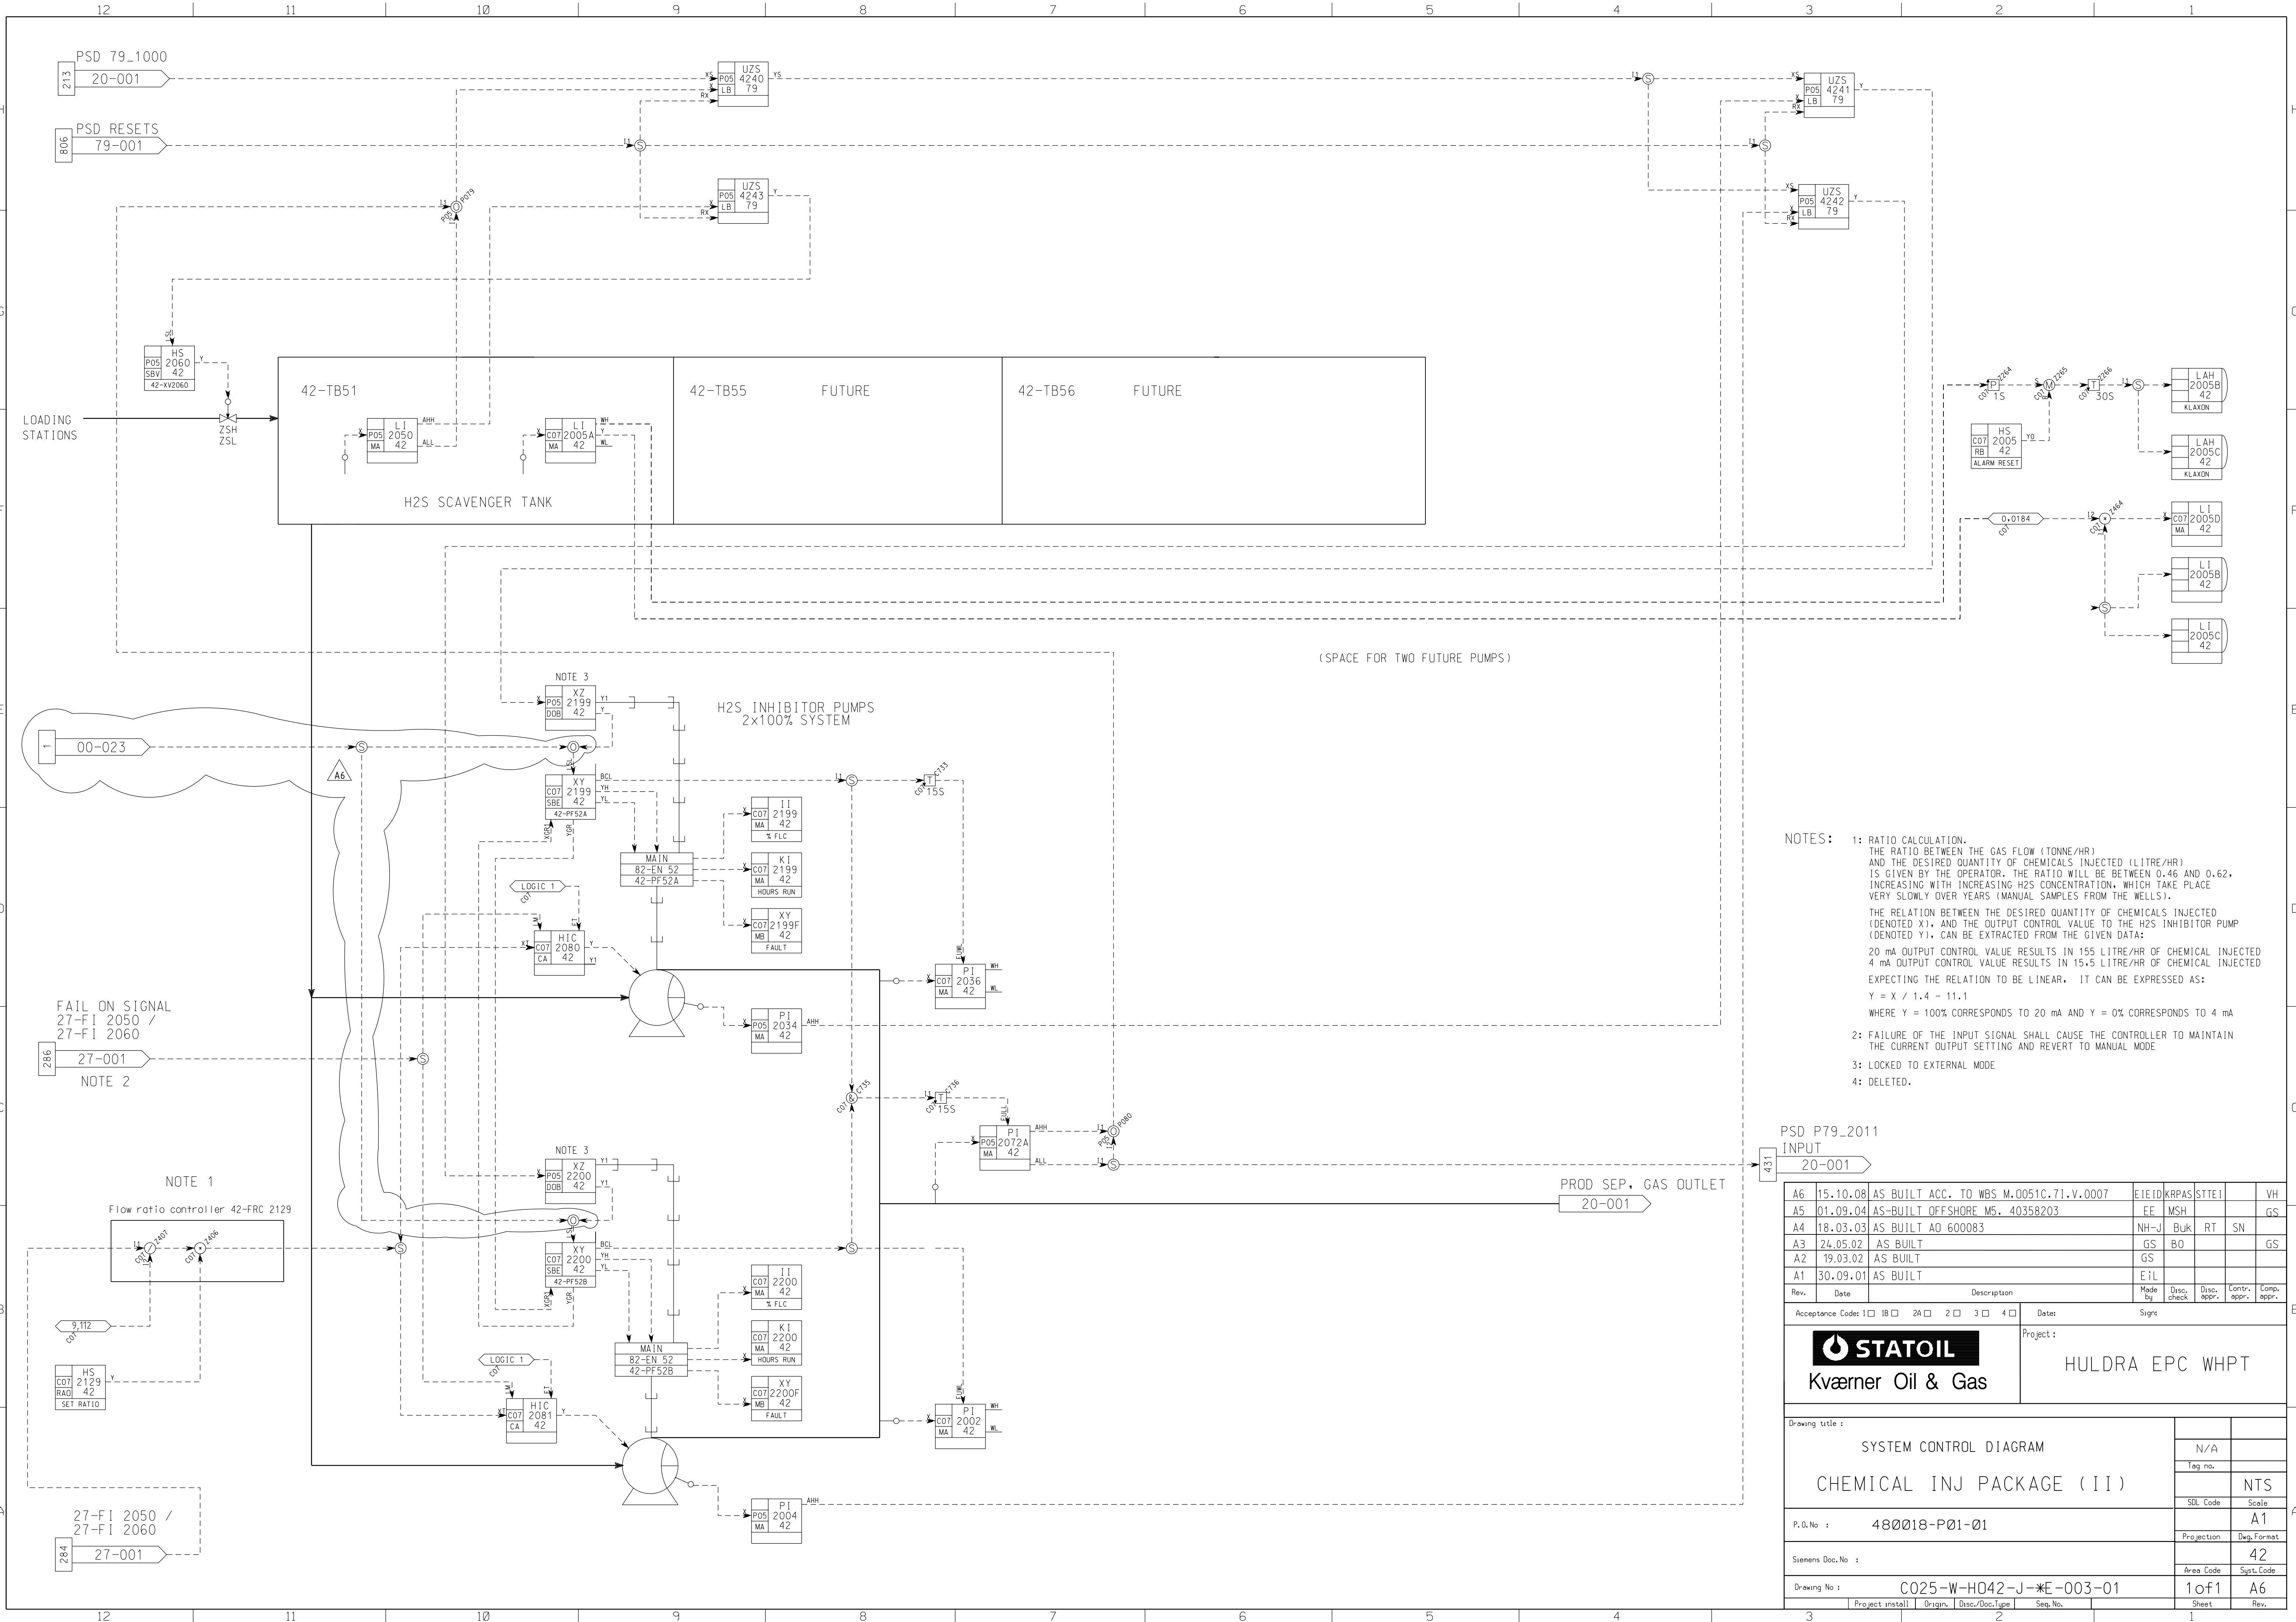

NOTES:

1: RATIO CALCULATION.  
THE RATIO BETWEEN THE GAS FLOW (TONNE/HR) AND THE DESIRED QUANTITY OF CHEMICALS INJECTED (LITRE/HR) IS GIVEN BY THE OPERATOR. THE RATIO WILL BE BETWEEN 0.46 AND 0.62, INCREASING WITH INCREASING H2S CONCENTRATION, WHICH TAKE PLACE VERY SLOWLY OVER YEARS (MANUAL SAMPLES FROM THE WELLS).  
THE RELATION BETWEEN THE DESIRED QUANTITY OF CHEMICALS INJECTED (DENOTED X), AND THE OUTPUT CONTROL VALUE TO THE H2S INHIBITOR PUMP (DENOTED Y), CAN BE EXTRACTED FROM THE GIVEN DATA:  
20 mA OUTPUT CONTROL VALUE RESULTS IN 155 LITRE/HR OF CHEMICAL INJECTED  
4 mA OUTPUT CONTROL VALUE RESULTS IN 15.5 LITRE/HR OF CHEMICAL INJECTED  
EXPECTING THE RELATION TO BE LINEAR, IT CAN BE EXPRESSED AS:  
$$Y = X / 1.4 - 11.1$$
  
WHERE Y = 100% CORRESPONDS TO 20 mA AND Y = 0% CORRESPONDS TO 4 mA

2: FAILURE OF THE INPUT SIGNAL SHALL CAUSE THE CONTROLLER TO MAINTAIN THE CURRENT OUTPUT SETTING AND REVERT TO MANUAL MODE

3: LOCKED TO EXTERNAL MODE

4: DELETED.

|                               |          |                                        |                |             |             |
|-------------------------------|----------|----------------------------------------|----------------|-------------|-------------|
| PSD P79_2011                  |          | INPUT                                  |                | 20-001      |             |
| A6                            | 15.10.08 | AS BUILT ACC. TO WBS M.0051C.71.V.0007 | EIEID          | KRPAS       | STTEI       |
| A5                            | 01.09.04 | AS-BUILT OFFSHORE M5. 40358203         | EE             | MSH         |             |
| A4                            | 18.03.03 | AS BUILT AO 600083                     | NH-J           | Buk         | RT          |
| A3                            | 24.05.02 | AS BUILT                               | GS             | BO          |             |
| A2                            | 19.03.02 | AS BUILT                               | GS             |             |             |
| A1                            | 30.09.01 | AS BUILT                               | EIL            |             |             |
| Rev.                          | Date     | Description                            | Mode by        | Disc. check | Disc. appr. |
| Acceptance Code 1 0B 2A 2 3 4 |          | Signe                                  |                |             |             |
| Project :                     |          | HULDRA EPC WHPT                        |                |             |             |
| Drawing title :               |          | SYSTEM CONTROL DIAGRAM                 |                |             |             |
| P.O.No :                      |          | 480018-P01-01                          |                |             |             |
| Siemens Doc.No :              |          | 42                                     |                |             |             |
| Drawing No :                  |          | C025-W-H042-J-E-003-01                 |                |             |             |
| Project install               |          | Origin                                 | Disc./Doc.Type | Seq.No      |             |
| Sheet                         |          | 1 of 1                                 |                |             |             |
| Rev.                          |          | A6                                     |                |             |             |