


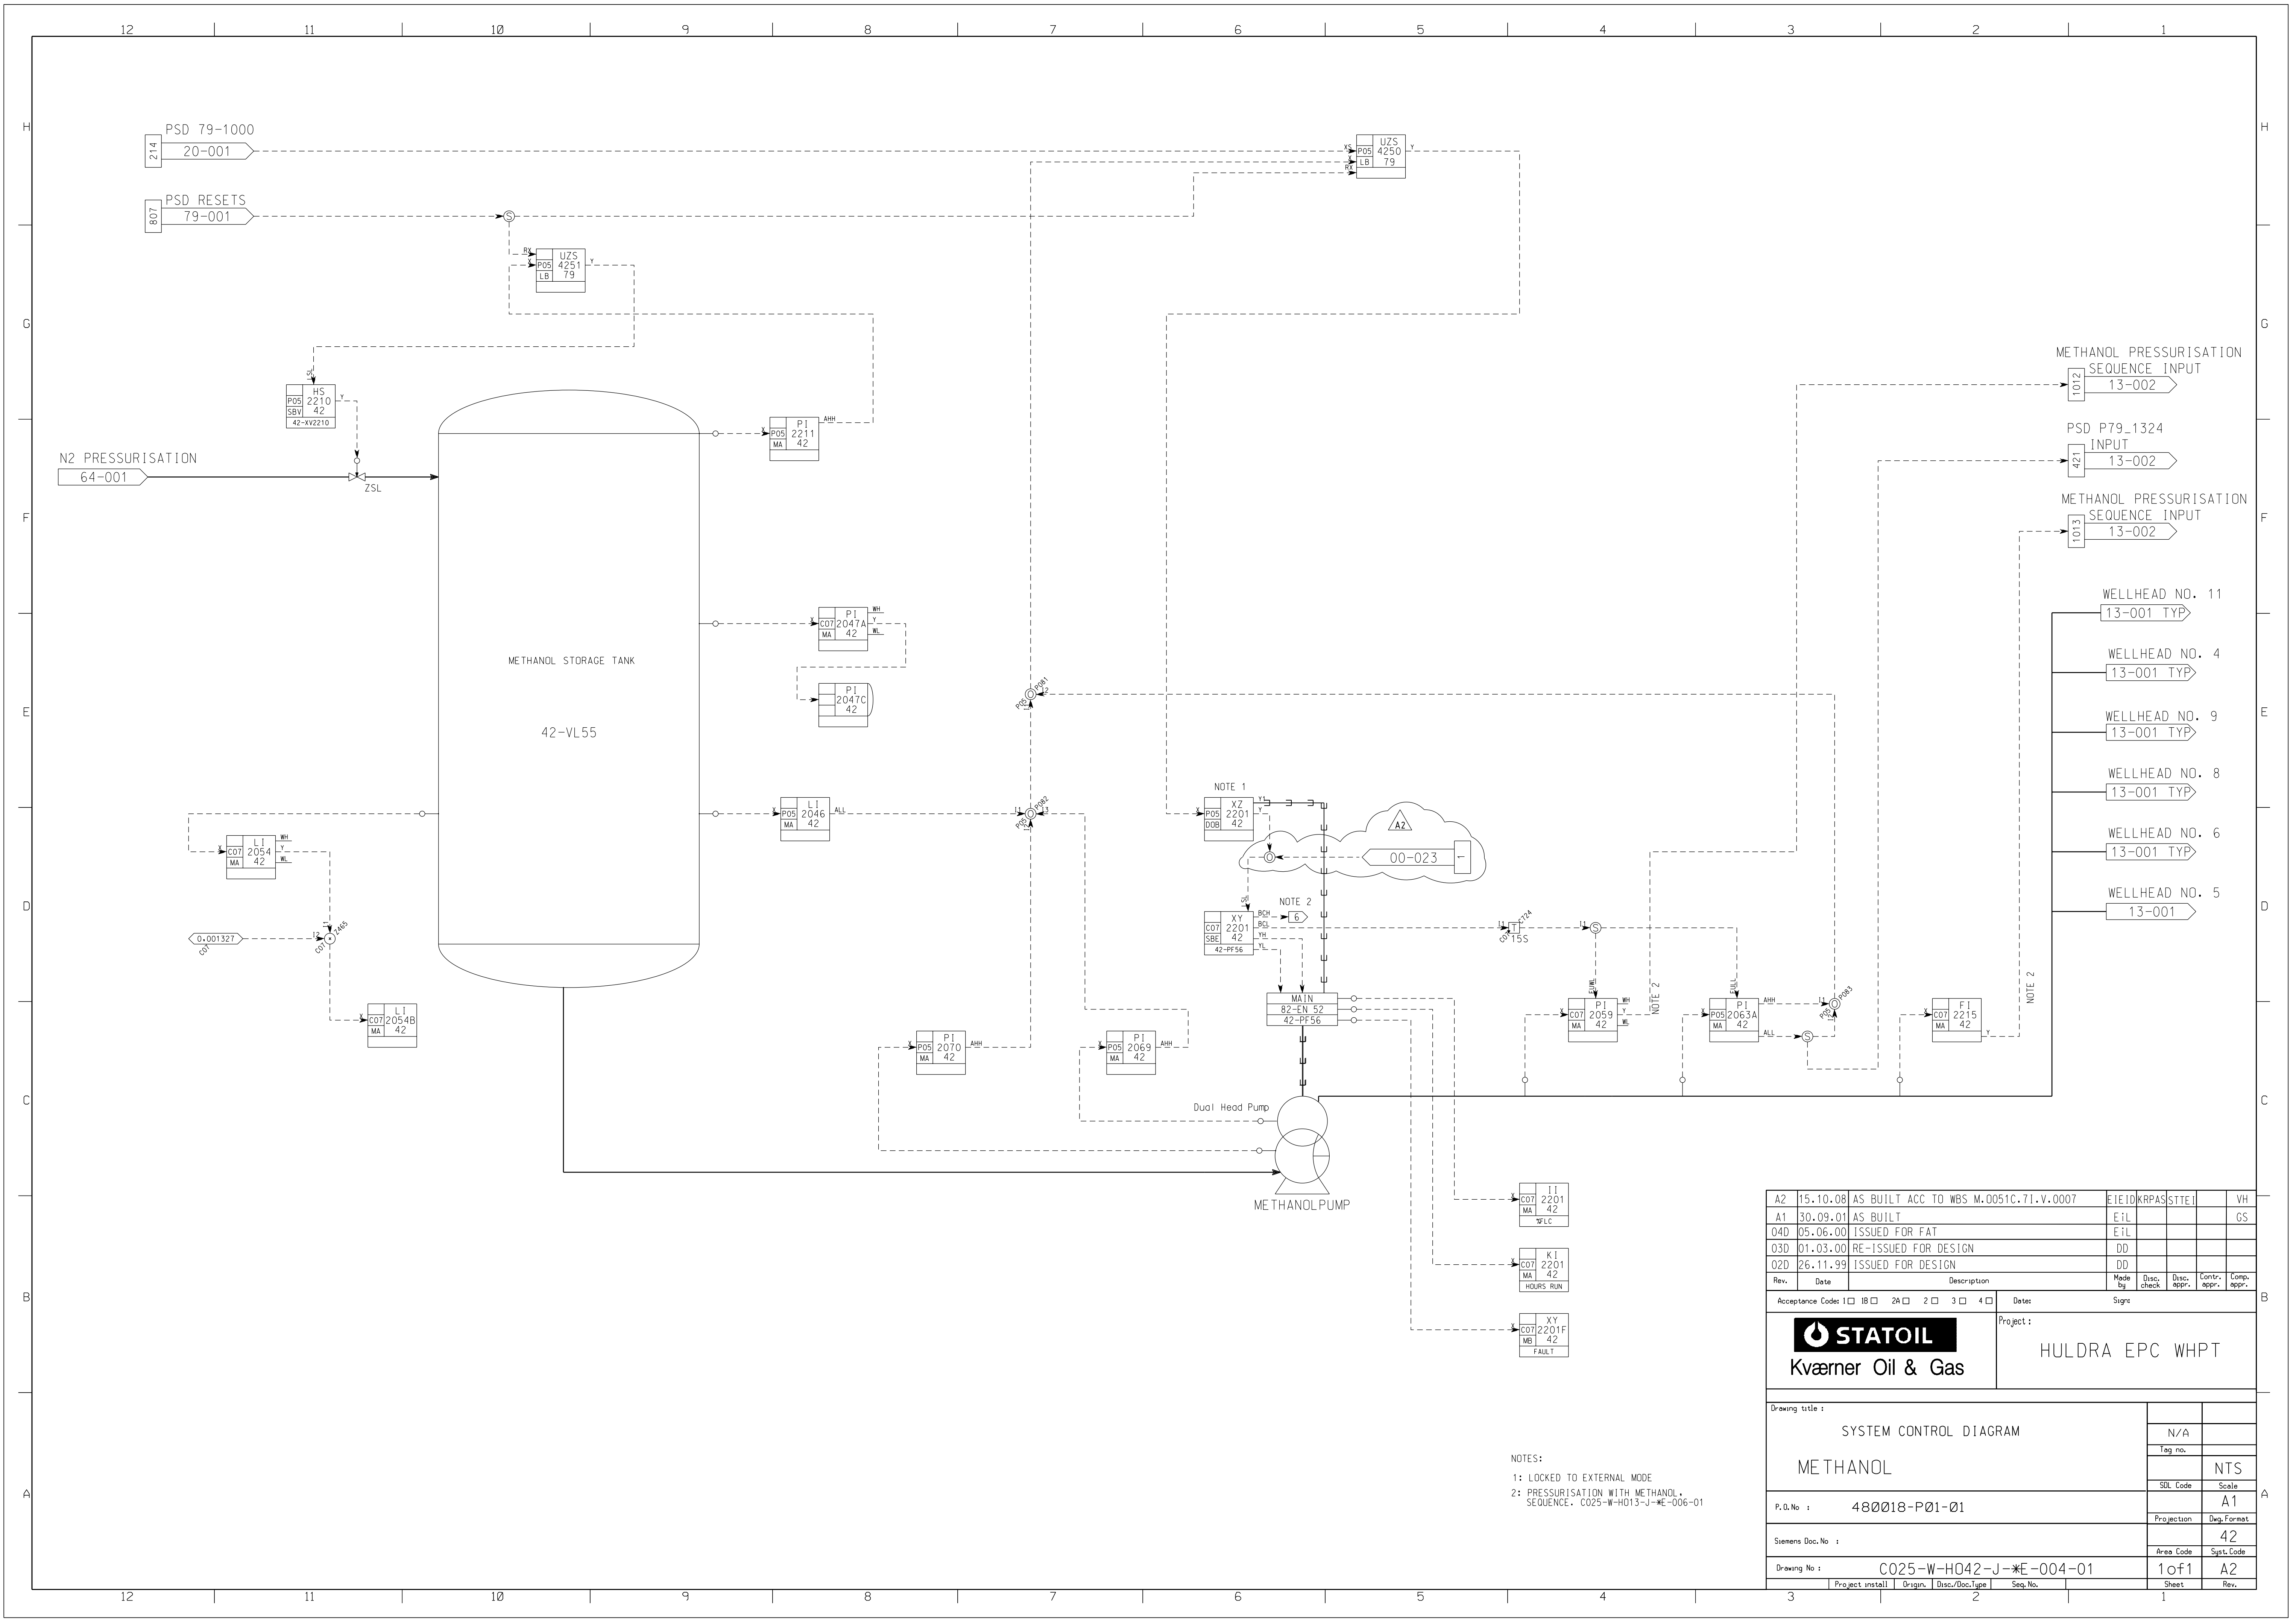

NOTES:
1: LOCKED TO EXTERNAL MODE
2: PRESSURISATION WITH METHANOL SEQUENCE. C025-W-H013-J-*E-006-01

A2	15.10.08	AS BUILT ACC TO WBS M.0051C.71.V.0007	EIL	KRPAS	SITE1		VH
A1	30.09.01	AS BUILT	EIL				GS
04D	05.06.00	ISSUED FOR FAT	EIL				
03D	01.03.00	RE-ISSUED FOR DESIGN	DD				
02D	26.11.99	ISSUED FOR DESIGN	DD				
Rev.	Date	Description	Made by	Disc. check	Disc. appr.	Contr. appr.	Comp. appr.
Acceptance Codes: 1 18 24 2 3 4			Date: Sign:				
 Kværner Oil & Gas			Project: HULDRA EPC WHPT				
Drawing title: SYSTEM CONTROL DIAGRAM METHANOL			N/A				
			Tag no.		NTS		
P.O.No : 480018-P01-01			SOL Code		Scale A1		
Siemens Doc.No :			Projection		Dwg.Format 42		
Drawing No : C025-W-H042-J-*E-004-01			Area Code		Syst.Code		
Project install			Origin.		Disc./Doc.Type		Seq.No.
Sheet			Rev.				