

42-JB50 CONTINUES ON SCD 42-002

42-FI 2190

42-002


CHEMICAL INJECTION
CALIBRATION ROUTE

42-002

Note 3

CHEMICAL INJECTION
NORMAL ROUTE

42-002

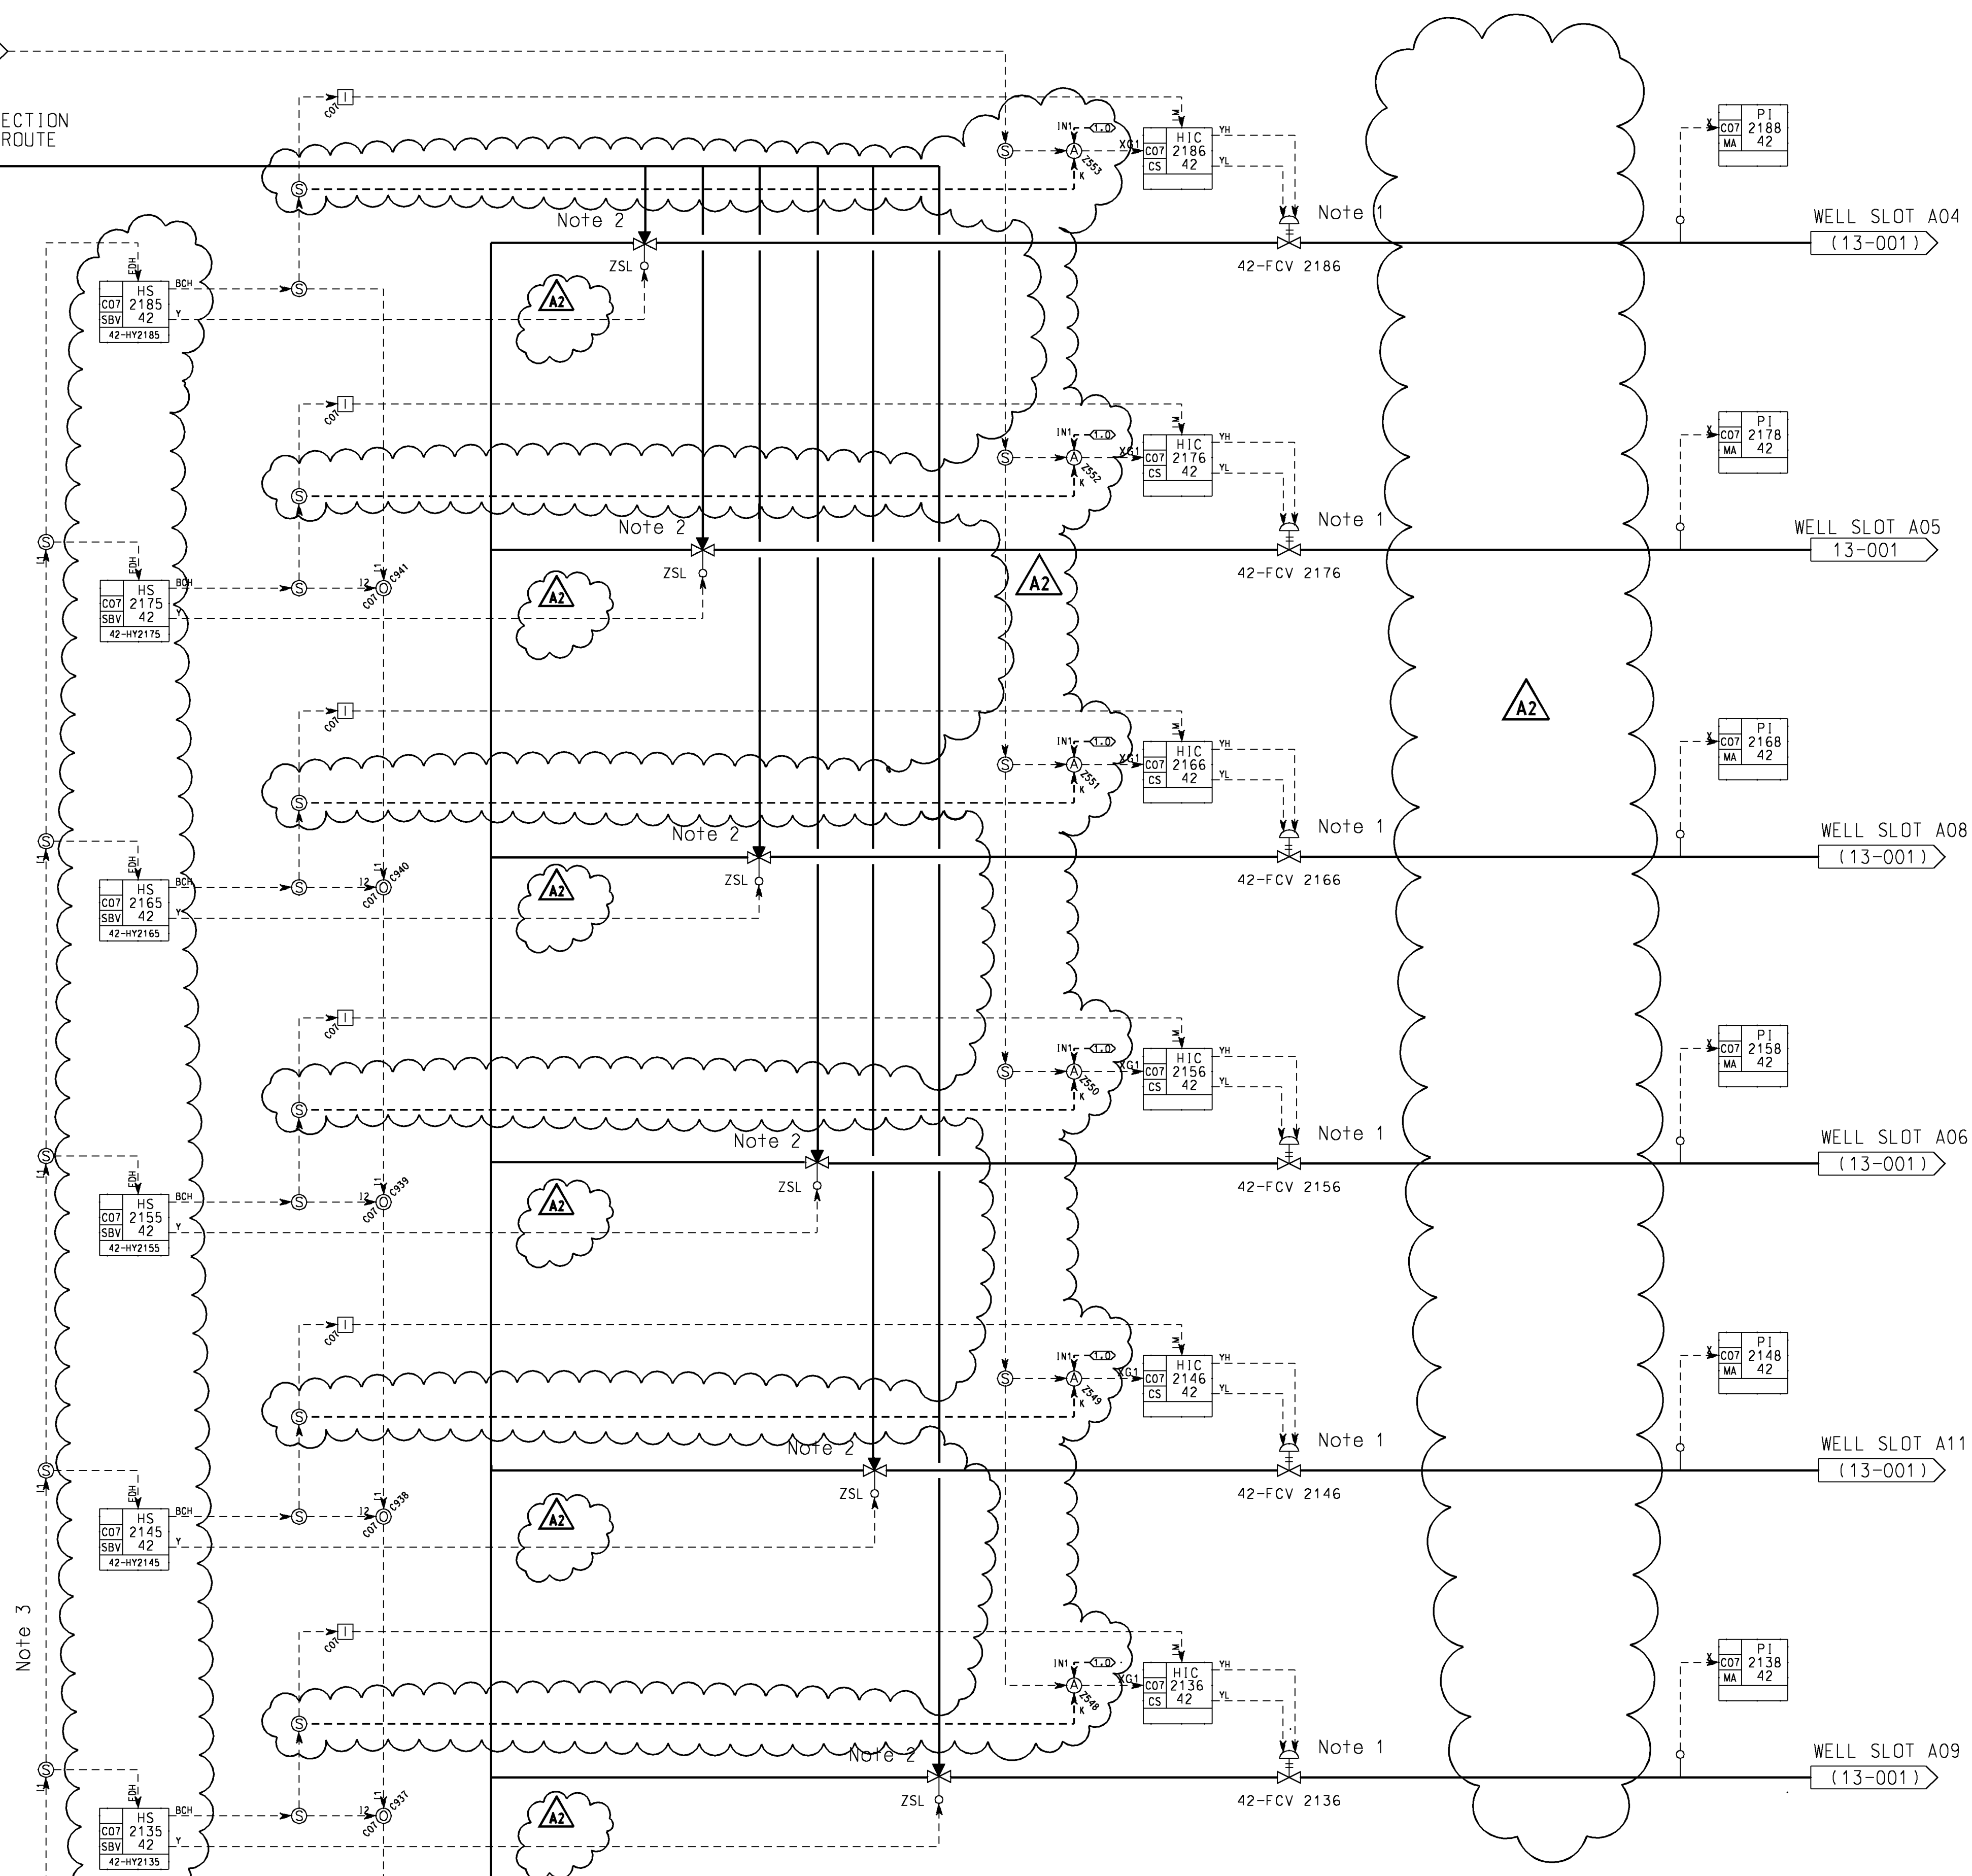

NOTES:

- 1: INCREASE/DECREASE STEP BY STEP VIA 24VDC MOTOR.
AMFLOW METERING WITH ACTUATOR. THERE IS NO FEEDBACK FACILITY
OF VALVE POSITION FROM THE ACTUATOR.
SUCCEEDING AUTOMATIC COARSE ADJUSTMENT BASED ON FLOW MEASUREMENT
42-FI 2190, THE OPERATOR FINALLY TUNES THE VALVE MANUALLY.
THE RANGE OF THE FLOW SIGNAL IS 0-36 LITRE/H
- 2: Proximity sensor, one state only
this indicates 'closed' position
from metering line, a 2 way SV,
with flow direction of 3 way SV.
One indicates closed from metering.
indicating normal operation
- 3: INHIBIT REQUIRED, SO THAT ONLY ONE LINE AT A TIME CAN BE
CONNECTED TO THE CALIBRATION ROUTE

A1	30.09.01	AS BUILT	EIL				GS
0	31.03.01	ISSUED FOR CONSTRUCTION	SNo				
04D	05.06.00	ISSUED FOR FAT	EIL				
03D	01.03.00	RE-ISSUED FOR DESIGN	DD				
A2	03.03.03	AS BUILT AD 600037	NH-J				
Rev.	Date	Description	Made by	Disc. check	Disc. appr.	Contr. appr.	Comp. appr.
Acceptance Codes: 1 ☐ 1B ☐ 2A ☐ 2 ☐ 3 ☐ 4 ☐			Signs				
STATOIL Kværner Oil & Gas			Project: HULDRA EPC WHPT				
Drawing title:			N/A				
			Tag no.				
			NTS				
P.O.No : 480018-P01-01			Scale		A1		
Siemens Doc.No :			Projection		42		
Drawing No : C025-W-H042-J-*E-005-01			Area Code		Sys. Code		
			1 of 1		A2		
			Project install		Origin		
			Disc./Doc.Type		Seq.No.		
					Sheet		
					Rev.		