


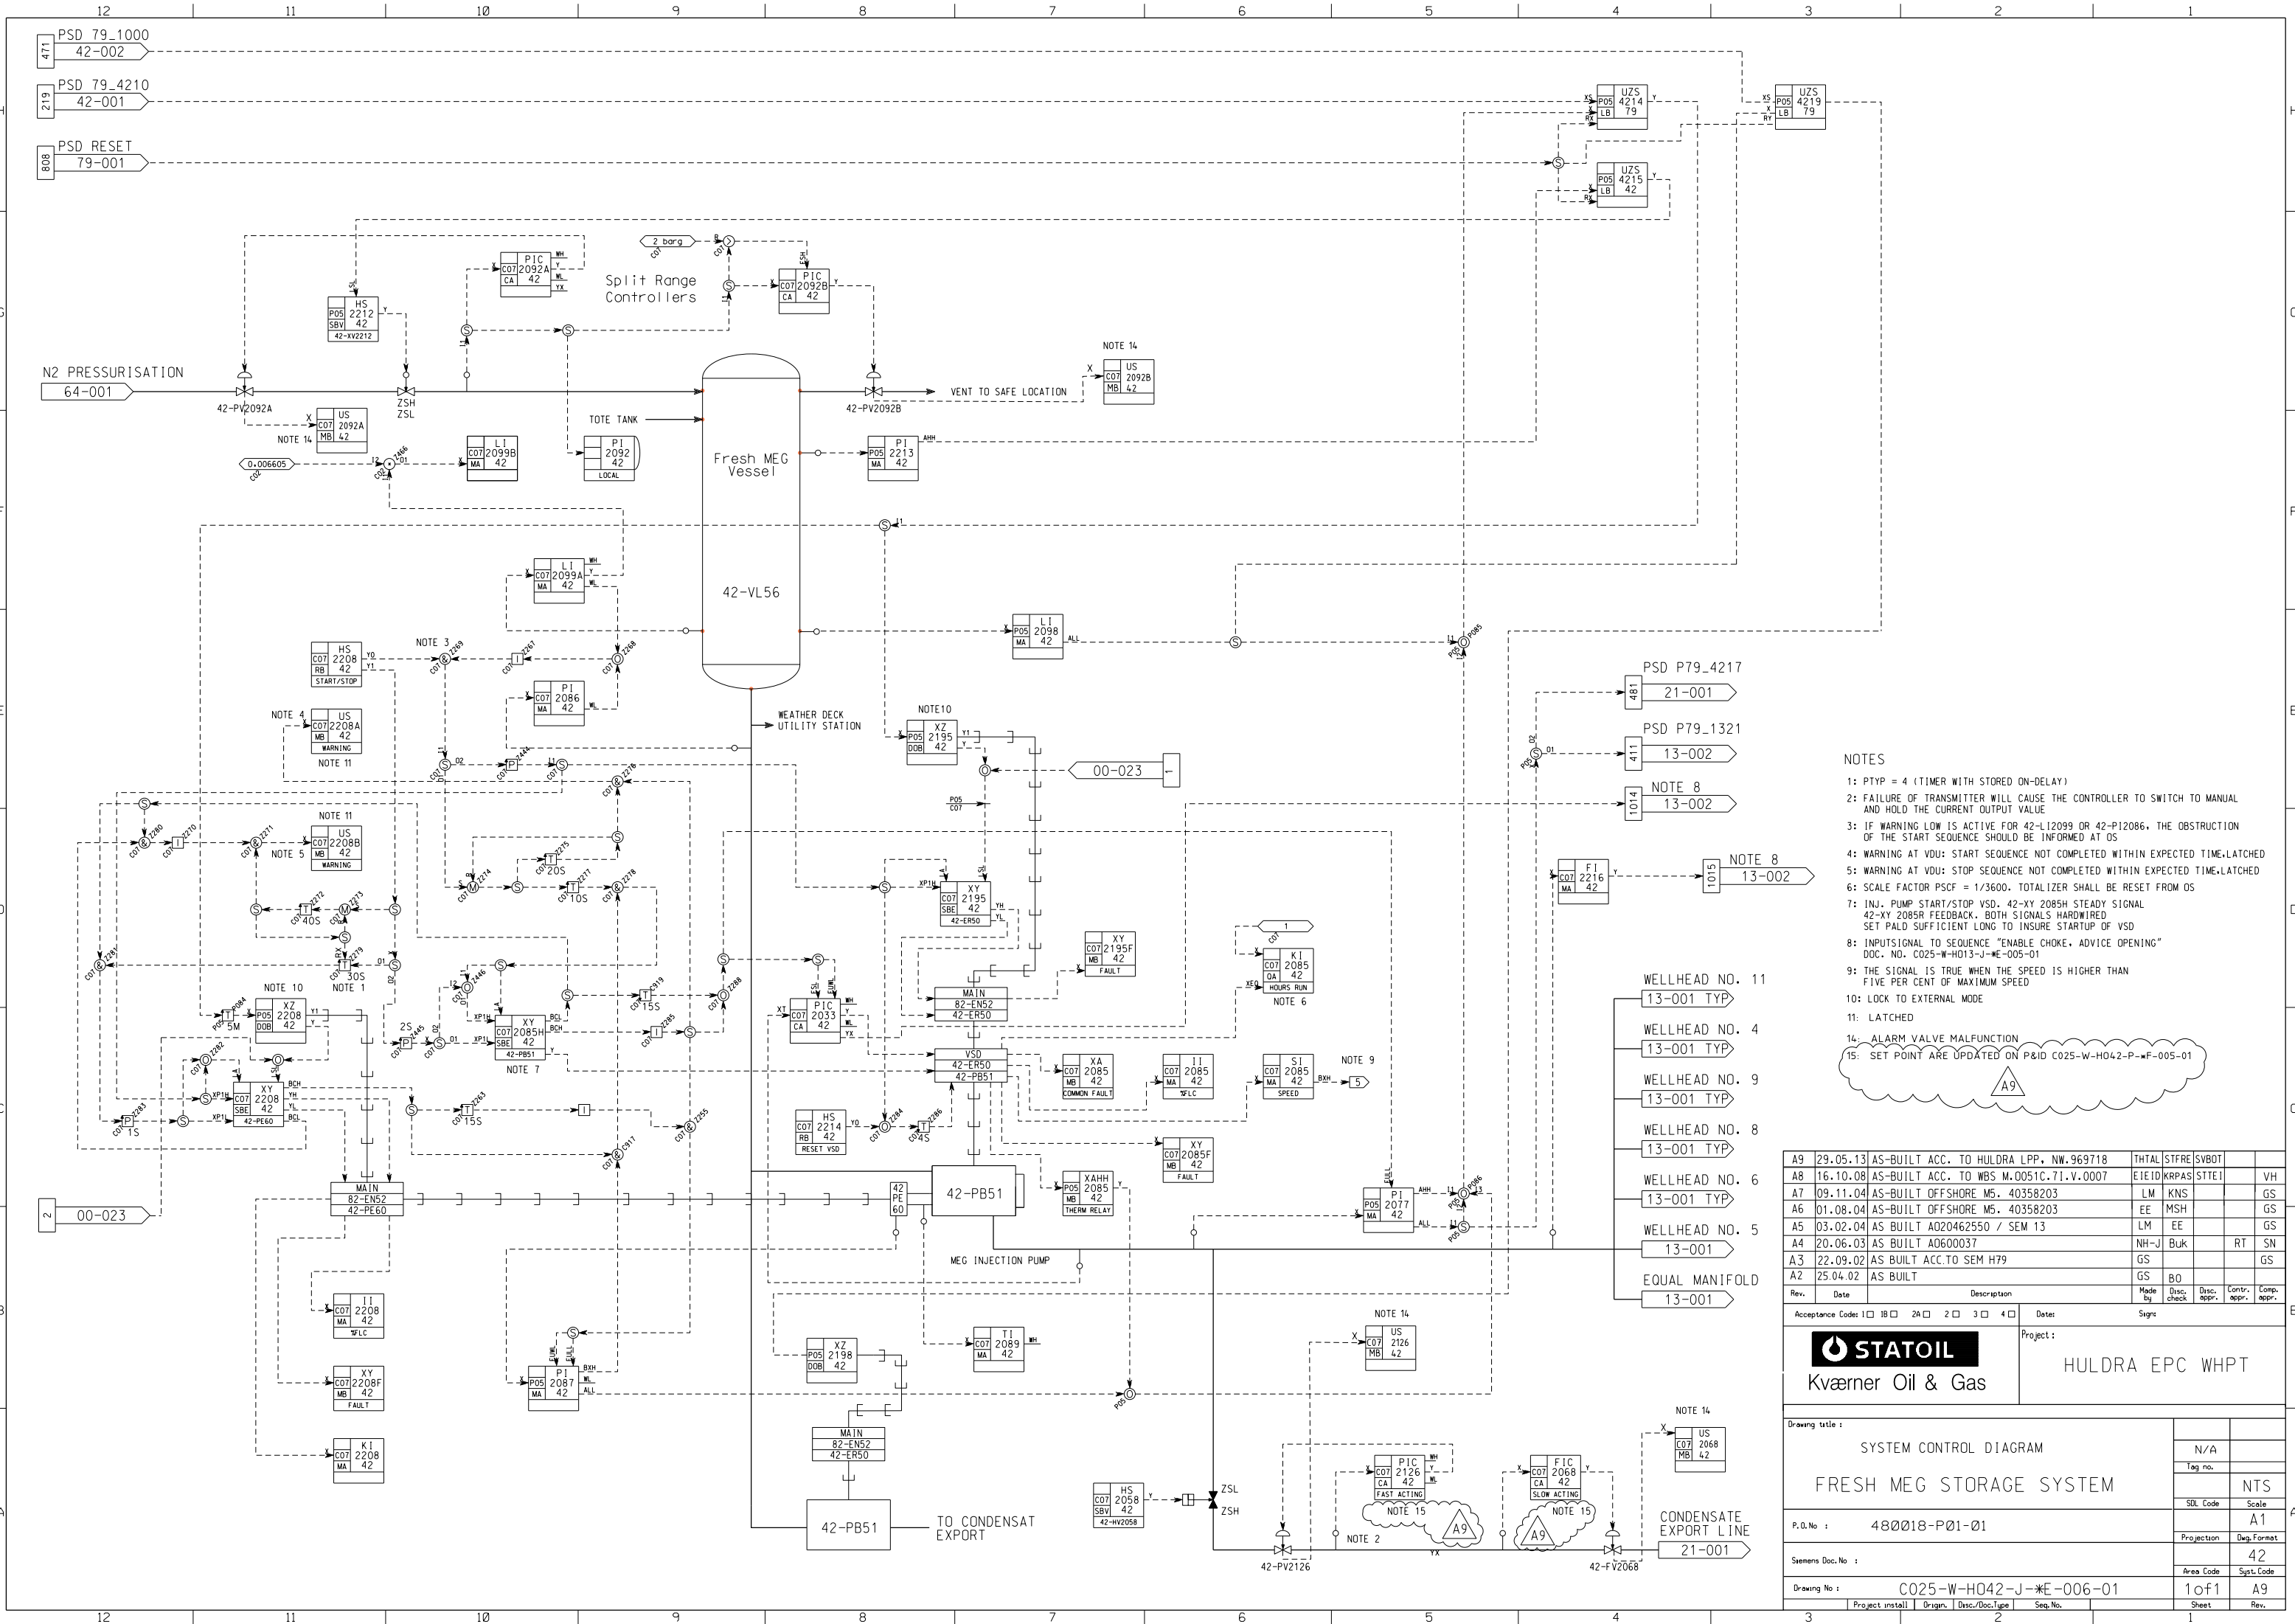

- NOTES
- 1: PTYP = 4 (TIMER WITH STORED ON-DELAY)
 - 2: FAILURE OF TRANSMITTER WILL CAUSE THE CONTROLLER TO SWITCH TO MANUAL AND HOLD THE CURRENT OUTPUT VALUE
 - 3: IF WARNING LOW IS ACTIVE FOR 42-LI2099 OR 42-PI2086, THE OBSTRUCTION OF THE START SEQUENCE SHOULD BE INFORMED AT OS
 - 4: WARNING AT VDU: START SEQUENCE NOT COMPLETED WITHIN EXPECTED TIME,LATCHED
 - 5: WARNING AT VDU: STOP SEQUENCE NOT COMPLETED WITHIN EXPECTED TIME,LATCHED
 - 6: SCALE FACTOR PSCF = 1/3600. TOTALIZER SHALL BE RESET FROM OS
 - 7: INJ. PUMP START/STOP VSD. 42-XY 2085H STEADY SIGNAL 42-XY 2085R FEEDBACK. BOTH SIGNALS HARDWIRED SET PALD SUFFICIENT LONG TO INSURE STARTUP OF VSD
 - 8: INPUTSIGNAL TO SEQUENCE "ENABLE CHOKE, ADVICE OPENING" DOC. NO. C025-W-H013-J-ME-005-01
 - 9: THE SIGNAL IS TRUE WHEN THE SPEED IS HIGHER THAN FIVE PER CENT OF MAXIMUM SPEED
 - 10: LOCK TO EXTERNAL MODE
 - 11: LATCHED
 - 14: ALARM VALVE MALFUNCTION
 - 15: SET POINT ARE UPDATED ON P&ID C025-W-H042-P-WF-005-01

A9	29.05.13	AS-BUILT ACC. TO HULDRA LPP. NW.969718	HTHAL	STFRE	SVBOT		
A8	16.10.08	AS-BUILT ACC. TO WBS M.0051C.71.V.0007	EIEID	KRPAS	STTEI		VH
A7	09.11.04	AS-BUILT OFFSHORE M5. 40358203	LM	KNS			GS
A6	01.08.04	AS-BUILT OFFSHORE M5. 40358203	EE	MSH			GS
A5	03.02.04	AS BUILT A020462550 / SEM 13	LM	EE			GS
A4	20.06.03	AS BUILT A0600037	NH-J	Buk		RT	SN
A3	22.09.02	AS BUILT ACC.TO SEM H79	GS				GS
A2	25.04.02	AS BUILT	GS	BO			
Rev.	Date	Description	Made by	Disc. check	Disc. appr.	Contr. appr.	Comp. appr.
Acceptance Codes 1 ☐ 1B ☐ 2A ☐ 2 ☐ 3 ☐ 4 ☐			Sign:				
 STATOIL Kværner Oil & Gas			Project :				
			HULDRA EPC WHPT				
Drawing title :							
SYSTEM CONTROL DIAGRAM				N/A			
				Tag no.			
FRESH MEG STORAGE SYSTEM						NTS	
				SDL Code		Scale	
P.O. No : 480018-P01-01						A9	
Siemens Doc. No :				Projection		Draw Format	
						42	
Drawing No : C025-W-H042-J-ME-006-01				Area Code		Syst.Code	
				1 of 1		A9	
Project install		Origin	Disc./Doc./Type	Seq.No.		Sheet	Rev.