


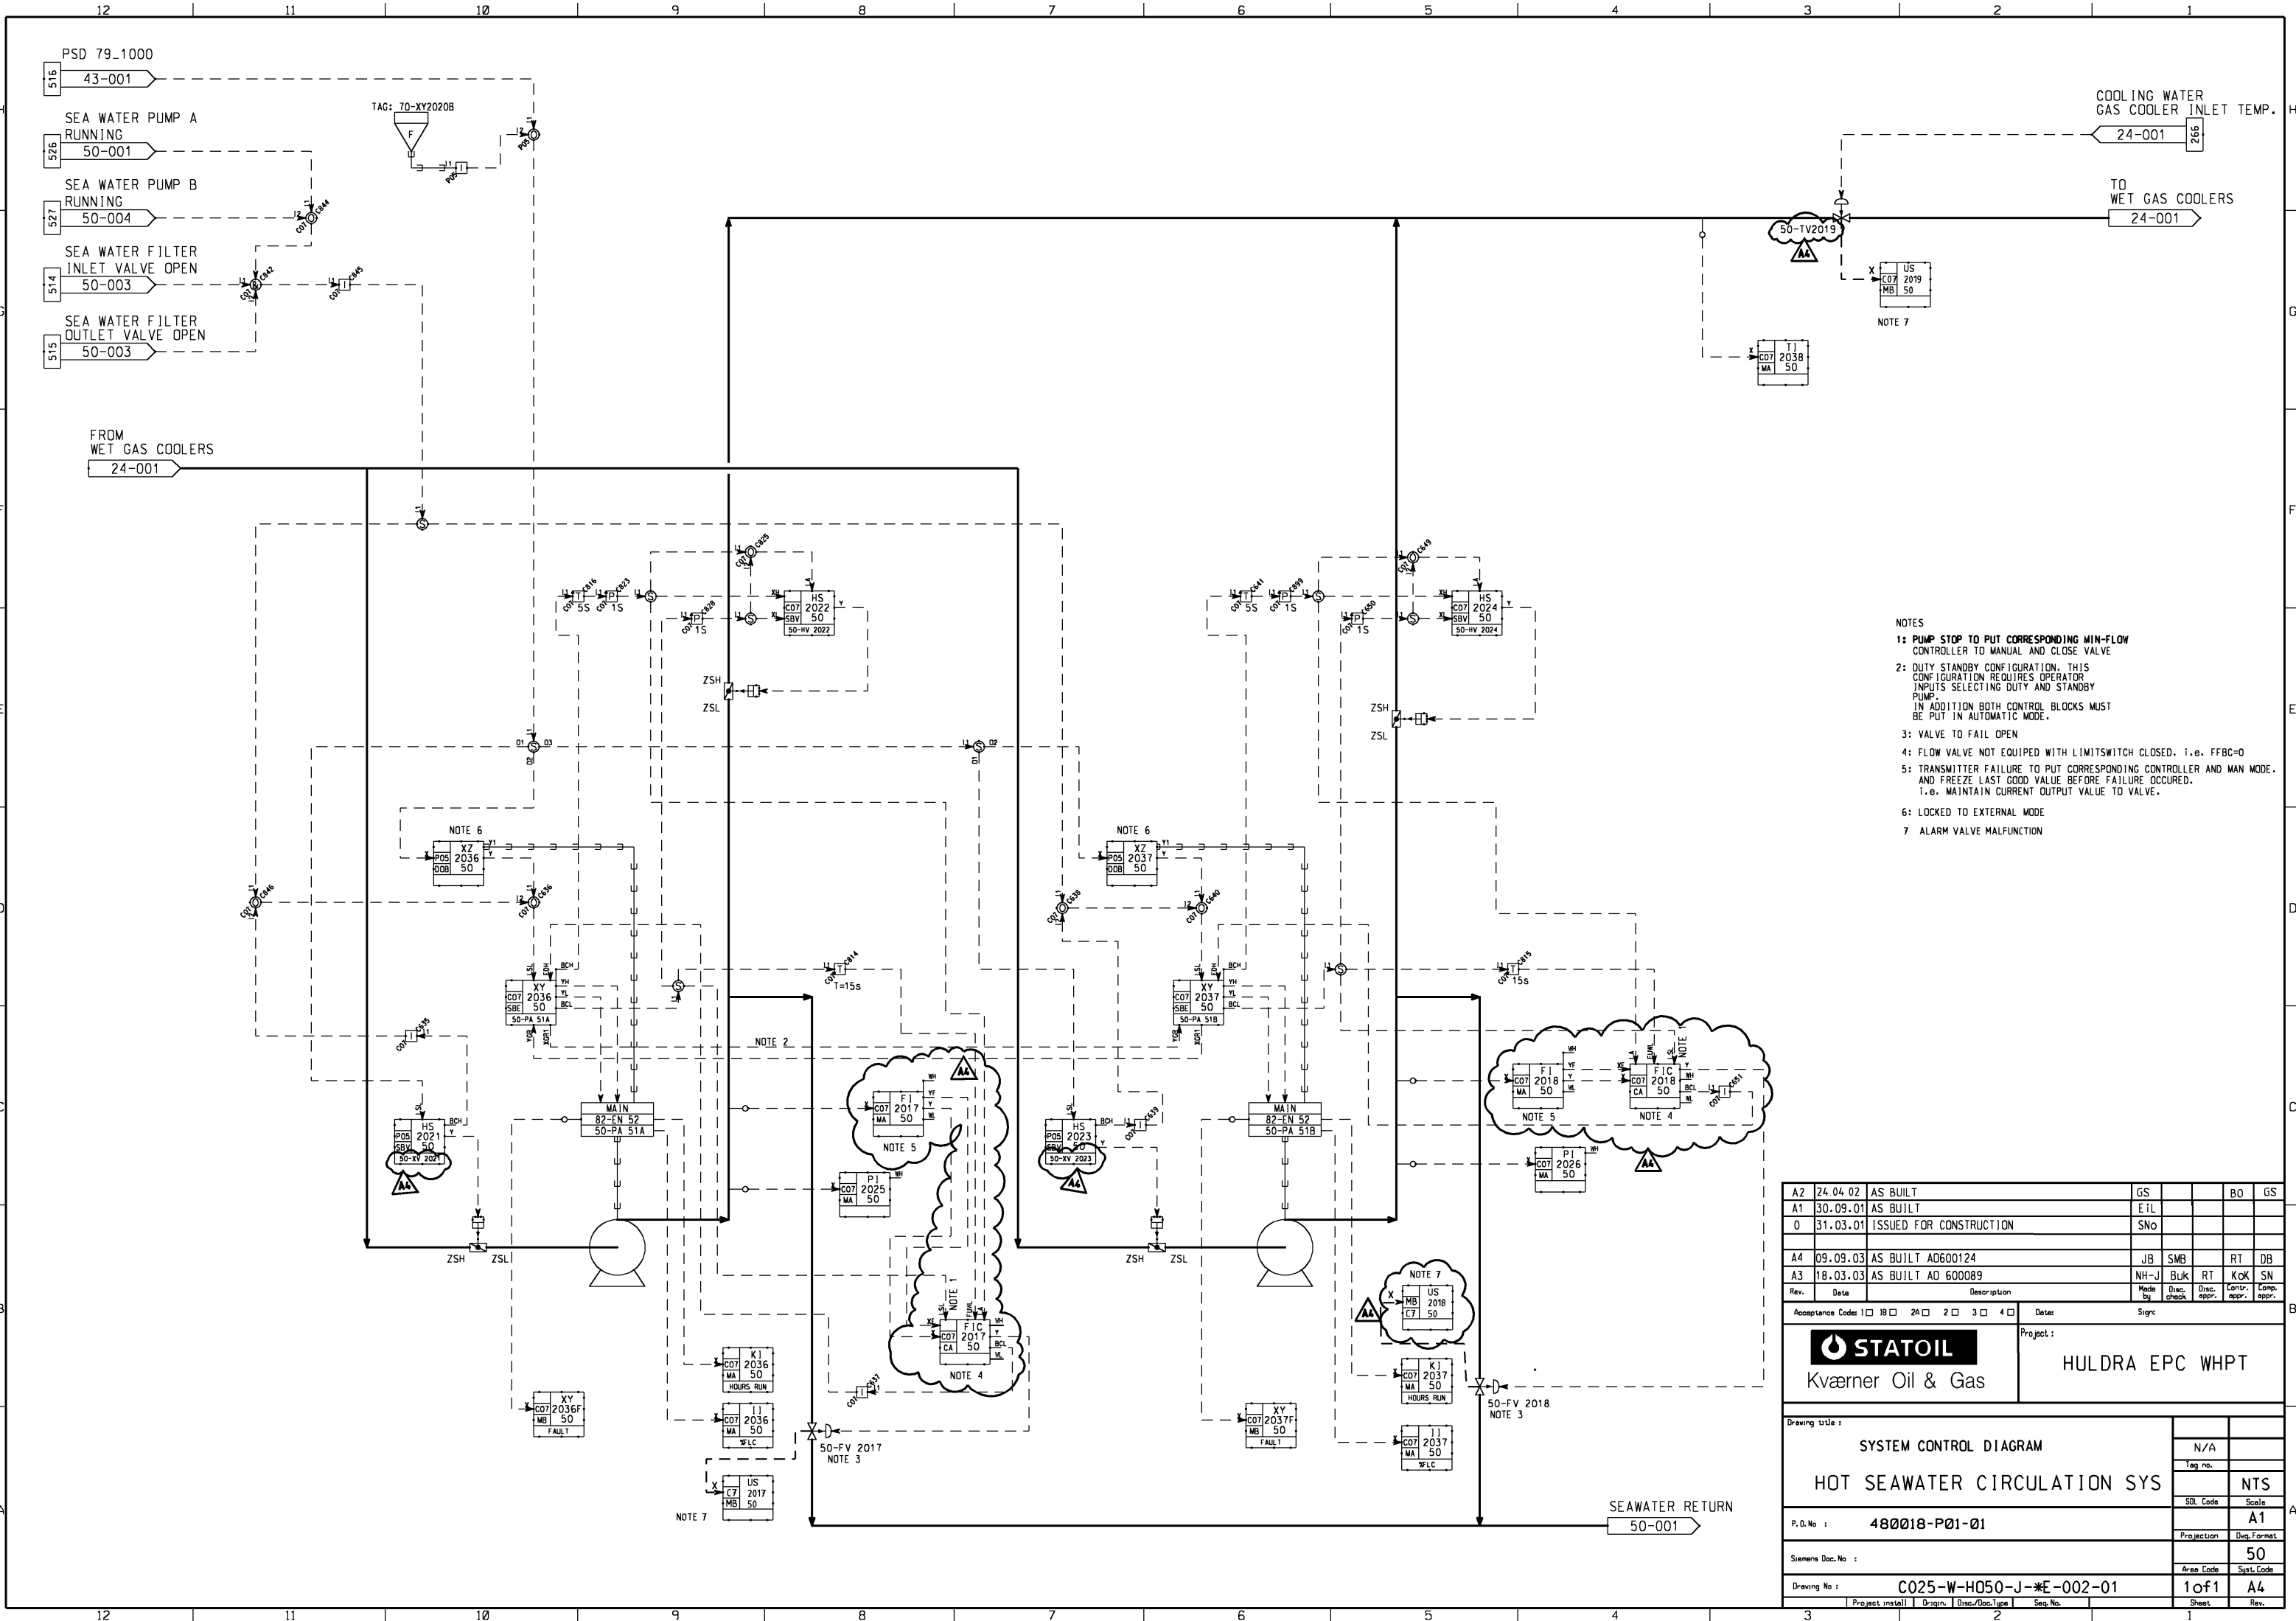

- NOTES
- 1: PUMP STOP TO PUT CORRESPONDING MIN-FLOW CONTROLLER TO MANUAL AND CLOSE VALVE
 - 2: DUTY STANDBY CONFIGURATION. THIS CONFIGURATION REQUIRES OPERATOR INPUTS SELECTING DUTY AND STANDBY PUMP. IN ADDITION BOTH CONTROL BLOCKS MUST BE PUT IN AUTOMATIC MODE.
 - 3: VALVE TO FAIL OPEN
 - 4: FLOW VALVE NOT EQUIPED WITH LIMITSWITCH CLOSED. I.e. FFBC=0
 - 5: TRANSMITTER FAILURE TO PUT CORRESPONDING CONTROLLER AND MAN MODE. AND FREEZE LAST GOOD VALUE BEFORE FAILURE OCCURED. I.e. MAINTAIN CURRENT OUTPUT VALUE TO VALVE.
 - 6: LOCKED TO EXTERNAL MODE
 - 7: ALARM VALVE MALFUNCTION

A2	24.04.02	AS BUILT	GS		BO	GS
A1	30.09.01	AS BUILT	ETL			
0	31.03.01	ISSUED FOR CONSTRUCTION	SNo			
A4	09.09.03	AS BUILT A0600124	JB	SMB	RT	DB
A3	18.03.03	AS BUILT A0 600089	NH-J	Buk	RT	KoK
Rev.	Date	Description	Mode by	Disc. check	Disc. appr.	Contr. Comp. appr.
Acceptance Codes: 1 1B 2A 2 3 4			Sign:			
Project:			HULDRA EPC WHPT			
Drawing title:			SYSTEM CONTROL DIAGRAM			
HOT SEAWATER CIRCULATION SYS			N/A			
P.O.No :			480018-P01-01			
Siemens Doc.No :			50			
Drawing No :			C025-W-H050-J-E-002-01			
Project install			1 of 1			
Origin			A4			
Disc./Doc./Type			Sheet			
Seq.No			Rev.			