


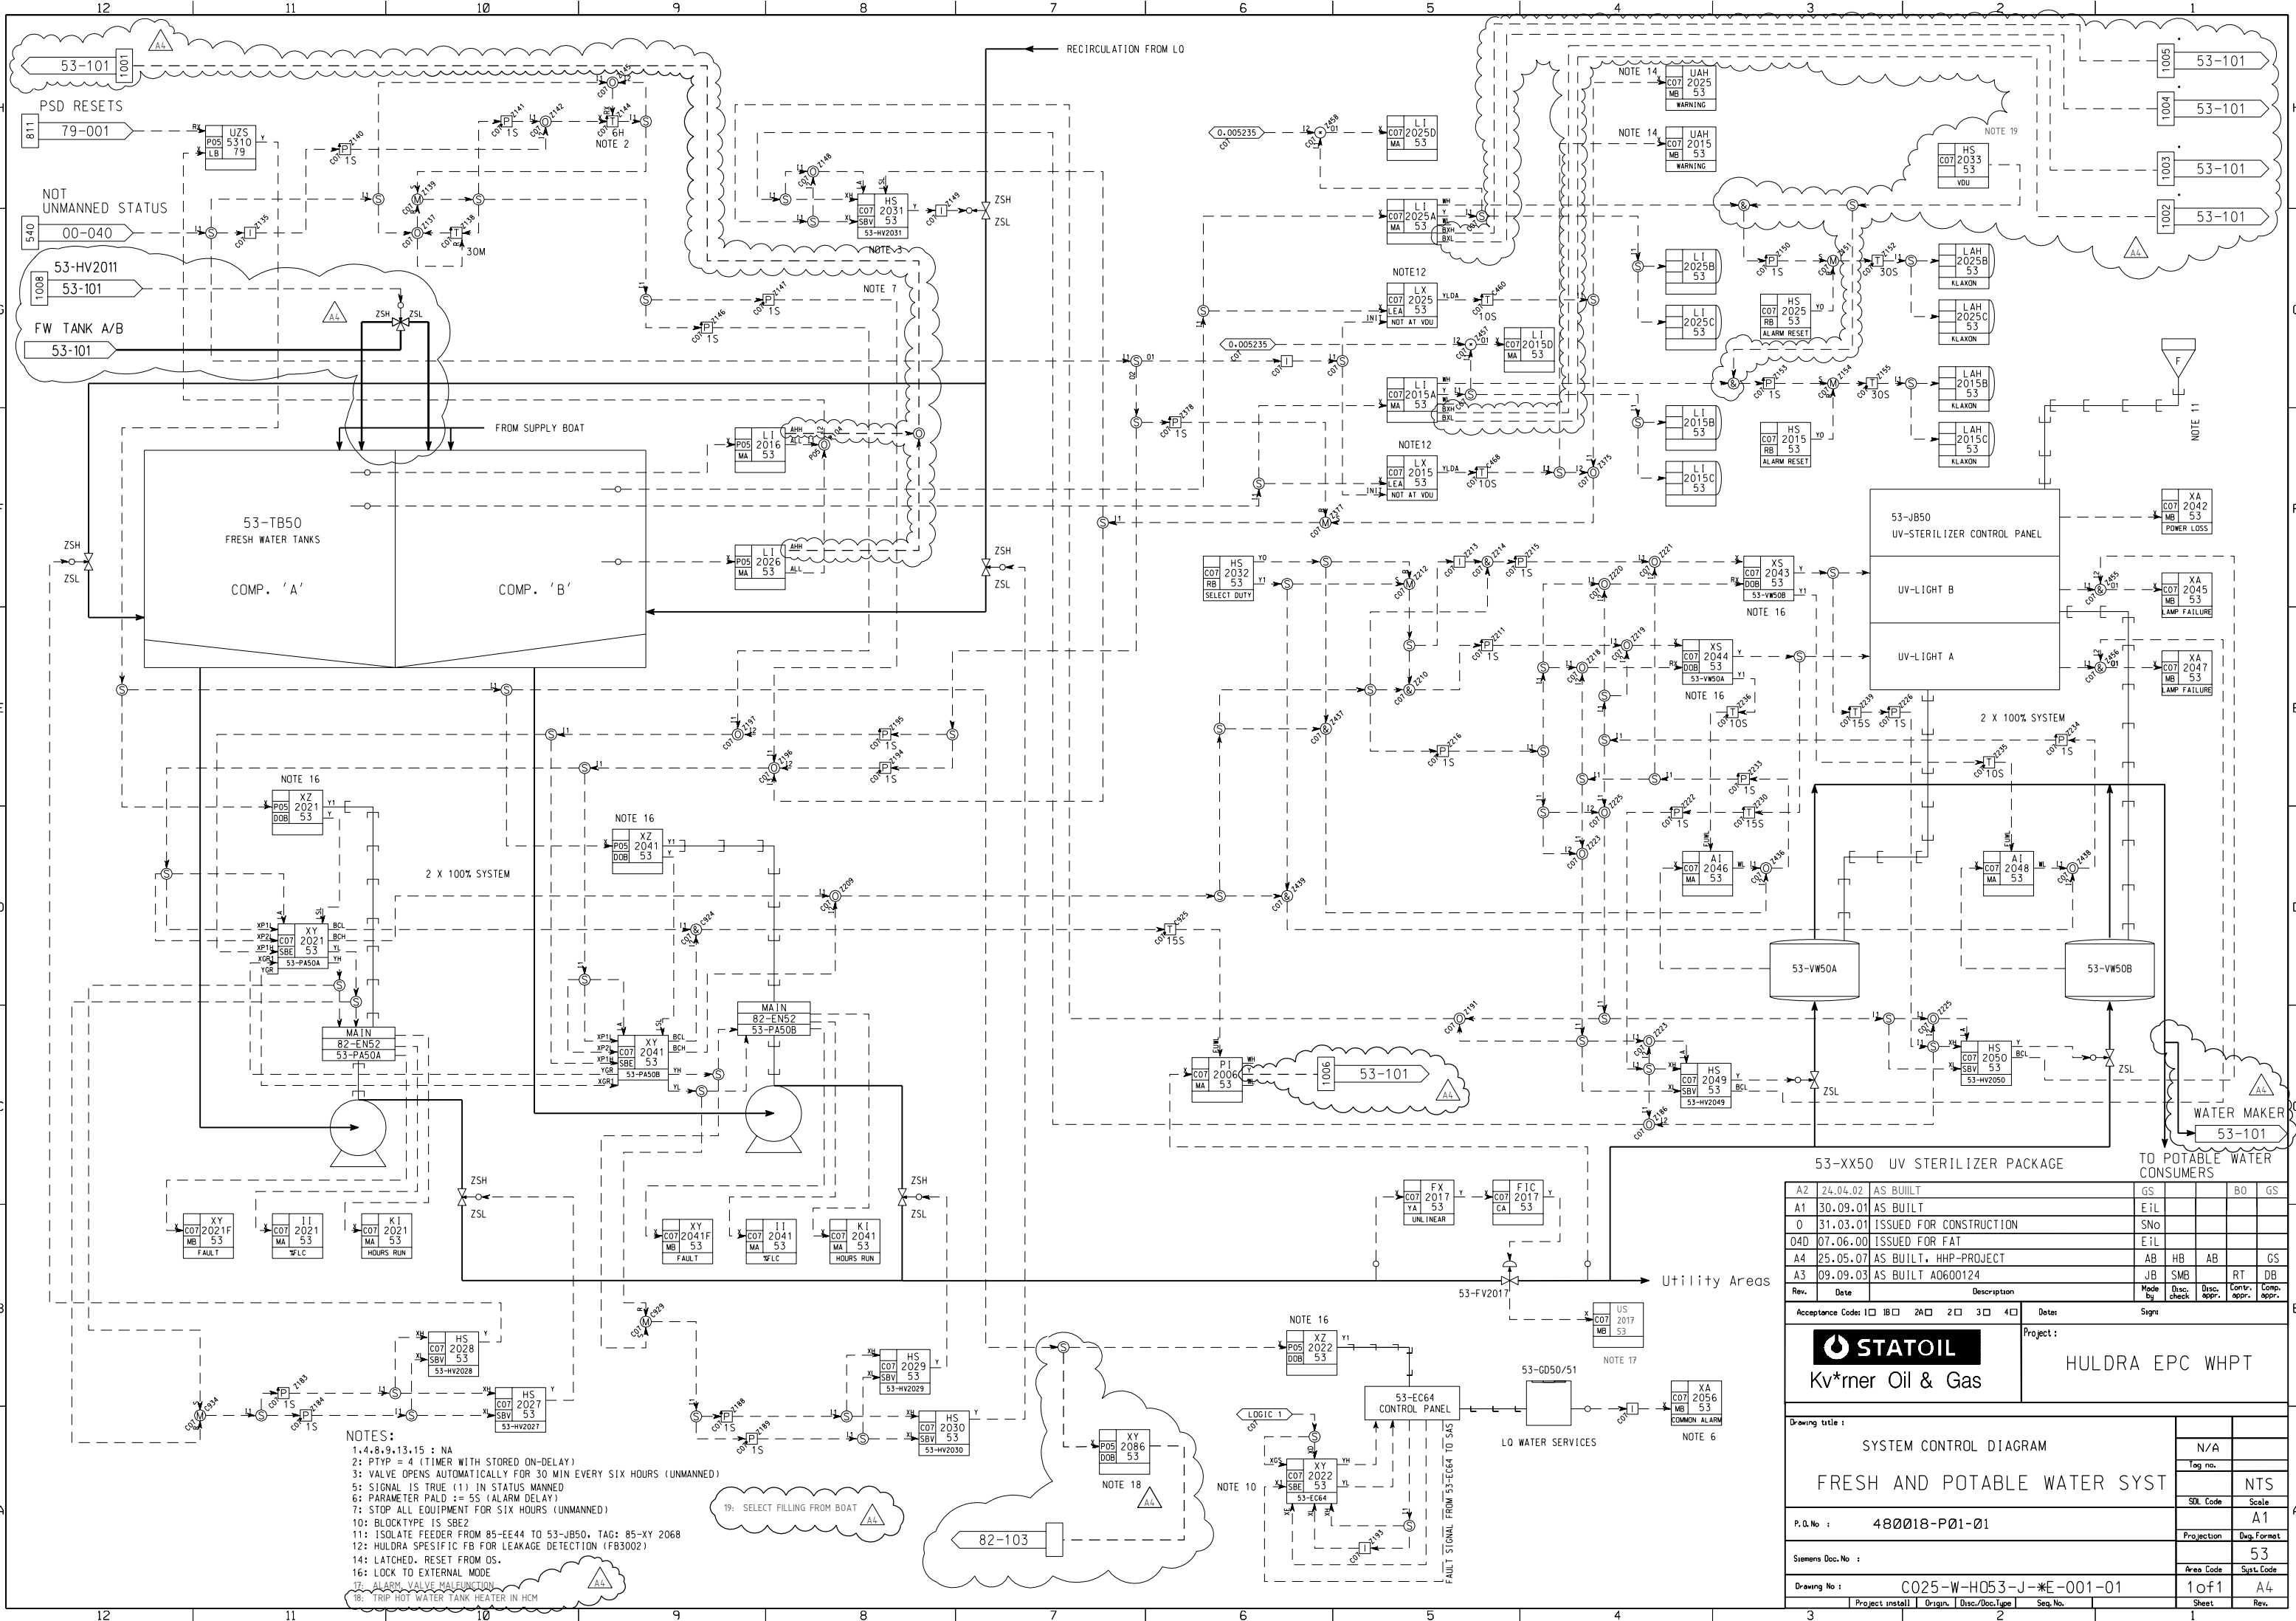

NOTES:
1: 4, 8, 9, 13, 15 : NA
2: PTYP = 4 (TIMER WITH STORED ON-DELAY)
3: VALVE OPENS AUTOMATICALLY FOR 30 MIN EVERY SIX HOURS (UNMANNED)
5: SIGNAL IS TRUE (1) IN STATUS MANNED
6: PARAMETER PALD := 5S (ALARM DELAY)
7: STOP ALL EQUIPMENT FOR SIX HOURS (UNMANNED)
10: BLOCKTYPE IS SBE2
11: ISOLATE FEEDER FROM 85-EE44 TO 53-JB50, TAG: 85-XY 2068
12: HULDRRA SPECIFIC FB FOR LEAKAGE DETECTION (FB3002)
14: LATCHED. RESET FROM OS.
16: LOCK TO EXTERNAL MODE
17: ALARM VALVE MALFUNCTION
18: TRIP HOT WATER TANK HEATER IN HCM

53-XX50 UV STERILIZER PACKAGE					TO POTABLE WATER CONSUMERS				
A2	24.04.02	AS BUILT	GS			B0	GS		
A1	30.09.01	AS BUILT	Eil						
0	31.03.01	ISSUED FOR CONSTRUCTION	SNo						
040	07.06.00	ISSUED FOR FAT	Eil						
A4	25.05.07	AS BUILT, HHP-PROJECT	AB	HB	AB		GS		
A3	09.09.03	AS BUILT A0600124	JB	SMB		RT	DB		
Rev.	Date	Description	Made by	Disc. check	Disc. appor.	Contr. appor.	Comp. appor.		
Acceptance Codes: 1 0 1B 2A 2 3 4 0			Sign:		Project:				
 STATOIL Kv*mer Oil & Gas			HULDRA EPC WHPT						
Drawing title :									
SYSTEM CONTROL DIAGRAM FRESH AND POTABLE WATER SYST					N/A				
					Tag no.				
							NTS		
P.O. No : 480018-P01-01					Scale		A1		
Siemens Doc.No :					Projection		Des.Format		
							53		
Drawing No : C025-W-H053-J-ME-001-01					Area Code		Syst.Code		
					1 of 1		A4		
Project install			Origin		Disc./Doc.Type		Seq. No.		
					Sheet		Rev.		