


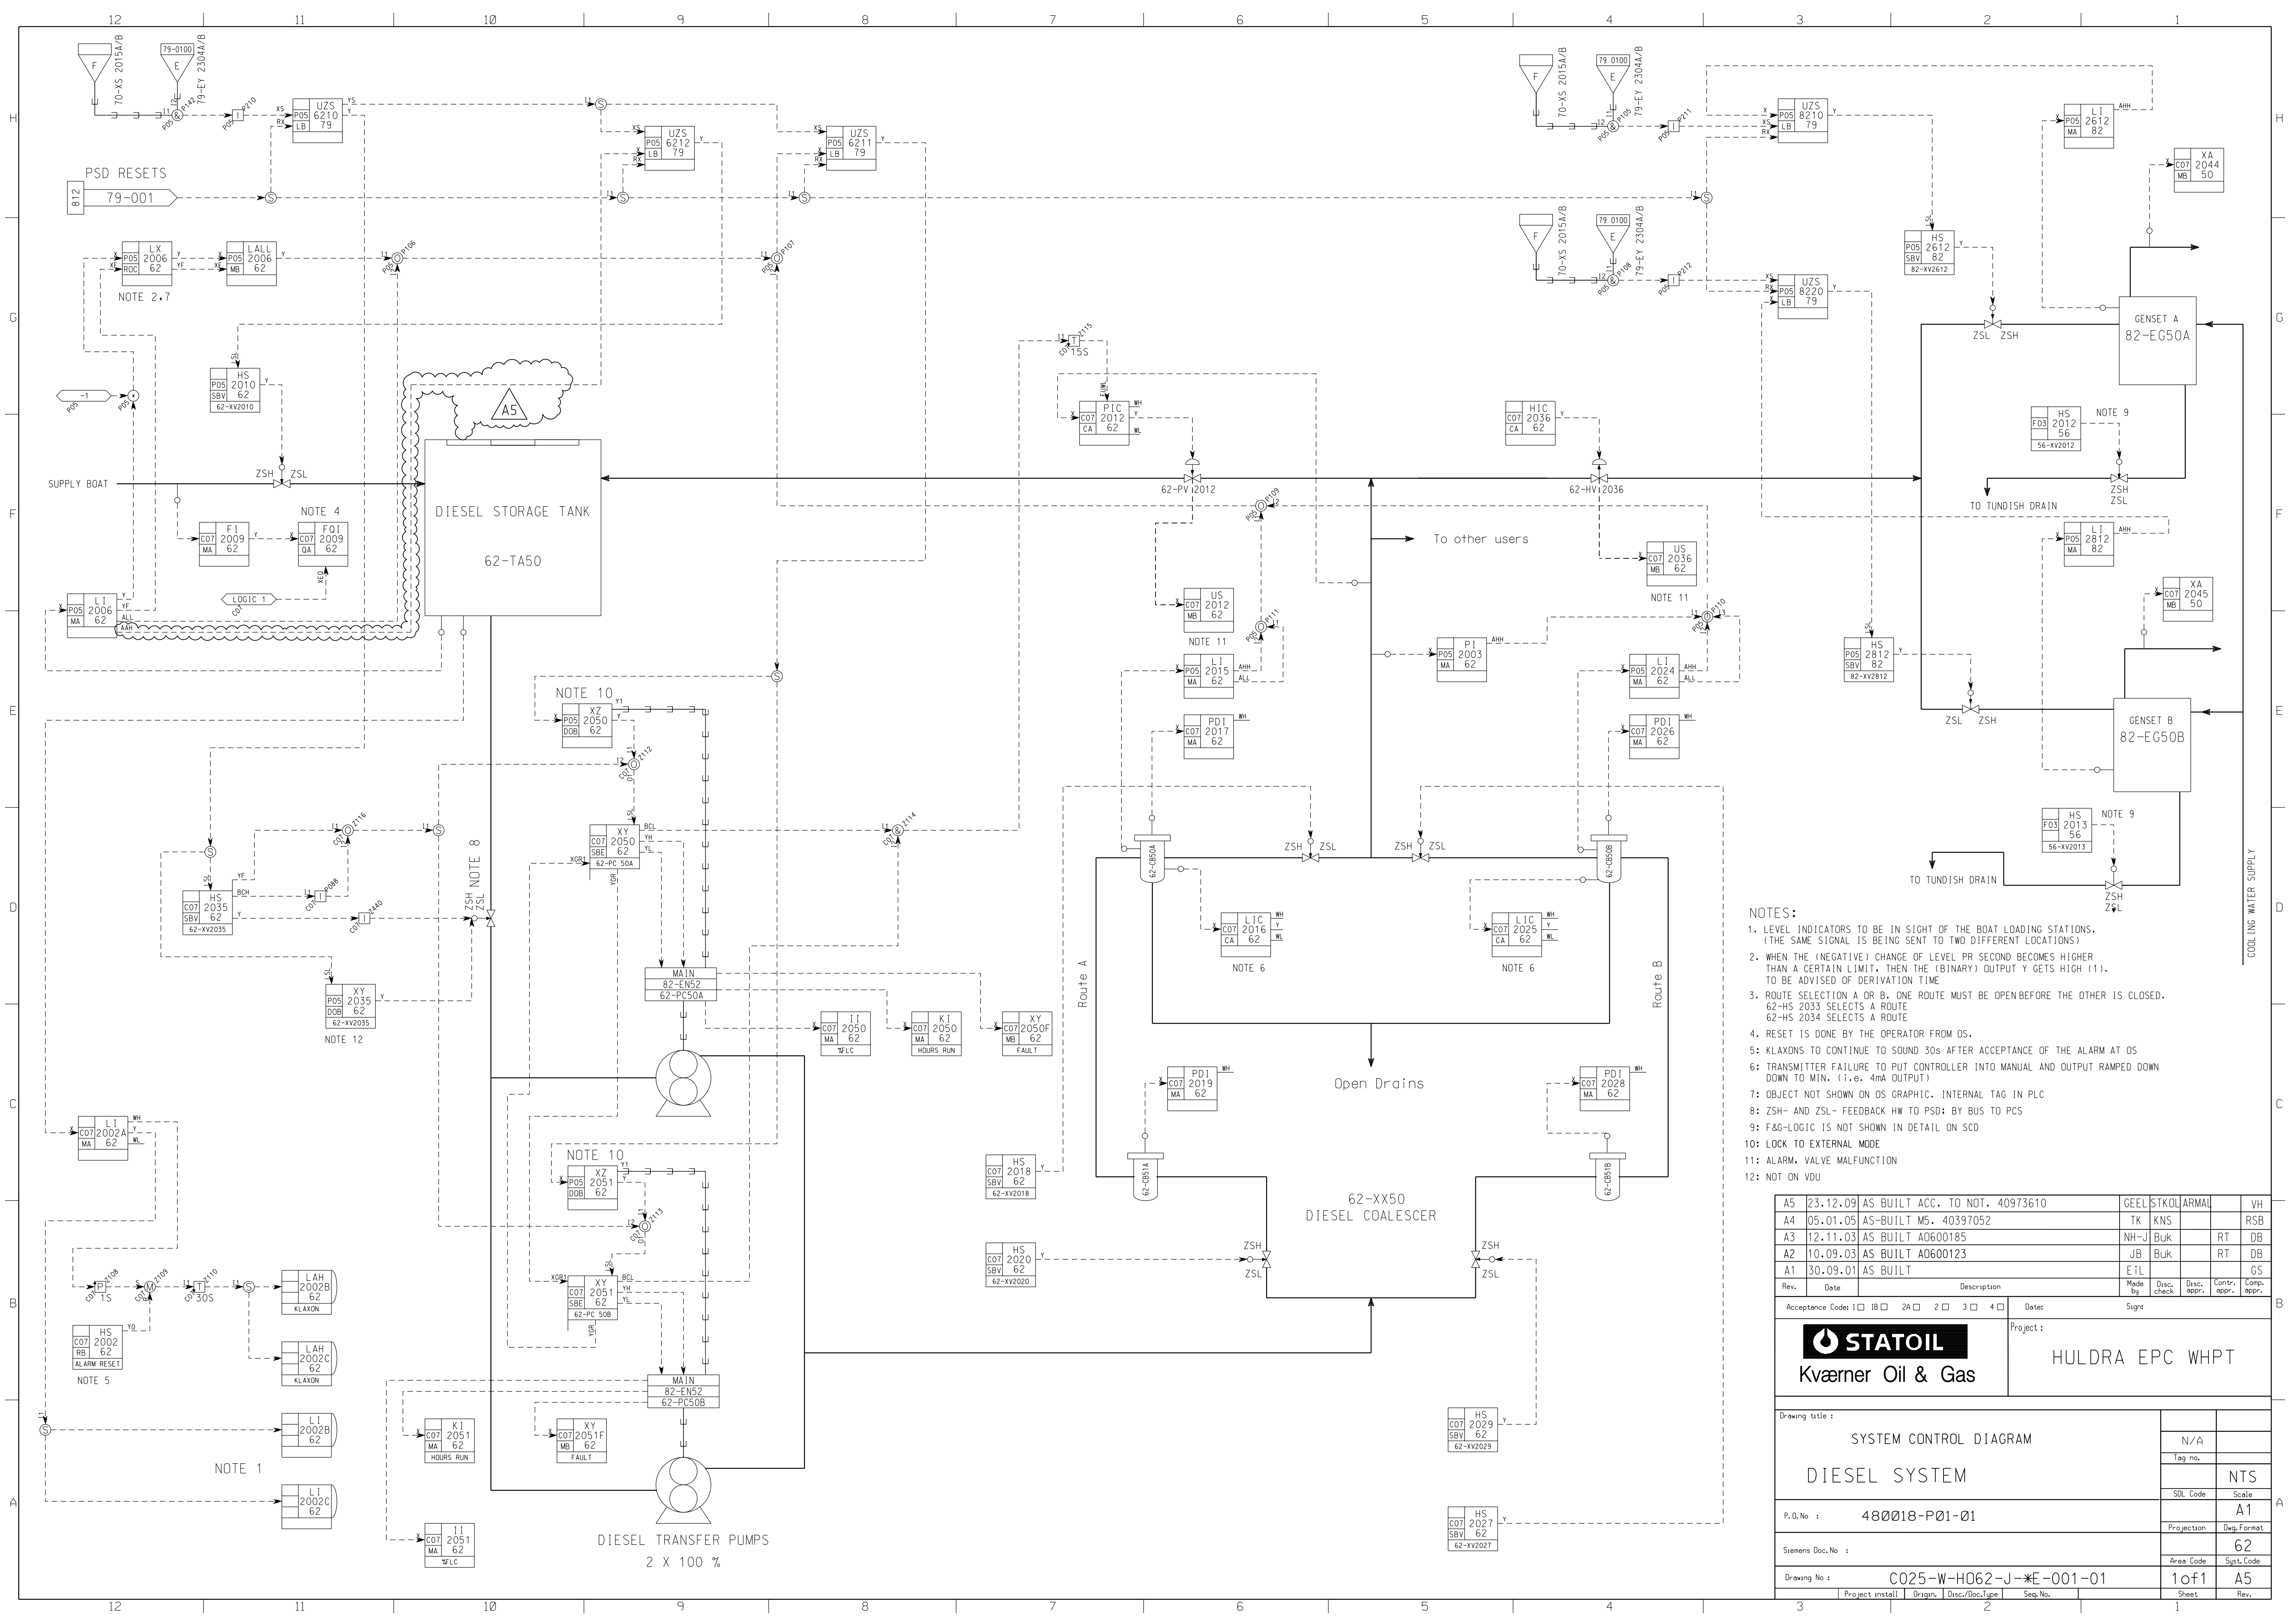

- NOTES:
1. LEVEL INDICATORS TO BE IN SIGHT OF THE BOAT LOADING STATIONS. (THE SAME SIGNAL IS BEING SENT TO TWO DIFFERENT LOCATIONS)
 2. WHEN THE (NEGATIVE) CHANGE OF LEVEL PR SECOND BECOMES HIGHER THAN A CERTAIN LIMIT, THEN THE (BINARY) OUTPUT Y GETS HIGH (1). TO BE ADVISED OF DERIVATION TIME
 3. ROUTE SELECTION A OR B. ONE ROUTE MUST BE OPEN BEFORE THE OTHER IS CLOSED. 62-HS 2033 SELECTS A ROUTE 62-HS 2034 SELECTS A ROUTE
 4. RESET IS DONE BY THE OPERATOR FROM OS.
 5. KLAXONS TO CONTINUE TO SOUND 30s AFTER ACCEPTANCE OF THE ALARM AT OS
 6. TRANSMITTER FAILURE TO PUT CONTROLLER INTO MANUAL AND OUTPUT RAMPED DOWN TO MIN. (i.e. 4mA OUTPUT)
 7. OBJECT NOT SHOWN ON OS GRAPHIC. INTERNAL TAG IN PLC
 8. ZSH- AND ZSL- FEEDBACK HW TO PSD; BY BUS TO PCS
 9. F&G-LOGIC IS NOT SHOWN IN DETAIL ON SCD
 10. LOCK TO EXTERNAL MODE
 - 11: ALARM, VALVE MALFUNCTION
 - 12: NOT ON VDU

A5	23.12.09	AS BUILT ACC. TO NOT. 40973610	GEELSTKOL	ARMAU		VH
A4	05.01.05	AS-BUILT M5. 40397052	TK	KNS		RSB
A3	12.11.03	AS BUILT A0600185	NH-J	Buk		RT DB
A2	10.09.03	AS BUILT A0600123	JB	Buk		RT DB
A1	30.09.01	AS BUILT	EiL			GS
Rev.	Date	Description	Made by	Disc. check	Disc. appr.	Contr. appr.
Acceptance Codes: 1 ☐ 1B ☐ 2A ☐ 2 ☐ 3 ☐ 4 ☐			Date: _____ Sign: _____			
 Kværner Oil & Gas			Project : HULDRA EPC WHPT			
Drawing title : SYSTEM CONTROL DIAGRAM DIESEL SYSTEM						
P.O. No : 480018-P01-01			N/A		Tag no.	
Siemens Doc.No :			SDI Code		Scale	
			Projection		Dwg.Format	
			Area Code		Syst.Code	
Drawing No : C025-W-H062-J-*E-001-01			1 of 1		A5	
Project install		Origin	Disc./Doc./Type		Seq. No.	
Sheet		1 of 1		Rev.		