


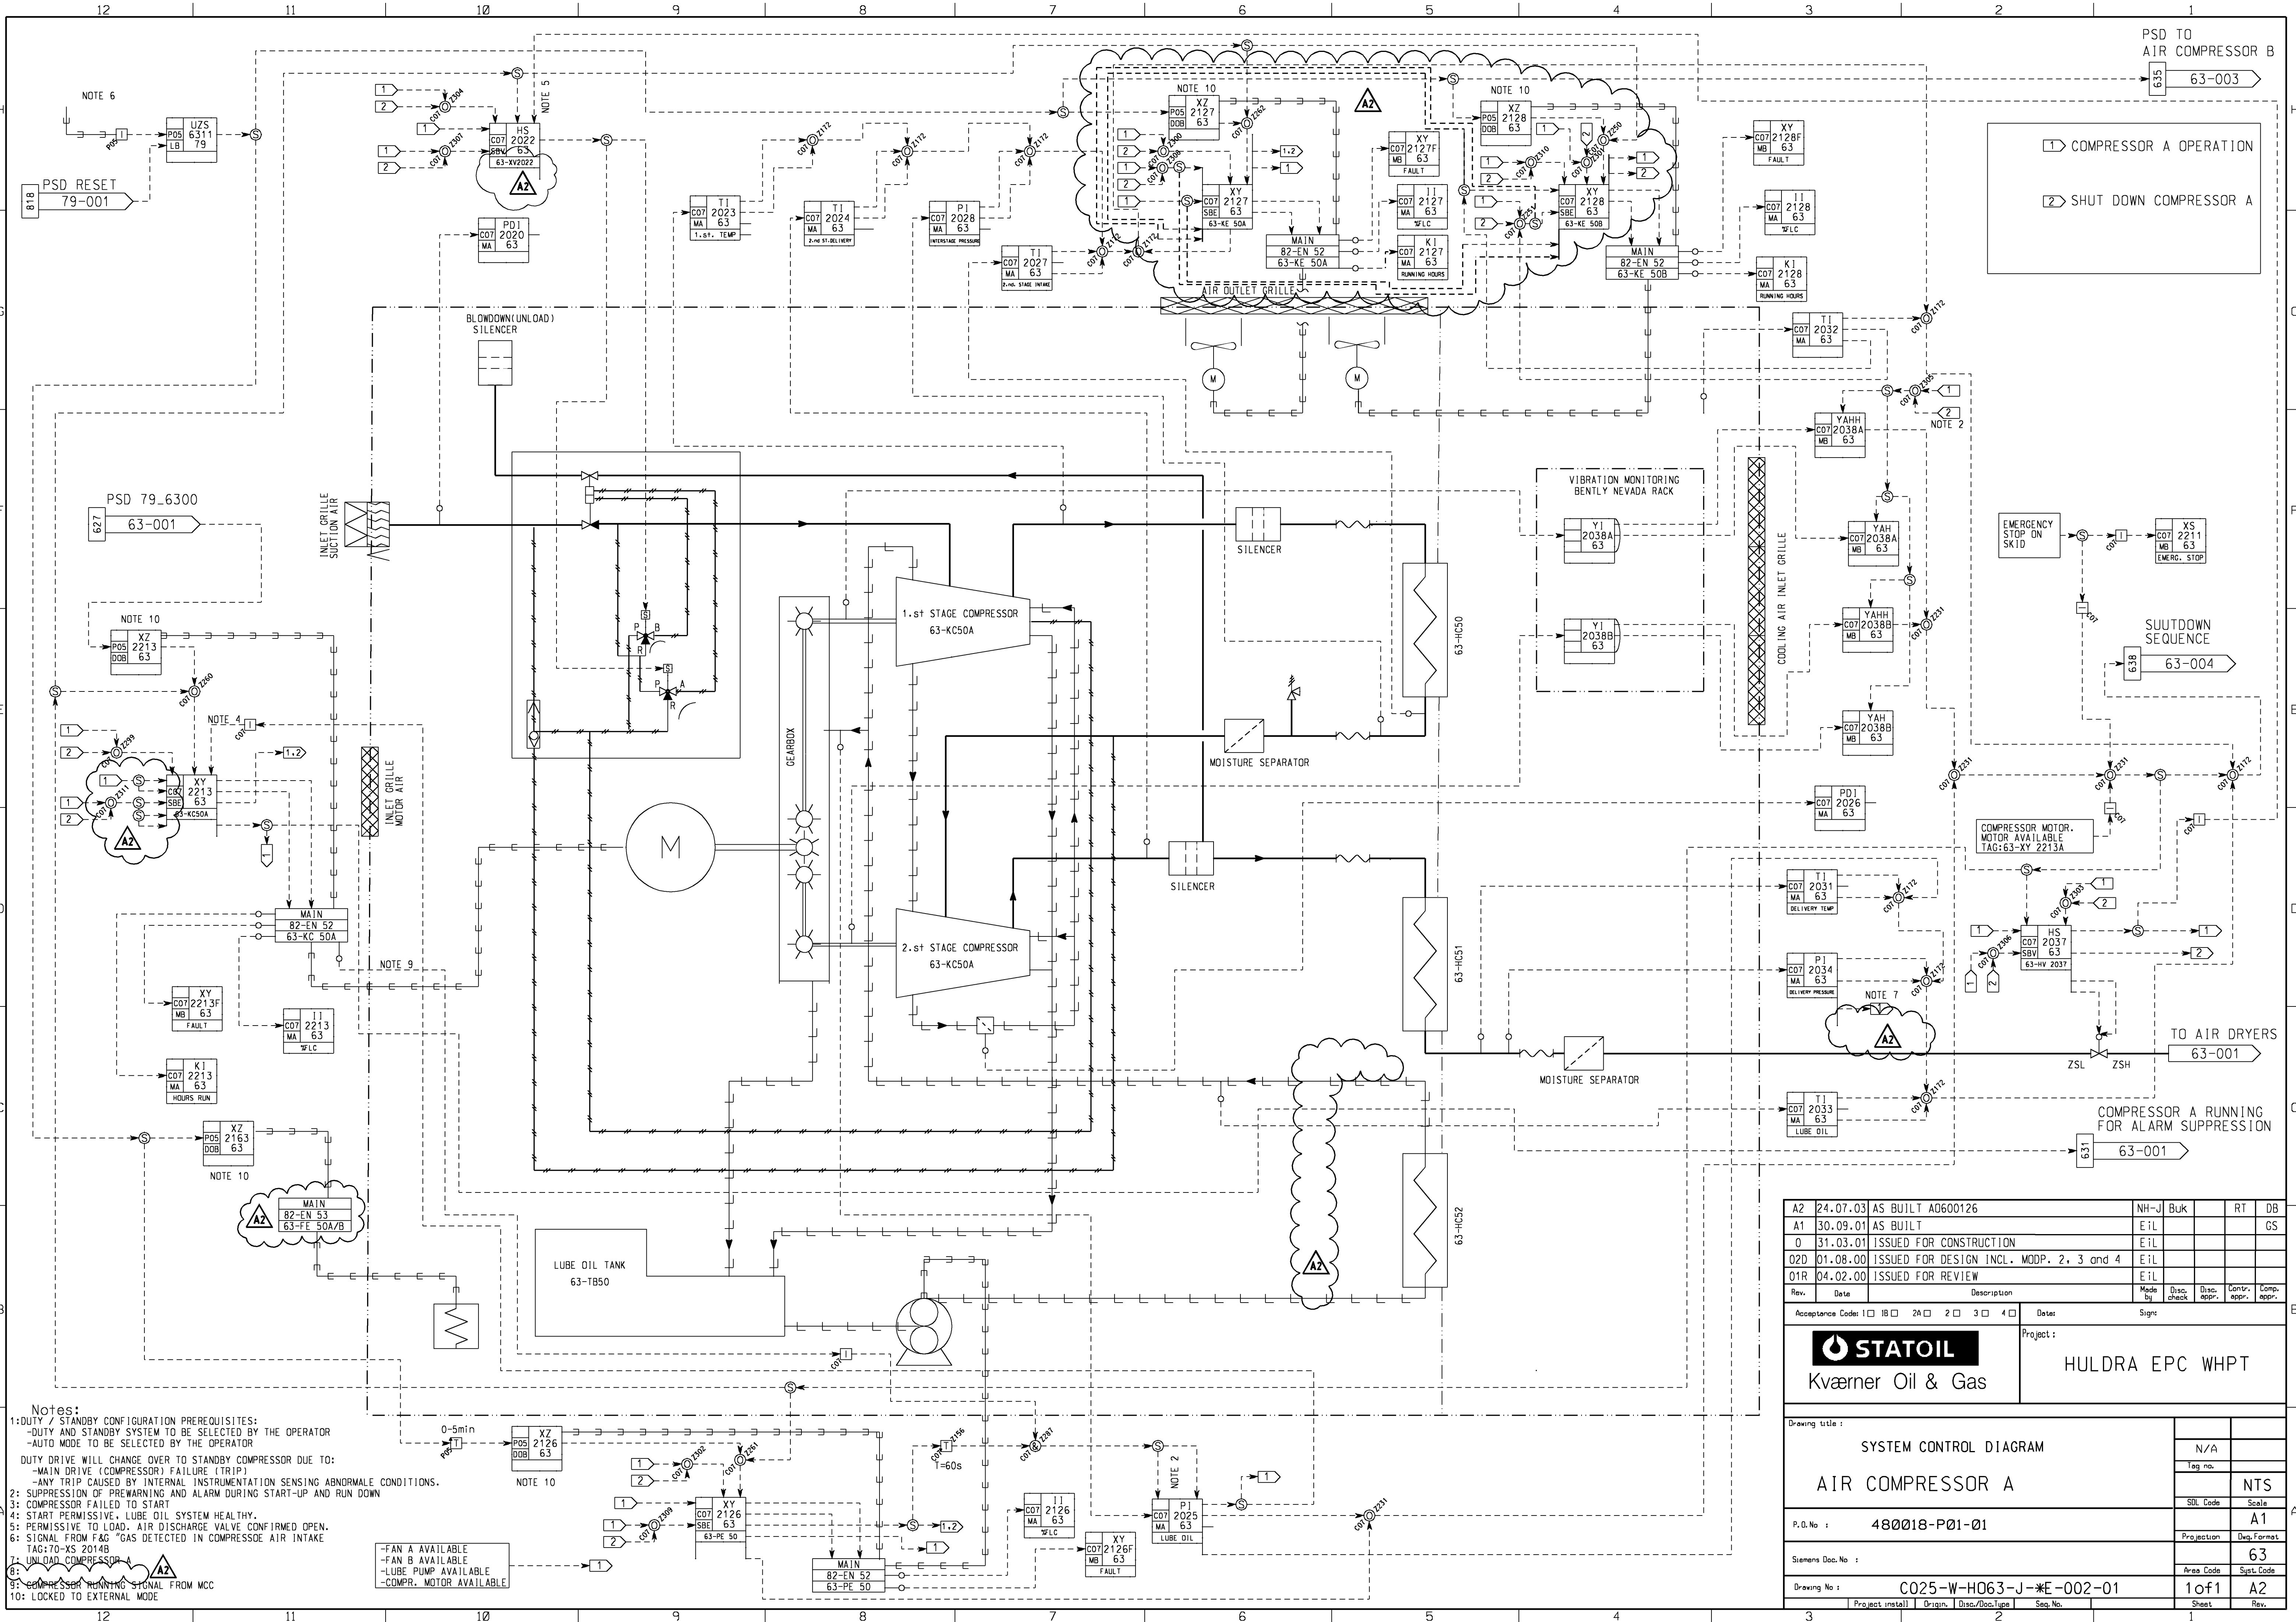

Notes:
1: DUTY / STANDBY CONFIGURATION PREREQUISITES:
- DUTY AND STANDBY SYSTEM TO BE SELECTED BY THE OPERATOR
- AUTO MODE TO BE SELECTED BY THE OPERATOR
DUTY DRIVE WILL CHANGE OVER TO STANDBY COMPRESSOR DUE TO:
- MAIN DRIVE (COMPRESSOR) FAILURE (TRIP)
- ANY TRIP CAUSED BY INTERNAL INSTRUMENTATION SENSING ABNORMAL CONDITIONS.
2: SUPPRESSION OF PREWARNING AND ALARM DURING START-UP AND RUN DOWN
3: COMPRESSOR FAILED TO START
4: START PERMISSIVE, LUBE OIL SYSTEM HEALTHY.
5: PERMISSIVE TO LOAD, AIR DISCHARGE VALVE CONFIRMED OPEN.
6: SIGNAL FROM F&G "GAS DETECTED IN COMPRESSOR AIR INTAKE TAG:70-XS 2014B"
7: UNLOAD COMPRESSOR A
8: COMPRESSOR RUNNING SIGNAL FROM MCC
10: LOCKED TO EXTERNAL MODE

-FAN A AVAILABLE
-FAN B AVAILABLE
-LUBE PUMP AVAILABLE
-COMPR. MOTOR AVAILABLE

A2	24.07.03	AS BUILT A0600126	NH-J	Buk		RT	DB
A1	30.09.01	AS BUILT	EiL				GS
0	31.03.01	ISSUED FOR CONSTRUCTION	EiL				
02D	01.08.00	ISSUED FOR DESIGN INCL. MODP. 2, 3 and 4	EiL				
01R	04.02.00	ISSUED FOR REVIEW	EiL				
Rev.	Date	Description	Mod. by	Disc. check	Disc. appr.	Contr. appr.	Comp. appr.
Acceptance Codes: 1 0 1B 0 2A 0 2 0 3 0 4 0			Signs				
Project:			HULDRA EPC WHPT				
Drawing title:			SYSTEM CONTROL DIAGRAM				
AIR COMPRESSOR A			N/A				
P.O. No.:			480018-P01-01				
Siemens Doc. No.:			63				
Drawing No.:			C025-W-H063-J-#E-002-01				
Project install			Origin	Disc./Doc. type	Seq. No.	Sheet	Rev.
						1 of 1	A2