


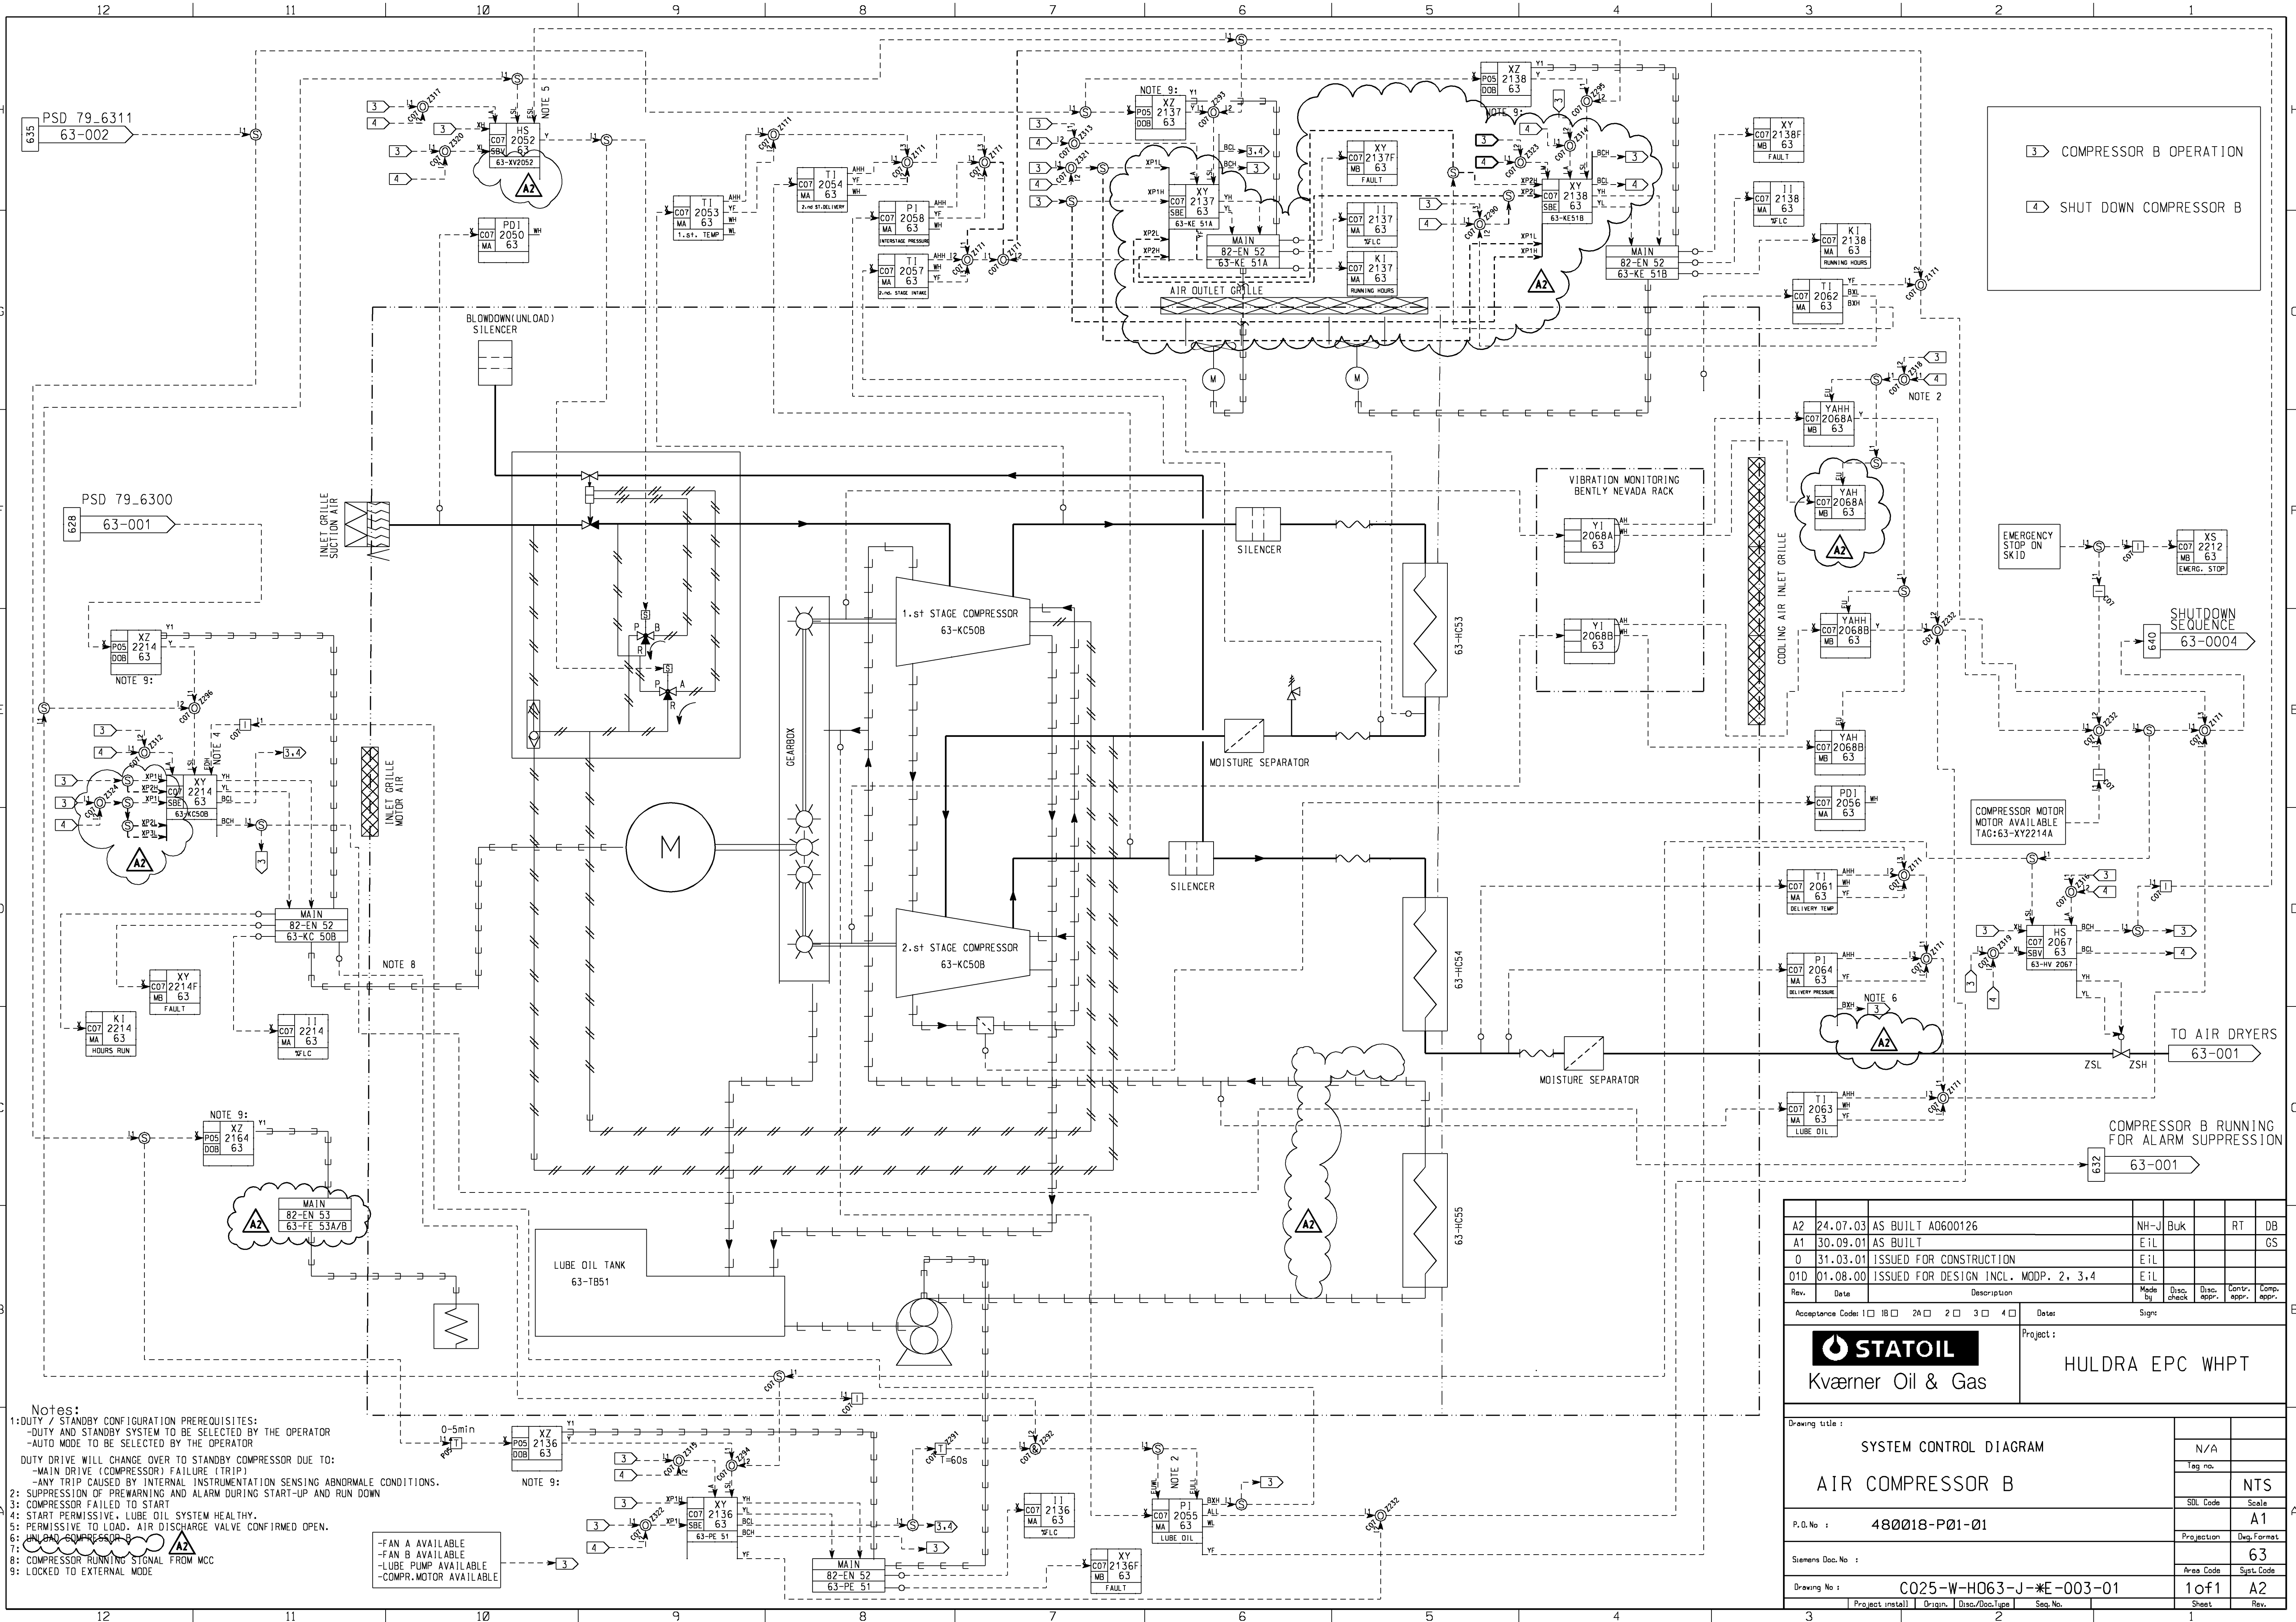

Notes:  
1: DUTY / STANDBY CONFIGURATION PREREQUISITES:  
-DUTY AND STANDBY SYSTEM TO BE SELECTED BY THE OPERATOR  
-AUTO MODE TO BE SELECTED BY THE OPERATOR  
DUTY DRIVE WILL CHANGE OVER TO STANDBY COMPRESSOR DUE TO:  
-MAIN DRIVE (COMPRESSOR) FAILURE (TRIP)  
-ANY TRIP CAUSED BY INTERNAL INSTRUMENTATION SENSING ABNORMAL CONDITIONS.  
2: SUPPRESSION OF PREWARNING AND ALARM DURING START-UP AND RUN DOWN  
3: COMPRESSOR FAILED TO START  
4: START PERMISSIVE, LUBE OIL SYSTEM HEALTHY.  
5: PERMISSIVE TO LOAD, AIR DISCHARGE VALVE CONFIRMED OPEN.  
6: UNLOCK COMPRESSOR  
7: UNLOCK COMPRESSOR  
8: COMPRESSOR RUNNING SIGNAL FROM MCC  
9: LOCKED TO EXTERNAL MODE

-FAN A AVAILABLE  
-FAN B AVAILABLE  
-LUBE PUMP AVAILABLE  
-COMPR. MOTOR AVAILABLE

|                                                                                                            |          |                                       |                                  |             |                |              |             |
|------------------------------------------------------------------------------------------------------------|----------|---------------------------------------|----------------------------------|-------------|----------------|--------------|-------------|
| A2                                                                                                         | 24.07.03 | AS BUILT A0600126                     | NH-J                             | Buk         |                | RT           | DB          |
| A1                                                                                                         | 30.09.01 | AS BUILT                              | EiL                              |             |                |              | CS          |
| 0                                                                                                          | 31.03.01 | ISSUED FOR CONSTRUCTION               | EiL                              |             |                |              |             |
| 01D                                                                                                        | 01.08.00 | ISSUED FOR DESIGN INCL. MODP. 2, 3, 4 | EiL                              |             |                |              |             |
| Rev.                                                                                                       | Date     | Description                           | Made by                          | Disc. check | Disc. appr.    | Contr. appr. | Comp. appr. |
| Acceptance Codes: 1 0 1B 0 2A 0 2 0 3 0 4 0                                                                |          |                                       | Signs:                           |             |                |              |             |
| <br>Kværner Oil & Gas |          |                                       | Project :<br><br>HULDRA EPC WHPT |             |                |              |             |
|                                                                                                            |          |                                       |                                  |             |                |              |             |
| Drawing title :                                                                                            |          |                                       |                                  |             |                |              |             |
| SYSTEM CONTROL DIAGRAM                                                                                     |          |                                       | N/A                              |             |                |              |             |
|                                                                                                            |          |                                       | Tag no.                          |             |                |              |             |
| AIR COMPRESSOR B                                                                                           |          |                                       | NTS                              |             |                |              |             |
|                                                                                                            |          |                                       | SOL Code                         |             |                |              |             |
| P.O. No. : 480018-P01-01                                                                                   |          |                                       | A1                               |             |                |              |             |
|                                                                                                            |          |                                       | Projection                       |             |                |              |             |
| Siemens Doc. No. :                                                                                         |          |                                       | 63                               |             |                |              |             |
|                                                                                                            |          |                                       | Area Code                        |             |                |              |             |
| Drawing No. : C025-W-H063-J-WE-003-01                                                                      |          |                                       | 1 of 1                           |             |                |              |             |
|                                                                                                            |          |                                       | A2                               |             |                |              |             |
| Project install                                                                                            |          |                                       | Origin                           |             | Disc./Doc.Type |              | Seq. No.    |
| 3                                                                                                          |          |                                       | 2                                |             | 1              |              |             |
|                                                                                                            |          |                                       |                                  |             | Sheet          |              | Rev.        |