




AIR COMPRESSOR A

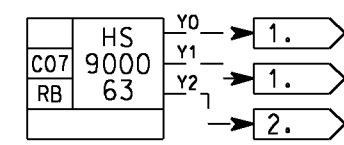


COMPRESSOR A, SHUTDOWN SEQUENCE

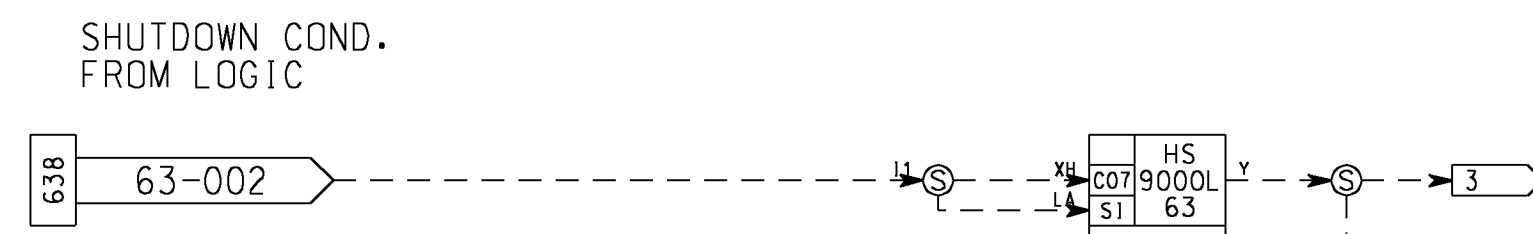


COMPRESSOR A, OPERATION SEQUENCE

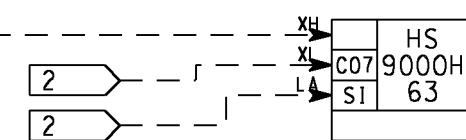

AVAILABLE FLAGS, COMPRESSOR A

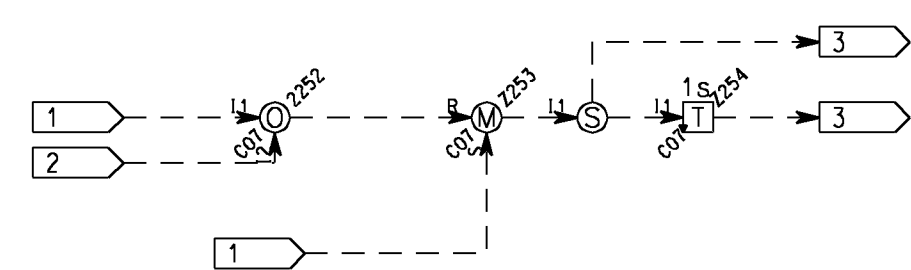


TIMERS USED IN SEQUENCE 1 AND 2

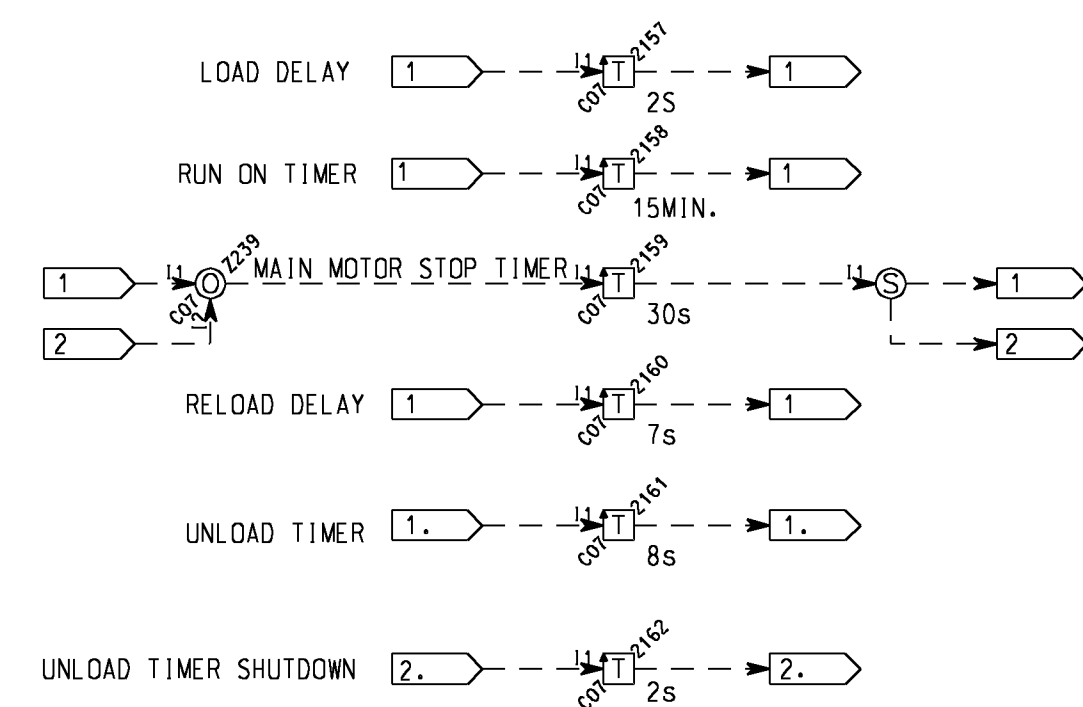


SEQUENCE 1: COMPRESSOR A OPERATION
SEQUENCE 2: SHUT DOWN COMPRESSOR A
SEQUENCE 3: COMPRESSOR B OPERATION
SEQUENCE 4: SHUT DOWN COMPRESSOR B


AIR COMPRESSOR B

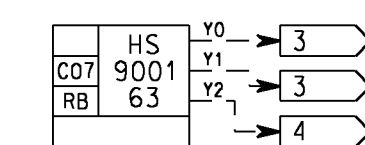


COMPRESSOR B, SHUTDOWN SEQUENCE

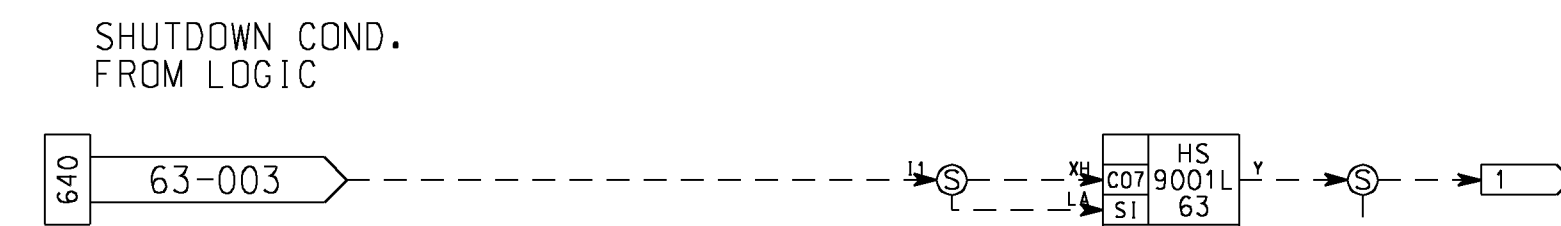


COMPRESSOR B, OPERATION SEQUENCE

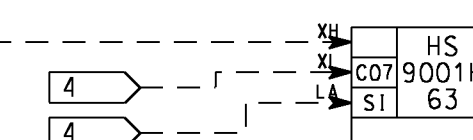

AVAILABLE FLAGS, COMPRESSOR B

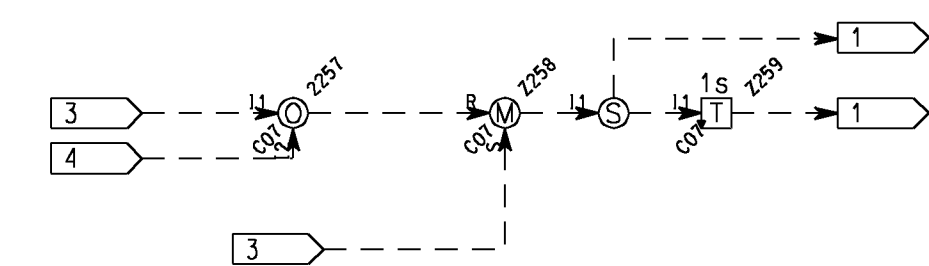

TIMERS USED IN SEQUENCE 3 AND 4

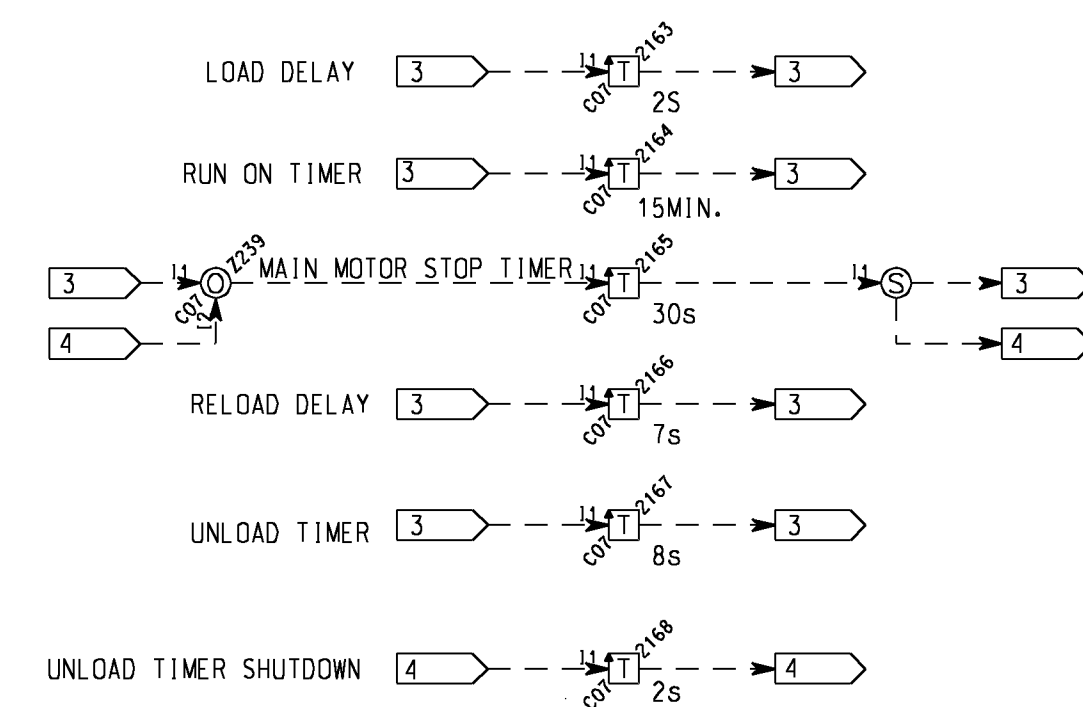

A1	30.09.01	AS BUILT				EIL			GS
0	31.03.01	ISSUED FOR CONSTRUCTION				EIL			
01D	15.11.00	ISSUED FOR DESIGN				EIL			
Rev.	Date	Description				Made by	Disc. check	Disc. appr.	Contr. appr.
Acceptance Code: I ☐ IB ☐ 2A ☐ 2 ☐ 3 ☐ 4 ☐						Sign:			
 STATOIL Kværner Oil & Gas						Project :			
						HULDRA EPC WHPT			
Drawing title :									
SYSTEM CONTROL DIAGRAM									
							N/A		
AIR COMPRESSORS, SEQUENCE CO							Tag no.		
									NTS
P.O.No : 480018-P01-01							SOL Code		Scale
									A1
Siemens Doc. No :							Projection		Dwg.Format
									63
C025-W-H063-J-WE-004-01							Area Code		Syst.Code
									1 of 1
Drawing No :		Project install	Origin	Disc./Doc.Type	Seq.No.	Sheet		Asv	