


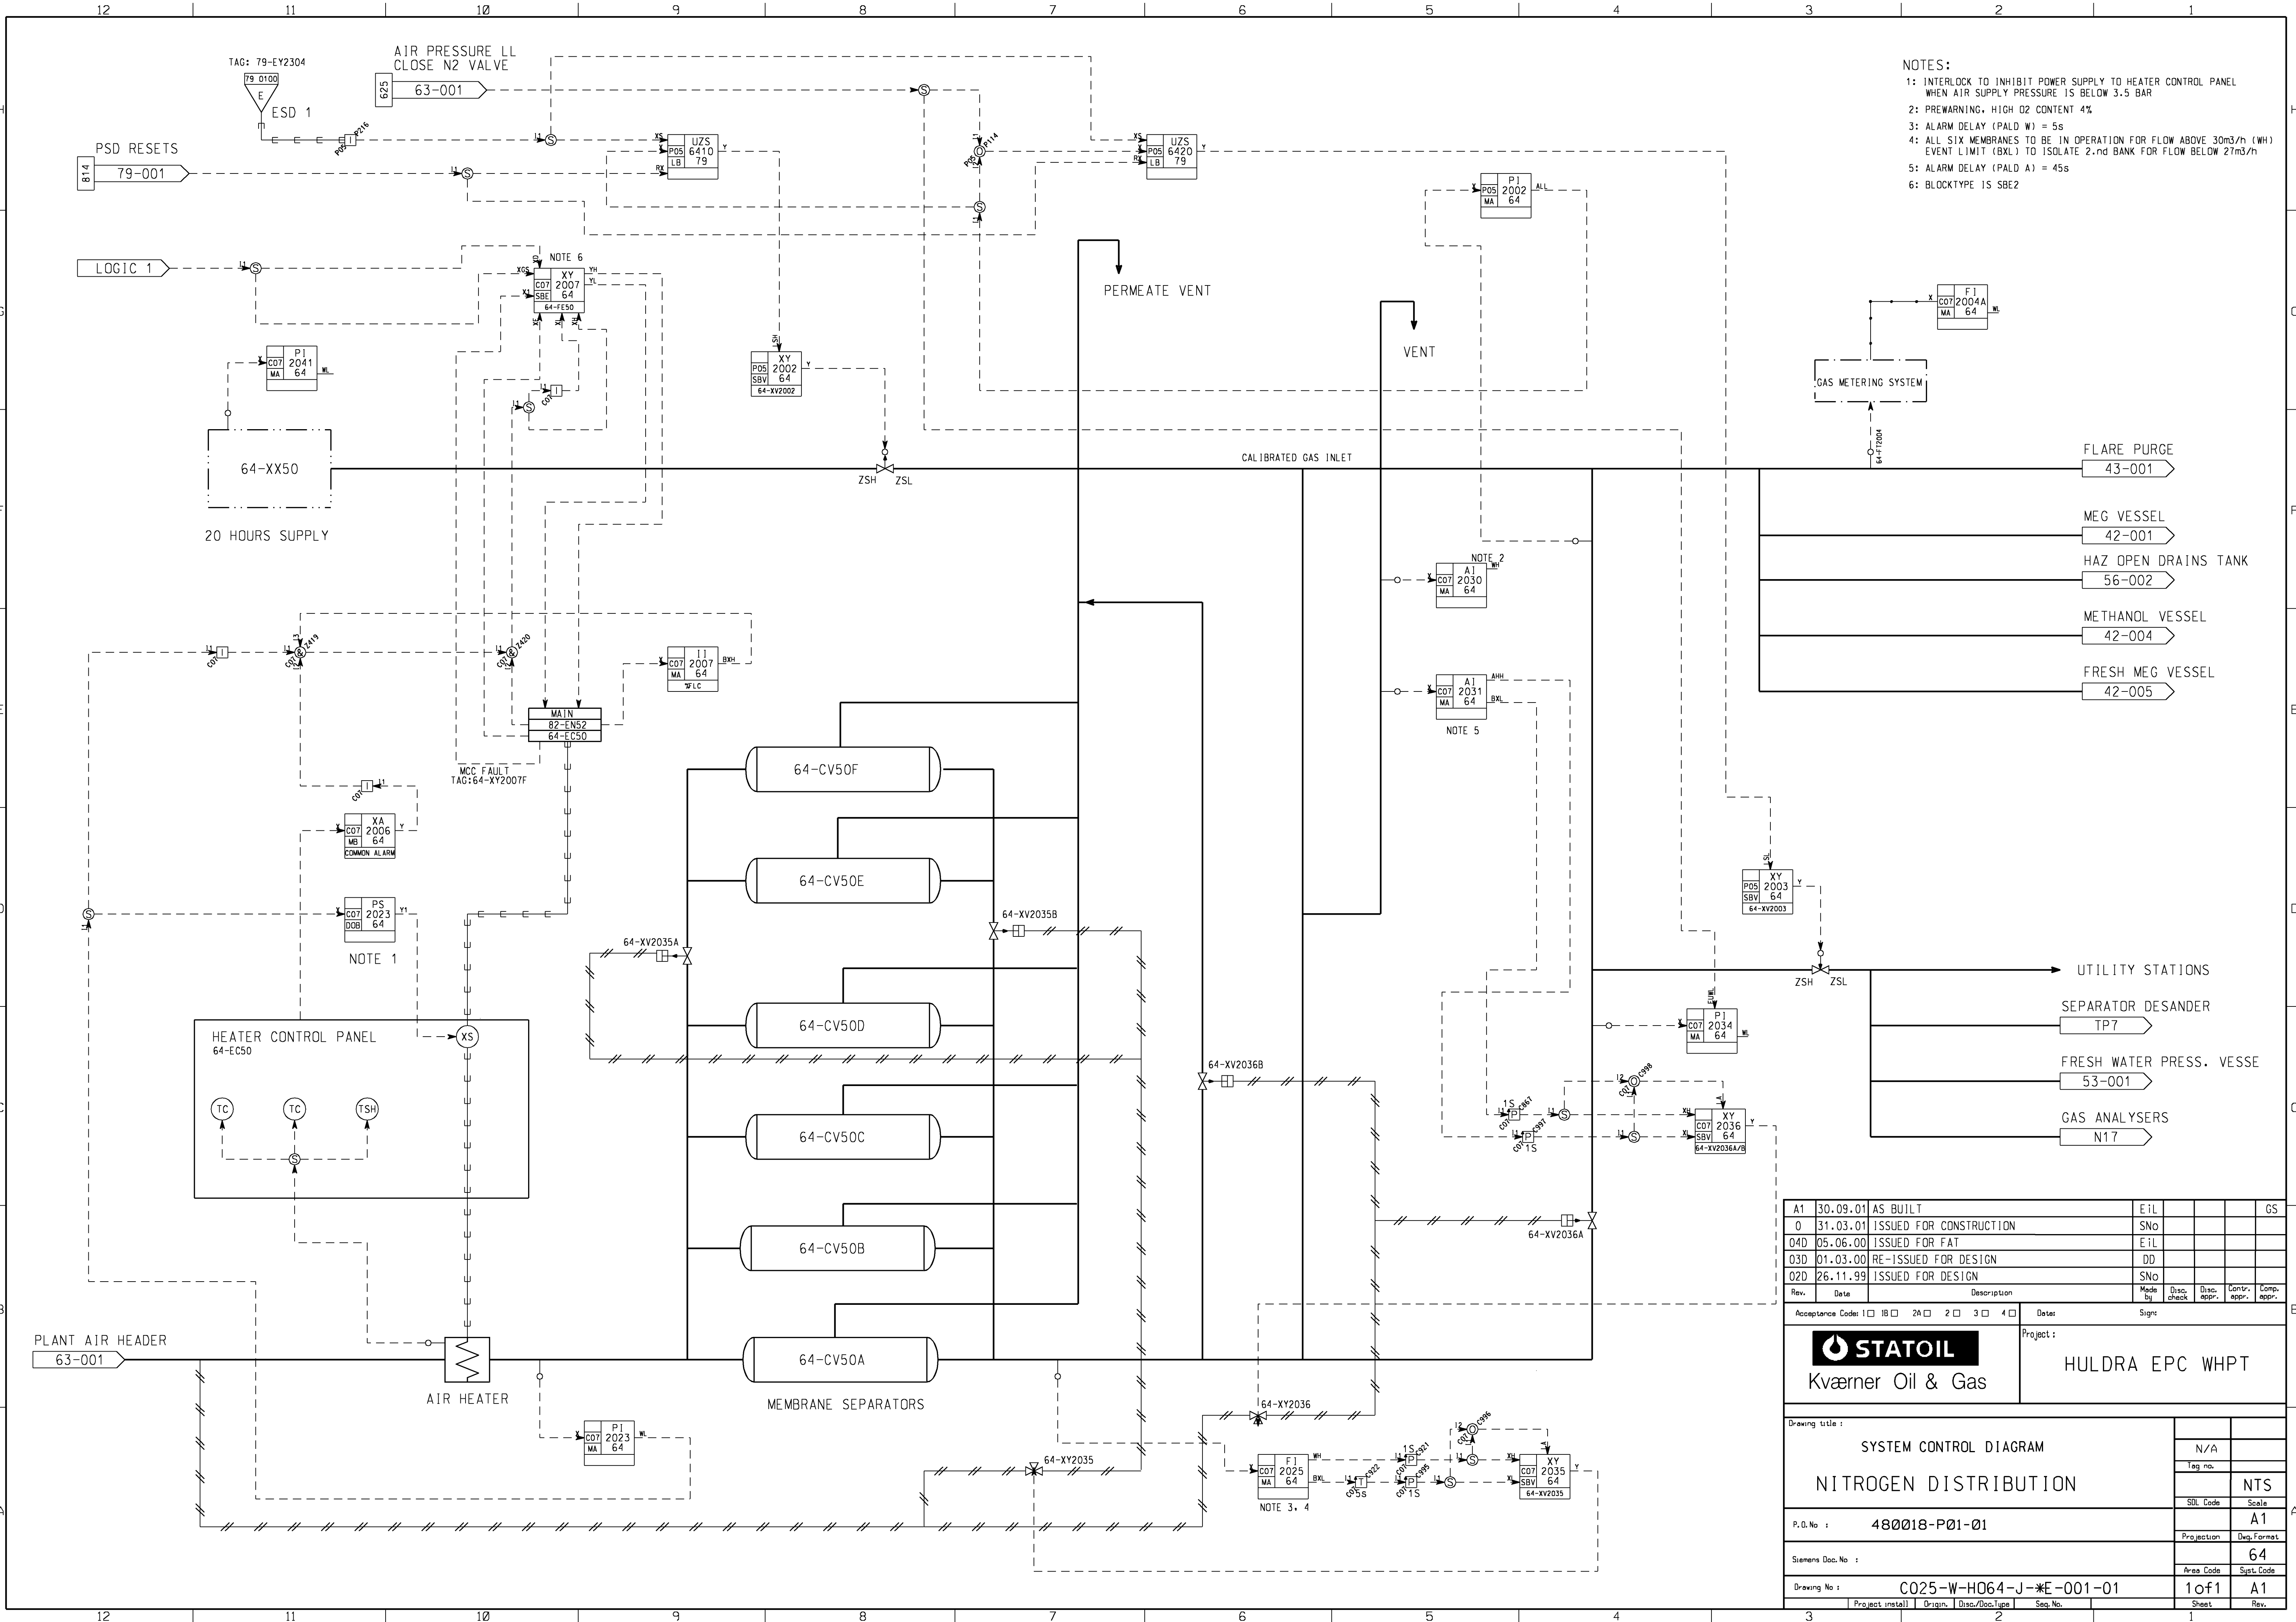

- NOTES:
- 1: INTERLOCK TO INHIBIT POWER SUPPLY TO HEATER CONTROL PANEL WHEN AIR SUPPLY PRESSURE IS BELOW 3.5 BAR
 - 2: PREWARNING, HIGH O2 CONTENT 4%
 - 3: ALARM DELAY (PALD W) = 5s
 - 4: ALL SIX MEMBRANES TO BE IN OPERATION FOR FLOW ABOVE 30m3/h (WH) EVENT LIMIT (BXL) TO ISOLATE 2.nd BANK FOR FLOW BELOW 27m3/h
 - 5: ALARM DELAY (PALD A) = 45s
 - 6: BLOCKTYPE IS SBE2

A1	30.09.01	AS BUILT	EIL				GS
0	31.03.01	ISSUED FOR CONSTRUCTION	SNo				
04D	05.06.00	ISSUED FOR FAT	EIL				
03D	01.03.00	RE-ISSUED FOR DESIGN	DD				
02D	26.11.99	ISSUED FOR DESIGN	SNo				
Rev.	Date	Description	Made by	Disc. check	Disc. appr.	Contr. appr.	Comp. appr.
Acceptance Codes: 1 0 1B 0 2A 0 2 0 3 0 4 0			Signs				
STATOIL Kværner Oil & Gas			Project: HULDRA EPC WHPT				
Drawing title:			N/A				
SYSTEM CONTROL DIAGRAM			Tag no.		NTS		
NITROGEN DISTRIBUTION			SIL Code		Scale		
P.O.No: 480018-P01-01			Projection		A1		
Siemens Doc.No:			Area Code		64		
Drawing No: C025-W-H064-J-E-001-01			1 of 1		A1		
Project install			Origin		Disc./Doc./Type		
			Seq.No.		Sheet		
					Rev.		