
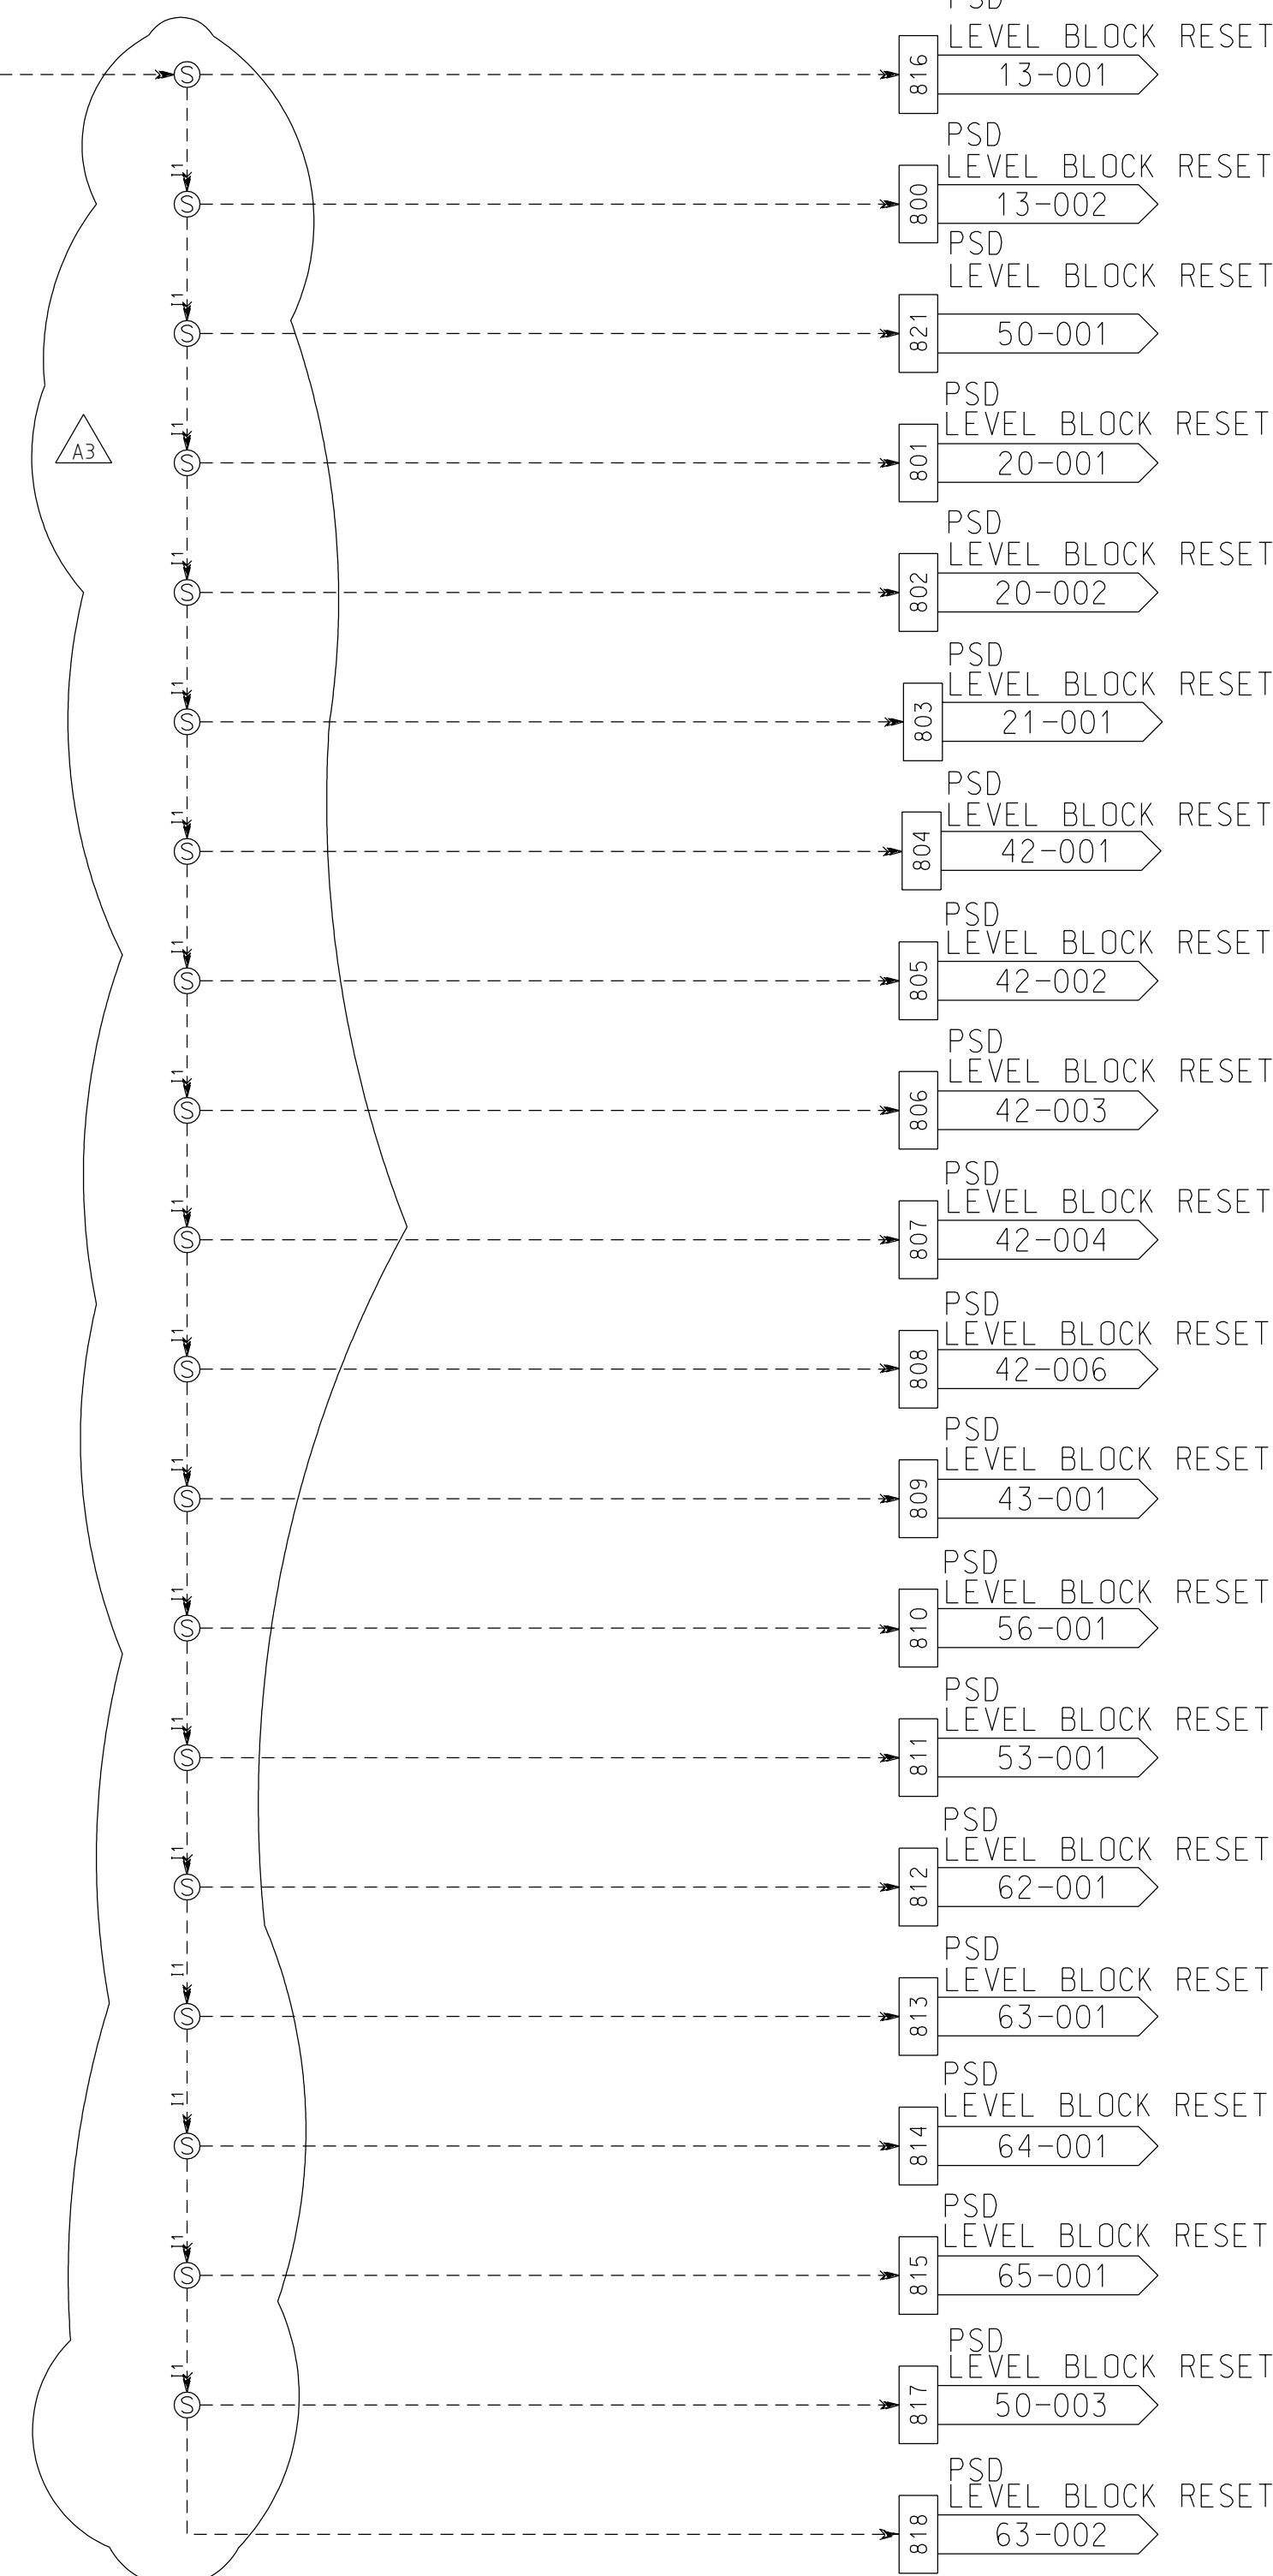
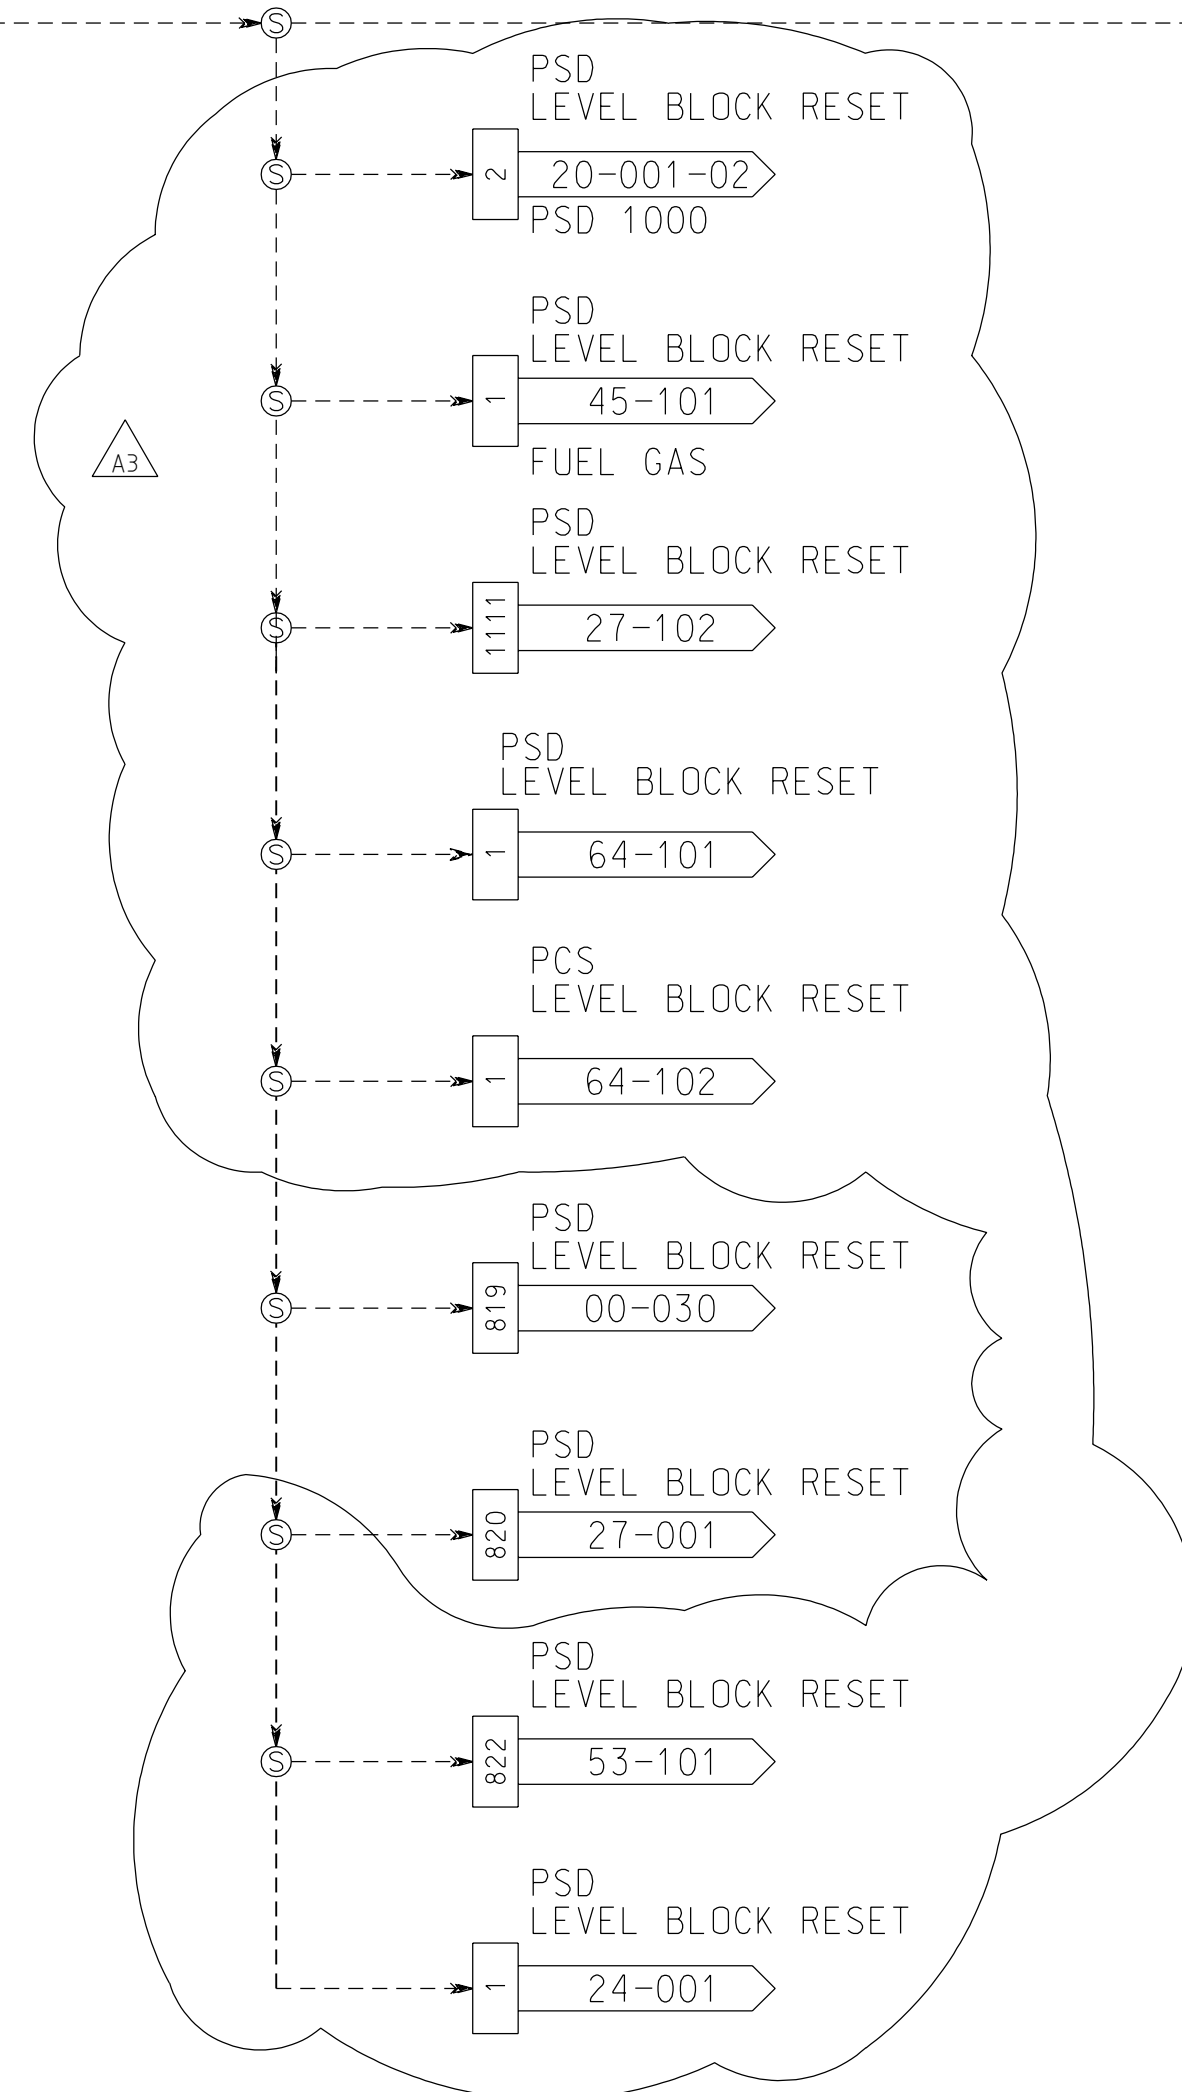
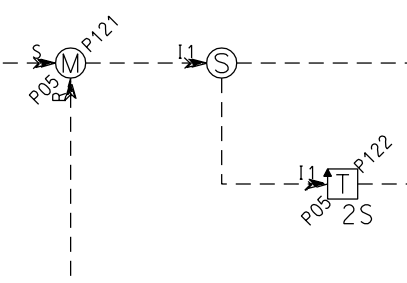


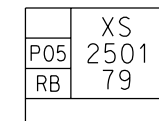

A3	16.07.2007	AS BUILT, HHP-PROJECT	MR	JOM	AB		GS
A2							
A1	30.09.01	AS BUILT	Eil				GS
0	31.03.01	ISSUED FOR CONSTRUCTION	Eil				
03D	02.06.00	ISSUED FOR FAT	Eil				
Rev.	Date	Description	Made by	Disc. check	Disc. appr.	Contr. appr.	Comp. appr.
Acceptance Codes 1 ☐ 1B ☐ 2A ☐ 2 ☐ 3 ☐ 4 ☐			Sign:				
 STATOIL Kv*rnner Oil & Gas			Project: HULDRA EPC WHPT				
Drawing title: SYSTEM CONTROL DIAGRAM PSD RESETS							N/A Tag no. NTS
P.O.No : 480018-P01-01							Scale A1
Siemens Doc. No :							Projection: Dwg.Format 79
Drawing No : C025-W-H079-J- W E-001-01							Area Code 1 of 1
Project install			Origin		Disc./Doc.Type		Seq.No.
Sheet							Rev.