


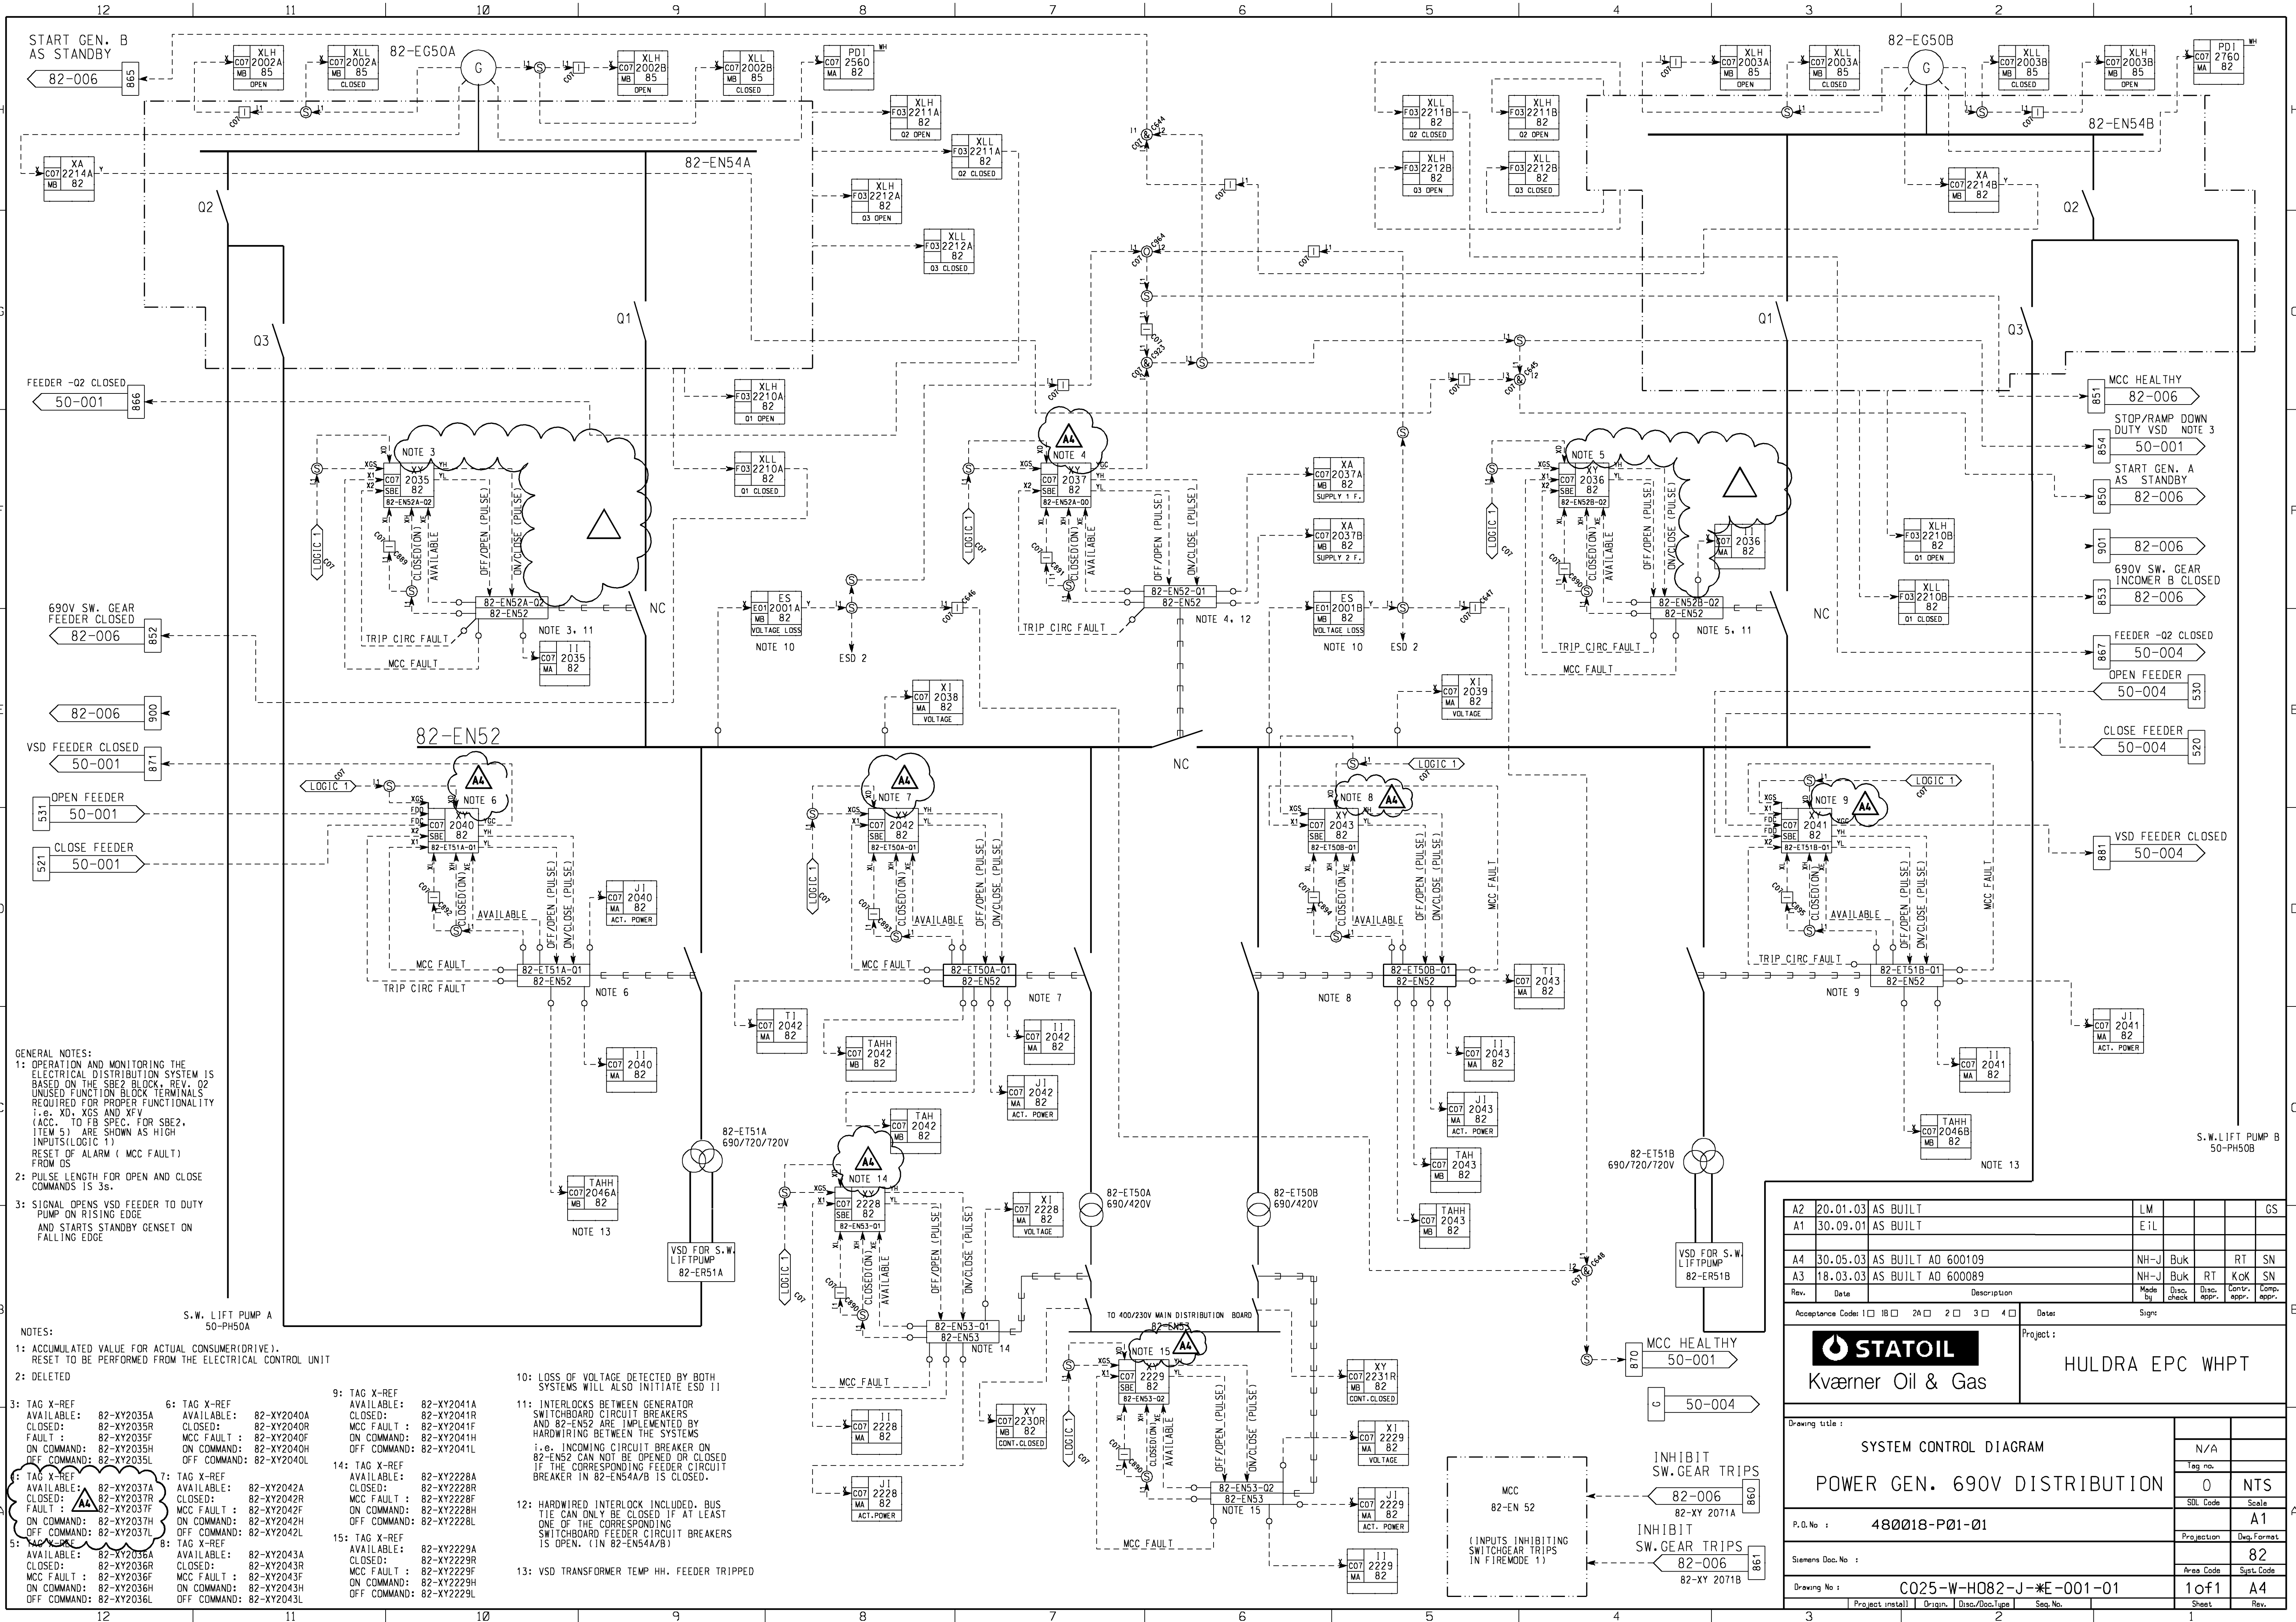

GENERAL NOTES:

1: OPERATION AND MONITORING THE ELECTRICAL DISTRIBUTION SYSTEM IS BASED ON THE SBE2 BLOCK, REV. 02 UNUSED FUNCTION BLOCK TERMINALS REQUIRED FOR PROPER FUNCTIONALITY (i.e. X0, XGS AND XYV (ITEM 5) ARE SHOWN AS HIGH INPUTS (LOGIC 1) RESET OF ALARM (MCC FAULT) FROM OS

2: PULSE LENGTH FOR OPEN AND CLOSE COMMANDS IS 3s.

3: SIGNAL OPENS VSD FEEDER TO DUTY PUMP ON RISING EDGE AND STARTS STANDBY GENSET ON FALLING EDGE

NOTES:

1: ACCUMULATED VALUE FOR ACTUAL CONSUMER(DRIVE). RESET TO BE PERFORMED FROM THE ELECTRICAL CONTROL UNIT

2: DELETED

3: TAG X-REF
AVAILABLE: 82-XY2035A
CLOSED: 82-XY2035R
FAULT: 82-XY2035F
ON COMMAND: 82-XY2035H
OFF COMMAND: 82-XY2035L

6: TAG X-REF
AVAILABLE: 82-XY2040A
CLOSED: 82-XY2040R
FAULT: 82-XY2040F
ON COMMAND: 82-XY2040H
OFF COMMAND: 82-XY2040L

7: TAG X-REF
AVAILABLE: 82-XY2042A
CLOSED: 82-XY2042R
FAULT: 82-XY2042F
ON COMMAND: 82-XY2042H
OFF COMMAND: 82-XY2042L

8: TAG X-REF
AVAILABLE: 82-XY2043A
CLOSED: 82-XY2043R
FAULT: 82-XY2043F
ON COMMAND: 82-XY2043H
OFF COMMAND: 82-XY2043L

9: TAG X-REF
AVAILABLE: 82-XY2041A
CLOSED: 82-XY2041R
FAULT: 82-XY2041F
ON COMMAND: 82-XY2041H
OFF COMMAND: 82-XY2041L

14: TAG X-REF
AVAILABLE: 82-XY2228A
CLOSED: 82-XY2228R
FAULT: 82-XY2228F
ON COMMAND: 82-XY2228H
OFF COMMAND: 82-XY2228L

15: TAG X-REF
AVAILABLE: 82-XY2229A
CLOSED: 82-XY2229R
FAULT: 82-XY2229F
ON COMMAND: 82-XY2229H
OFF COMMAND: 82-XY2229L

10: LOSS OF VOLTAGE DETECTED BY BOTH SYSTEMS WILL ALSO INITIATE ESD 11

11: INTERLOCKS BETWEEN GENERATOR SWITCHBOARD CIRCUIT BREAKERS AND 82-EN52 ARE IMPLEMENTED BY HARDWIRING BETWEEN THE SYSTEMS
i.e. INCOMING CIRCUIT BREAKER ON 82-EN52 CAN NOT BE OPENED OR CLOSED IF THE CORRESPONDING FEEDER CIRCUIT BREAKER IN 82-EN54A/B IS CLOSED.

12: HARDWIRED INTERLOCK INCLUDED. BUS TIE CAN ONLY BE CLOSED IF AT LEAST ONE OF THE CORRESPONDING SWITCHBOARD FEEDER CIRCUIT BREAKERS IS OPEN. (IN 82-EN54A/B)

13: VSD TRANSFORMER TEMP HH. FEEDER TRIPPED

A2	20.01.03	AS BUILT	LM				GS
A1	30.09.01	AS BUILT	E1L				
A4	30.05.03	AS BUILT AD 600109	NH-J	Buk		RT	SN
A3	18.03.03	AS BUILT AD 600089	NH-J	Buk	RT	KoK	SN
Rev.	Date	Description	Made by	Disc. check	Disc. appor.	Contr. appor.	Comp. appor.
Acceptance Codes: 1 0 1B 0 2A 0 2 0 3 0 4 0			Sign:				
 Kværner Oil & Gas			Project :				
			HULDRA EPC WHPT				
Drawing title :							
SYSTEM CONTROL DIAGRAM				N/A			
				lag no.			
POWER GEN. 690V DISTRIBUTION				0		NTS	
				SOL Code		A1	
P.O. No : 480018-P01-01							
Siemens Doc. No :				82			
				Area Code		Syst. Code	
Drawing No : C025-W-H082-J-*E-001-01				1 of 1		A4	
Project install			Origin		Disc./Doc.Type		Seq. No.
Sheet			Rev.				

3

2

1