


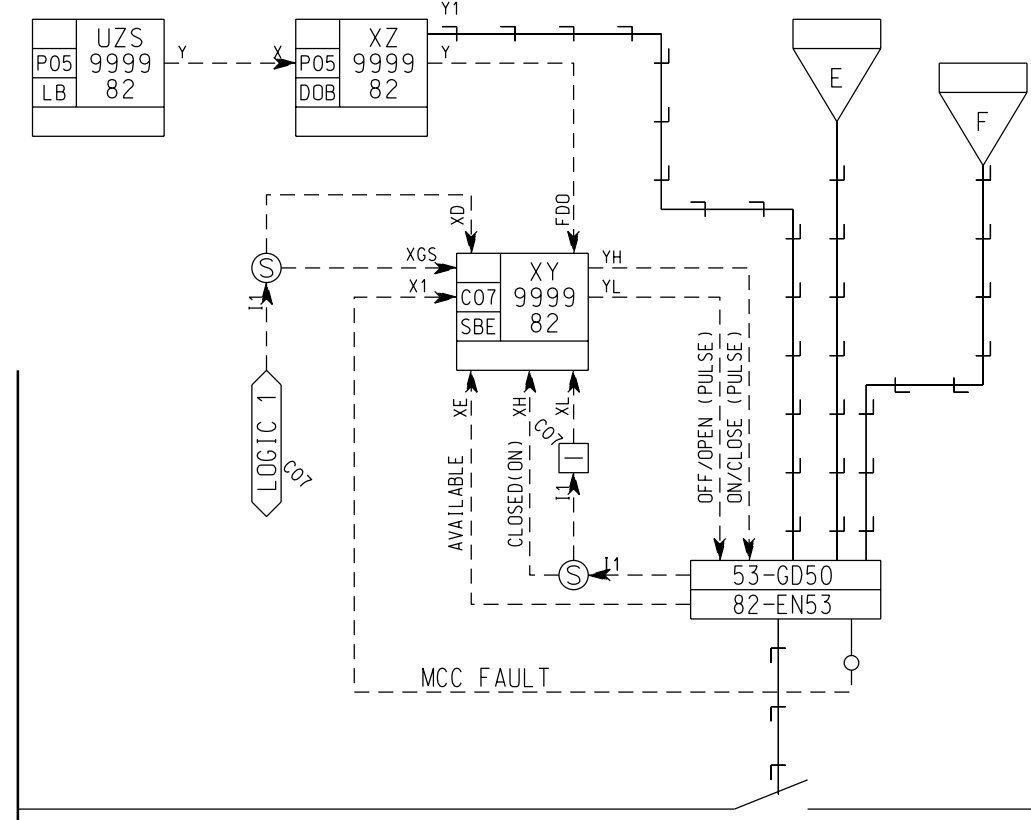

SWITCHBOARD	CONSUMER												MANNED/UNMANNED	REMARKS
	EQ. TAG	DESCRIPTION	TAG No.	AVAILABLE	ON COMMAND	OFF COMMAND	ON FEEDBACK	FAULT	CURRENT	PSD TRIP	F&G TRIP	SWITCH CONTROL		
82-EN53	73-MA50	DIESEL CRANE AUX.	73-XY 2100	73-XY 2100A	73-XY 2100H	73-XY 2100L	73-XY 2100R	73-XY 2100F			73-XY 2100			
82-EN53	82-EL50	MAIN LTG & SMALL POWER DB. 1	82-XY 2016	82-XY 2016A	82-XY 2016H	82-XY 2016L	82-XY 2016R	82-XY 2016F						
82-EN53	82-EL51	MAIN LTG & SMALL POWER DB. 2	82-XY 2017	82-XY 2017A	82-XY 2017H	82-XY 2017L	82-XY 2017R	82-XY 2017F						
82-EN53	82-EL52	PROCESS ESH DISTR. BOARD	82-XY 2018	82-XY 2018A	82-XY 2018H	82-XY 2018L	82-XY 2018R	82-XY 2018F	82-II 2018					
82-EN53	82-EL53	FROST PROT. ESH DISTR.B.	82-XY 2019	82-XY 2019A	82-XY 2019H	82-XY 2019L	82-XY 2019R	82-XY 2019F	82-II 2019					
82-EN53	82-EL54	LQ LTG & SMALL PWR DIST.BOARD	82-XY 2020	82-XY 2020A	82-XY 2020H	82-XY 2020L	82-XY 2020R	82-XY 2020F			82-XY 2020L	MANNED/UNMANNED VIA LINK		
82-EN53	82-EL55	MAIN LTG & SMALL POWER DB. 3	82-XY 2097	82-XY 2097A	82-XY 2097H	82-XY 2097L	82-XY 2097R	82-XY 2097F						
82-EN53														
82-EN53	82-EL58	WORKSHOP DISTR. BOARD	82-XY 2023	82-XY 2023A	82-XY 2023H	82-XY 2023L	82-XY 2023R	82-XY 2023F			82-XY 2023			
82-EN53	82-EL59	230V TELECOM DISTR.BOARD	82-XY 2024	82-XY 2024A	82-XY 2024H	82-XY 2024L	82-XY 2024R	82-XY 2024F						
82-EN53	82-EL60	M.O.V. DISTR. BOARD	82-XY 2025	82-XY 2025A	82-XY 2025H	82-XY 2025L	82-XY 2025R	82-XY 2025F						
82-EN53	EJ-E-HA82-09	350A MAINTENANCE JB.CELLAR DECK	82-XY 2026	82-XY 2026A	82-XY 2026H	82-XY 2026L	82-XY 2026R	82-XY 2026F			82-XY 2026			
82-EN53														
82-EN53	ES-ER-01	125A/400V SOCKET OUTL.-CELLAR DK.	82-XY 2028	82-XY 2028A	82-XY 2028H	82-XY 2028L	82-XY 2028R	82-XY 2028F			82-XY 2028			
82-EN53	ES-EW-07	63A WELDING SKT'S-ESDV PLTN	82-XY 2012	82-XY 2012A	82-XY 2012H	82-XY 2012L	82-XY 2012R	82-XY 2012F			82-XY 2012			
82-EN53	ES-EW-10	63A WELDING SKT'S-CELLAR DK.	82-XY 2013	82-XY 2013A	82-XY 2013H	82-XY 2013L	82-XY 2013R	82-XY 2013F			82-XY 2013			
82-EN53	ES-EW-13	63A WELDING SKT'S-MEZZ.DK.	82-XY 2014	82-XY 2014A	82-XY 2014H	82-XY 2014L	82-XY 2014R	82-XY 2014F			82-XY 2014			
82-EN53	ES-EW-15	63A WELDING SKT'S-MEZZ.DK.	82-XY 2015	82-XY 2015A	82-XY 2015H	82-XY 2015L	82-XY 2015R	82-XY 2015F			82-XY 2015			
82-EN53	ES-EW-01	WELDING SKT'S-UTILITY STN. 1	82-XY 2029	82-XY 2029A	82-XY 2029H	82-XY 2029L	82-XY 2029R	82-XY 2029F			82-XY 2029		OUTLETS ES-EW-01 TO -03	
82-EN53	ES-EW-04	WELDING SKT'S -UTILITY STN.2	82-XY 2030	82-XY 2030A	82-XY 2030H	82-XY 2030L	82-XY 2030R	82-XY 2030F			82-XY 2030		OUTLETS ES-EW-04 TO -06	
82-EN53														
82-EN53	ES-EW-03	WELDING SKT'S - WEATHER DECK	82-XY 2032	82-XY 2032A	82-XY 2032H	82-XY 2032L	82-XY 2032R	82-XY 2032F			82-XY 2032			
82-EN53	ES-EW-17	WELDING SKT'S -WORKSHOP	82-XY 2031	82-XY 2031A	82-XY 2031H	82-XY 2031L	82-XY 2031R	82-XY 2031F			82-XY 2031			
82-EN53														
82-EN53	82-EL40	440/230V DISTR. BOARD COMP. MODULE	82-XY 4849	82-XY 4849A	82-XY 4849H	82-XY 4849L	82-XY 4849R	82-XY 4849F			82-XY 4849			
82-EN53	82-EL41	440/230V DISTR. BOARD HCM	82-XY 2074	82-XY 2074A	82-XY 2074H	82-XY 2074L	82-XY 2074R	82-XY 2074F			82-XY 2074			
82-EN53	ES-EW-01	63A WELDING SKT'S - COMP. MODULE	82-XY 4895	82-XY 4895A	82-XY 4895H	82-XY 4895L	82-XY 4895R	82-XY 4895F			82-XY 4895		OUTLETS ES-EW-01 TO -03	
82-EN53														

SWITCHBOARD	DESCRIPTION	EQ. TAG	F&G TRIP TAG	ON/OFF CONTROL	REMARKS
82-EL50	TRIP FEEDER CIRCUIT 1	ES-EF-01	82-XY 2064		16A/220V OUTLETS UTILITY STN. 3 - OUTLET ES-EF-01 AND 02
82-EL50	TRIP FEEDER CIRCUIT 3		82-XY 2053		
82-EL51	TRIP FEEDER CIRCUIT 1		82-XY 2054		
82-EL51	TRIP FEEDER CIRCUIT 2		82-XY 2055		
82-EL51	TRIP FEEDER CIRCUIT 5	76-ET054	76-XY 2007		MOB BOAT BATTERY CHARGER
82-EL51	ALARM FEEDER CIRCUIT 5		82-XA 2074		MOB BOAT BATTERY CHARGER FEEDER OUT
82-EL51	TRIP FEEDER CIRCUIT 19	ES-EF-01	82-XY 2065		16A/220V OUTLETS UTILITY STN. 1 - OUTLET ES-EF-01 AND 02
82-EL55	TRIP FEEDER CIRCUIT 1		82-XY 2056		
82-EL55	TRIP FEEDER CIRCUIT 2	ES-EF-01	82-XY 2066		16A/220V OUTLETS UTILITY STN. 3 - OUTLET ES-EF-01 AND 02
82-EL55	TRIP FEEDER CIRCUIT 3	ES-EF-01	82-XY 2067		16A/220V OUTLETS UTILITY STN. 2 - OUTLET ES-EF-01
82-EL55	TRIP FEEDER CIRCUIT 4		82-XY 2057		
82-EL54	TRIP FEEDER CIRCUIT 16	77-FE110	77-XY 2088	77-XY 2089	HEATER IN GALLEY EXTRACT HOOD 77-GX110

1: OPERATION AND MONITORING OF THE ELECTRICAL DISTRIBUTION SYSTEM IS BASED ON THE SBE2 BLOCK, REV. 02
UNUSED FUNCTION BLOCK TERMINALS REQUIRED FOR PROPER FUNCTIONALITY i.e. XD, XGS AND XFV (ACC. TO FB SPEC. FOR SBE2, ITEM 5) ARE SHOWN AS HIGH INPUTS (LOGIC 1)
RESET OF ALARM (MCC FAULT) FROM OS

1: TYPICAL CONFIGURATION. DETAILS AS INDICATED IN BIT MAP MATRIX BELOW

A3	12.01.10	AS BUILT ACC. TO AD. 20958634	KRPAS	EDARN	STEE		VH
A2	28.08.07	AS BUILT, HHP-PROJECT	AB	MR	AB		GS
A1	30.09.01	AS BUILT	EIL				GS
0	31.03.01	ISSUED FOR CONSTRUCTION	EIL				
03D	29.05.00	ISSUED FOR FAT	EIL				
Rev.	Date	Description	Made by	Disc. check	Disc. appr.	Contr. appr.	Comp. appr.
Acceptance Codes: 1 ☐ 1B ☐ 2A ☐ 2 ☐ 3 ☐ 4 ☐			Date		Sign:		
 STATOIL Kværner Oil & Gas			Project: HULDRA EPC WHPT				
Drawing title :							
SYSTEM CONTROL DIAGRAM 400/230V CONTACTOR FEEDERS							
						N/A	
						Tag no.	
P.O. No. : 480018-P01-01						NTS	
						SOL. Code	Scale
							A1
Siemens Doc. No. :						Projection	Dwg. Format
							82
						Area Code	Sygt. Code
Drawing No. : C025-W-H082-J- W E-002-01						1 of 1	A3
Project install Design Disc./Disc. Log Seq. No.						Sheet	Rev.