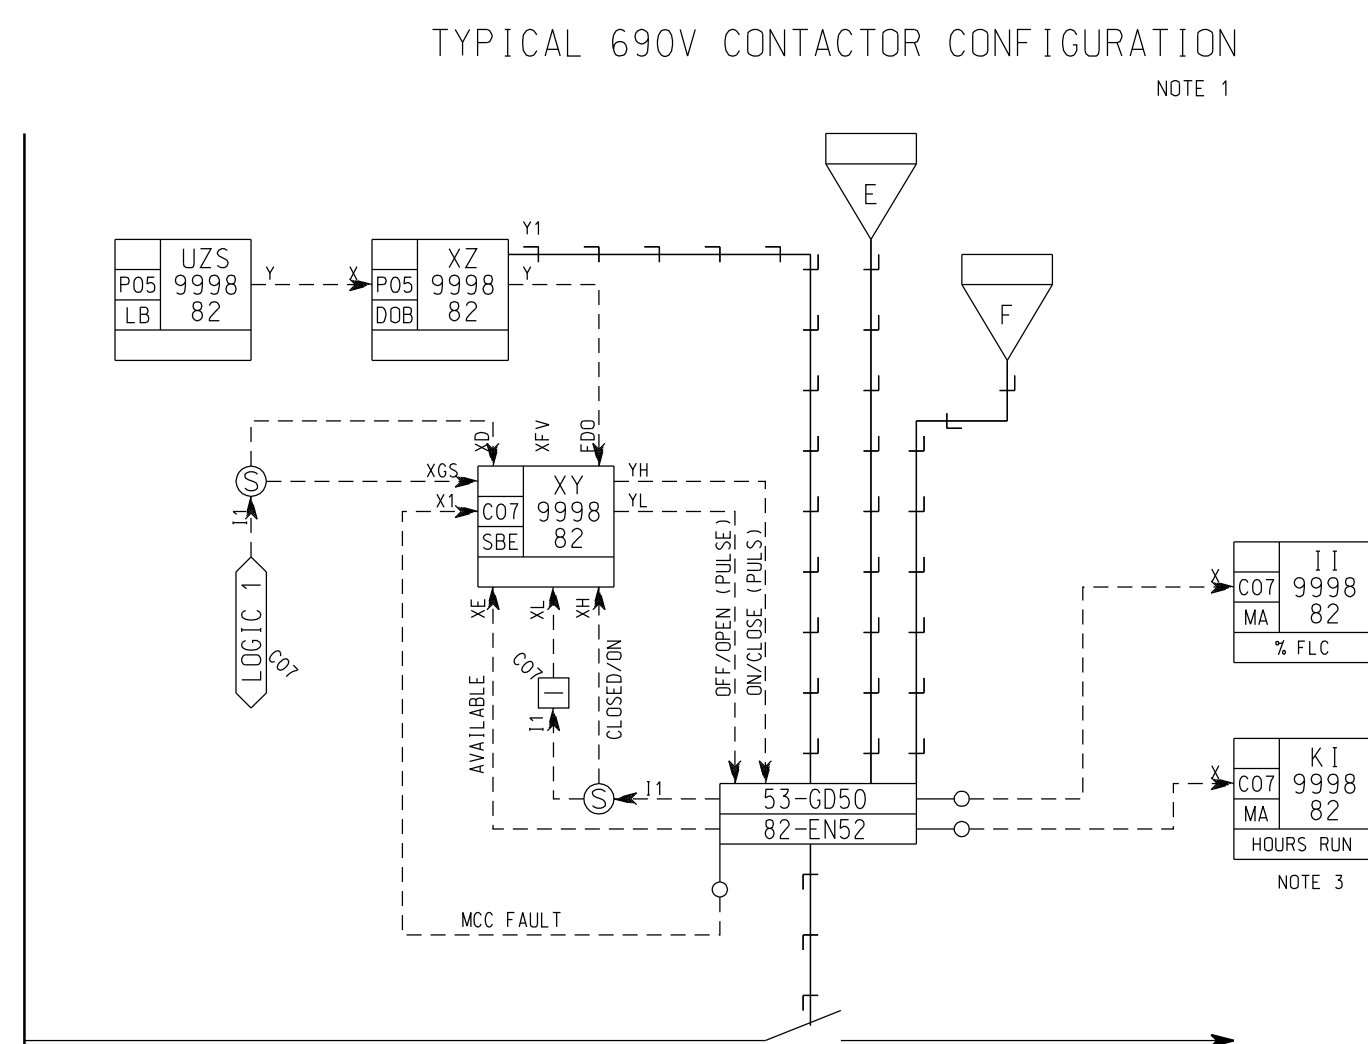


[illegible]

GENERAL NOTE:

1: OPERATION AND MONITORING THE ELECTRICAL DISTRIBUTION SYSTEM IS BASED ON THE SBE2 BLOCK, REV. 02

UNUSED FUNCTION BLOCK TERMINALS REQUIRED FOR PROPER FUNCTIONALITY i.e. XD, XGS AND XFV (ACC. TO FB SPEC. FOR SBE2, ITEM 5) ARE SHOWN AS HIGH INPUTS (LOGIC 1)

RESET OF ALARM (MCC INPUT FAULT) FROM OS

NOTES:

- 1: TYPICAL CONFIGURATION. DETAILS AS INDICATED IN BIT MAP MATRIX BELOW
- 2: PULSE LENGTH FOR OPEN AND CLOSED COMANDS ARE 3S.
- 3: ACCUMULATED VALUE FROM DEFINED CONSUMER
RESET TO BE PERFORMED FROM THE ELECTRICAL CONTROL UNIT

A1	30.09.01	AS BUILT				EIL				GS			
0	31.03.01	ISSUED FOR CONSTRUCTION				EIL							
A3	11.03.10	AS BUILT ACC. TO M5: 40974118				TV	ESK	Alit					
A2	28.08.07	AS BUILT, HHP-PROJECT				AB	MR	AB		GS			
Q1D	21.01.00	ISSUED FOR DESIGN				EIL							
Rev.	Date	Description	Made by	Disc. check	Disc. appr.	Contr. appr.	Comp. appr.						
Acceptance Codes: 1 18 2A 2 3 4						Sign:							
 STATOIL Kværner Oil & Gas						Project :							
						HULDRA EPC WHPT							
Drawing title :													
SYSTEM CONTROL DIAGRAM 690V CONTACTOR FEEDERS							N/A						
							Tag no.						
									NTS				
							SOL Code		Scale				
									A1				
P.O.No : 480018-P01-01							Projection		Dwg.Format				
Siemens Doc.No :									82				
							Area Code		Syst.Code				
Drawing No : C025-W-H082-J-*E-003-01							1 of 1		A3				
		Project install	Origin	Disc./Doc.Type	Seq.No.			Sheet		Rev.			