


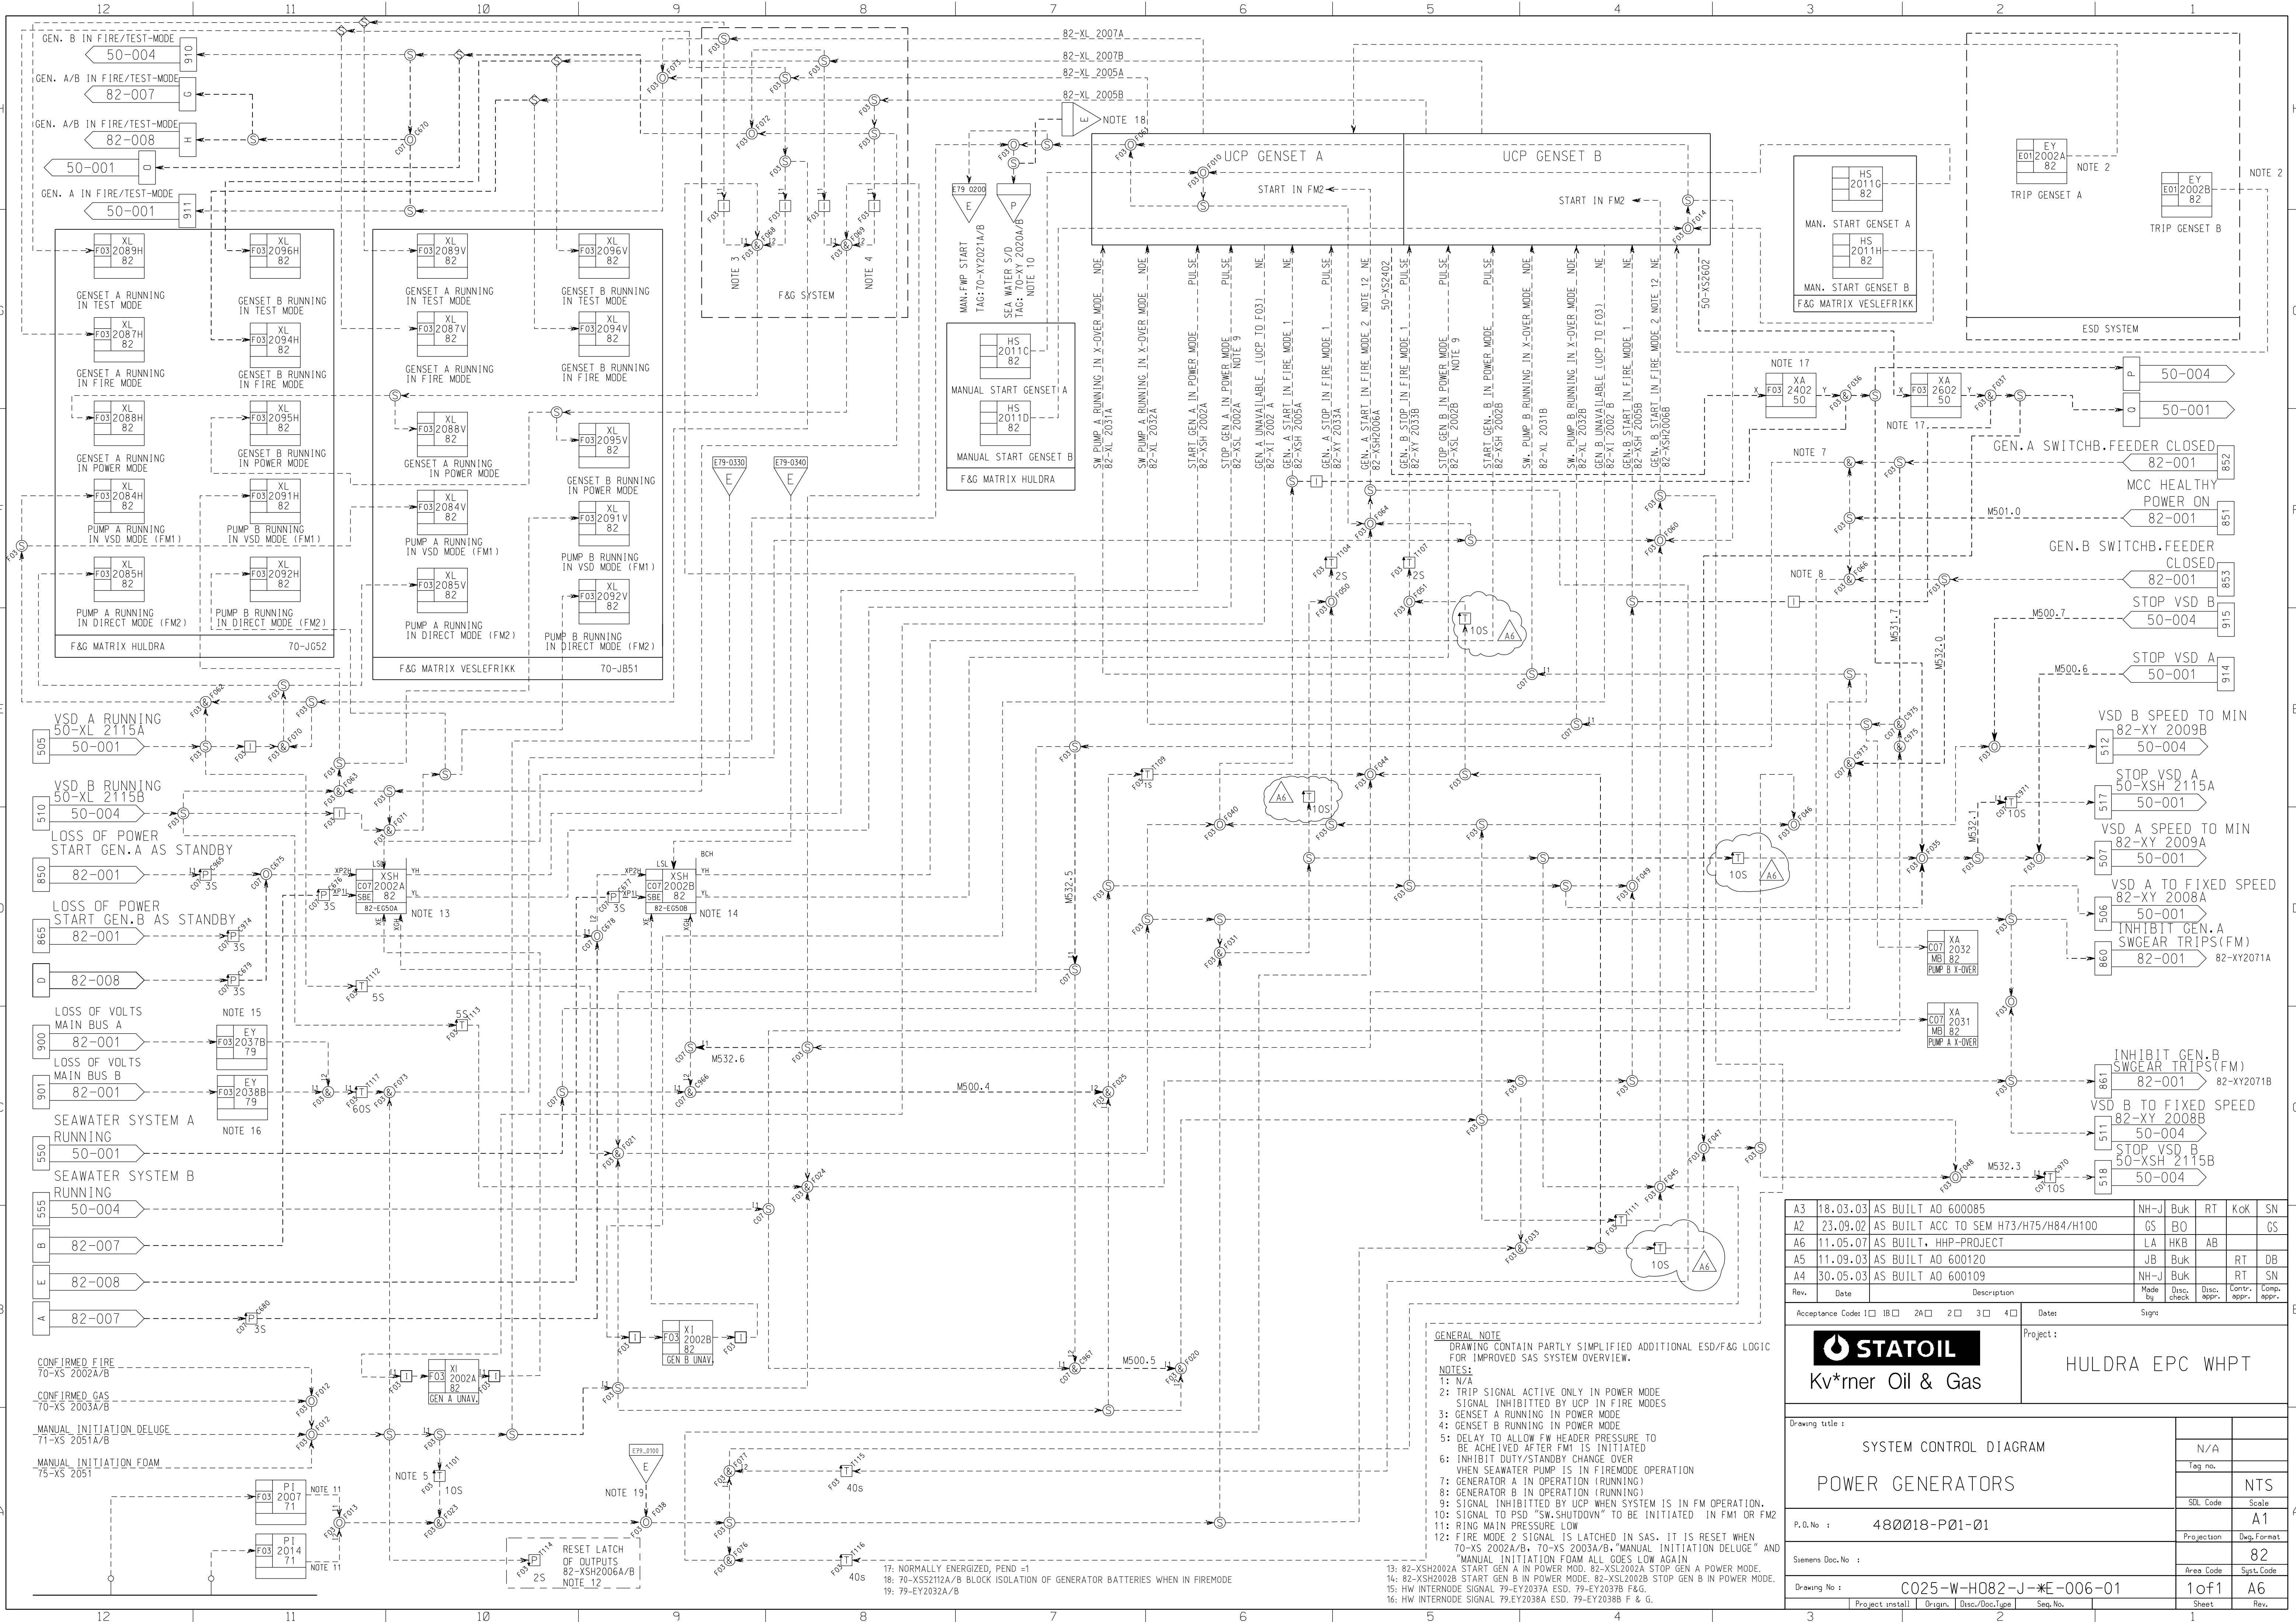

A3	18.03.03	AS BUILT AD 600085	NH-J	Buk	RT	KoK	SN
A2	23.09.02	AS BUILT ACC TO SEM H73/H75/H84/H100	GS	BO			GS
A6	11.05.07	AS BUILT, HHP-PROJECT	LA	HKB	AB		
A5	11.09.03	AS BUILT AD 600120		JB	Buk	RT	DB
A4	30.05.03	AS BUILT AD 600109	NH-J	Buk		RT	SN
Rev.	Date	Description	Made by	Disc. check	Disc. appr.	Contr. appr.	Comp. appr.
Acceptance Code: 1 1B 1C 2A 2 3 4 5			Signs				
 Kv*rnar Oil & Gas			Project :				
			HULDRA EPC WHPT				
Drawing title :							
SYSTEM CONTROL DIAGRAM POWER GENERATORS						N/A	
						Tag no.	
						NTS	
						SOL Code	
P.O. No : 480018-P01-01						A1	
Semens Doc.No :						Projection	
						Dwg.Format	
						82	
						Area Code	
Drawing No : C025-W-H082-J- W E-006-01						1 of 1	
						A6	
3		Project install		Origin		Disc./Doc.Type	
2						Seq. No.	
1						Sheet	
						Rev.	

GENERAL NOTE
DRAWING CONTAIN PARTLY SIMPLIFIED ADDITIONAL ESD/F&G LOGIC FOR IMPROVED SAS SYSTEM OVERVIEW.

NOTES:
1: N/A
2: TRIP SIGNAL ACTIVE ONLY IN POWER MODE
3: SIGNAL INHIBITED BY UCP IN FIRE MODES
4: GENSET A RUNNING IN POWER MODE
5: DELAY TO ALLOW FW HEADER PRESSURE TO BE ACHIEVED AFTER FM1 IS INITIATED
6: INHIBIT DUTY/STANDBY CHANGE OVER WHEN SEAWATER PUMP IS IN FIREMODE OPERATION
7: GENERATOR A IN OPERATION (RUNNING)
8: GENERATOR B IN OPERATION (RUNNING)
9: SIGNAL INHIBITED BY UCP WHEN SYSTEM IS IN FM OPERATION.
10: SIGNAL TO PSD "SW-SHUTDOWN" TO BE INITIATED IN FM1 OR FM2
11: RING MAIN PRESSURE LOW
12: FIRE MODE 2 SIGNAL IS LATCHED IN SAS. IT IS RESET WHEN 70-XS 2002A/B, 70-XS 2003A/B, "MANUAL INITIATION DELUGE" AND "MANUAL INITIATION FOAM ALL GOES LOW AGAIN"

13: 82-XSH2002A START GEN A IN POWER MOD. 82-XSL2002A STOP GEN A POWER MODE.
14: 82-XSH2002B START GEN B IN POWER MODE. 82-XSL2002B STOP GEN B IN POWER MODE.
15: HW INTERNODE SIGNAL 79-EY2037A ESD. 79-EY2037B F&G.
16: HW INTERNODE SIGNAL 79-EY2038A ESD. 79-EY2038B F & G.

17: NORMALLY ENERGIZED, PEND =1
18: 70-XS2112A/B BLOCK ISOLATION OF GENERATOR BATTERIES WHEN IN FIREMODE
19: 79-EY2032A/B