


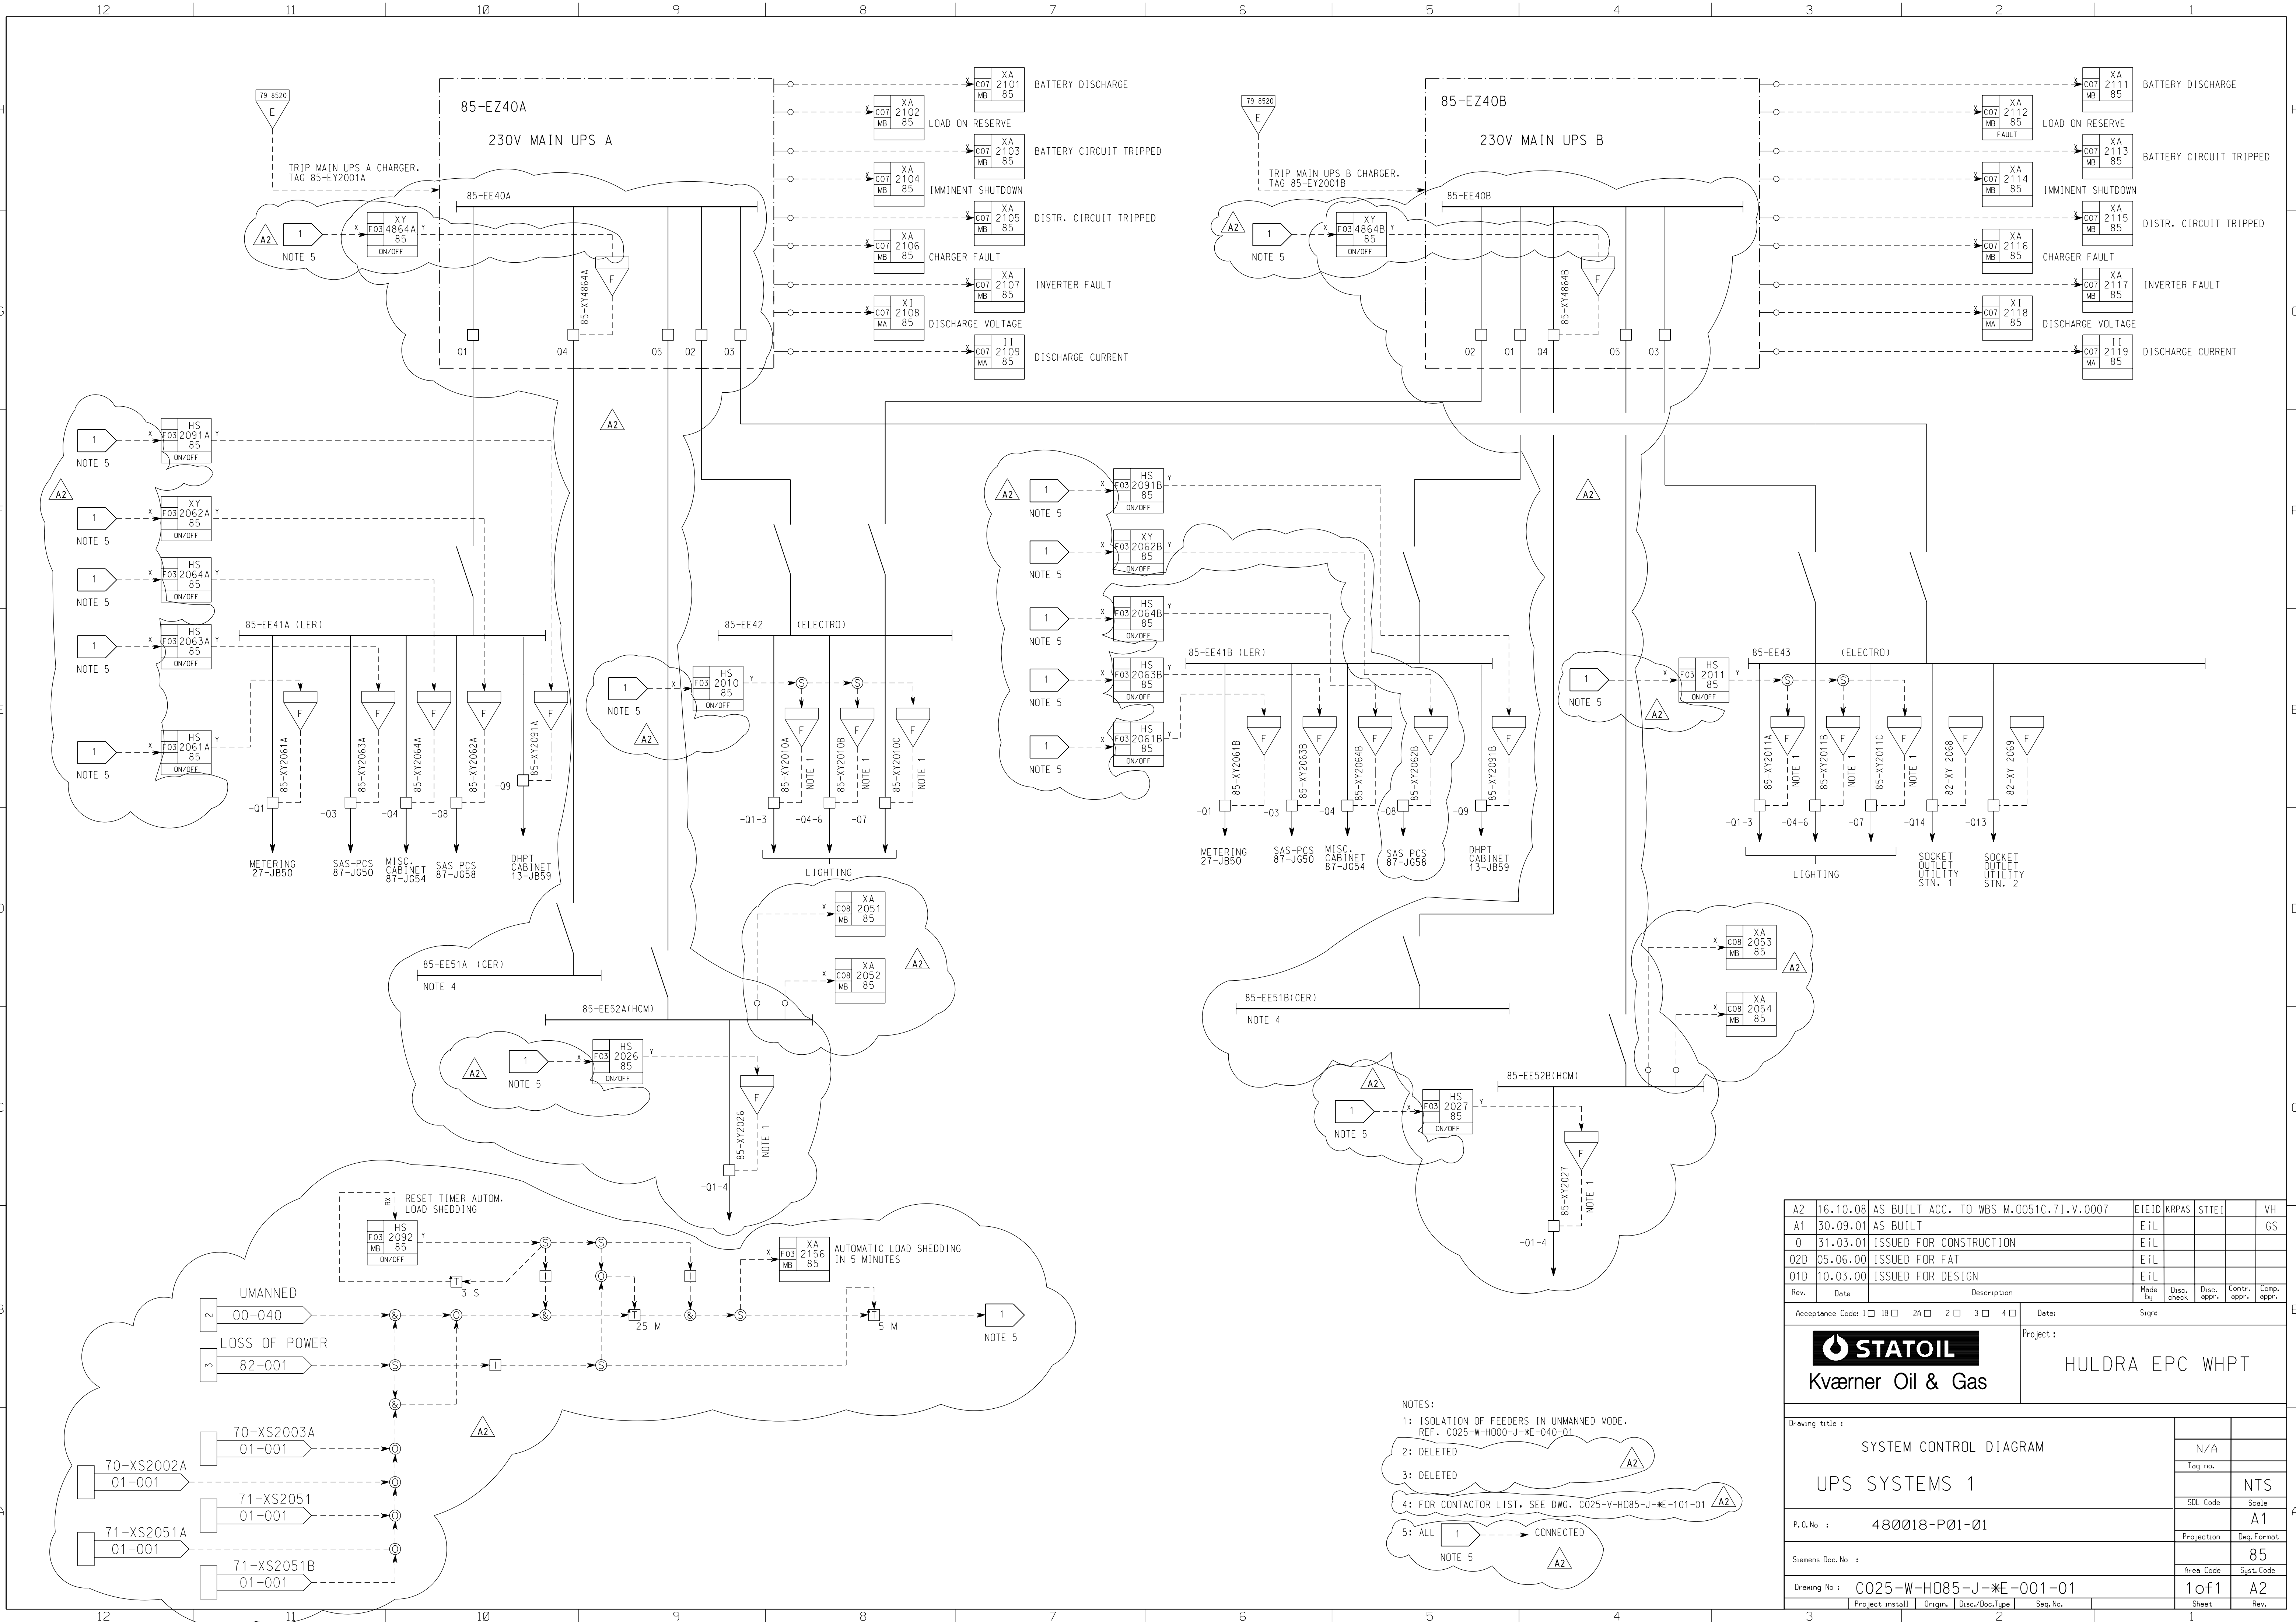

A2	16.10.08	AS BUILT ACC. TO WBS M.0051C.71.V.0007	EiL	ARPAS	STTEI	VH
A1	30.09.01	AS BUILT	EiL			GS
0	31.03.01	ISSUED FOR CONSTRUCTION	EiL			
02D	05.06.00	ISSUED FOR FAT	EiL			
01D	10.03.00	ISSUED FOR DESIGN	EiL			
Rev.	Date	Description	Made by	Disc. check	Disc. appr.	Contr. appr.
Acceptance Codes: 1 ☐ 1B ☐ 2A ☐ 2 ☐ 3 ☐ 4 ☐			Signs:			
STATOIL Kværner Oil & Gas			Project :			
			HULDRA EPC WHPT			
Drawing title :						
SYSTEM CONTROL DIAGRAM				N/A		
				Tag no.		
UPS SYSTEMS 1				NTS		
				SOL Code		Scale
P.O. No : 480018-P01-01				A1		
Siemens Doc.No :				Projection		Dwg.Format
						85
Drawing No : C025-W-H085-J-#E-001-01				Area Code		Syst.Code
				1 of 1		A2
Project install		Origin.	Disc./Doc.Type	Seq. No.	Sheet	Rev.