


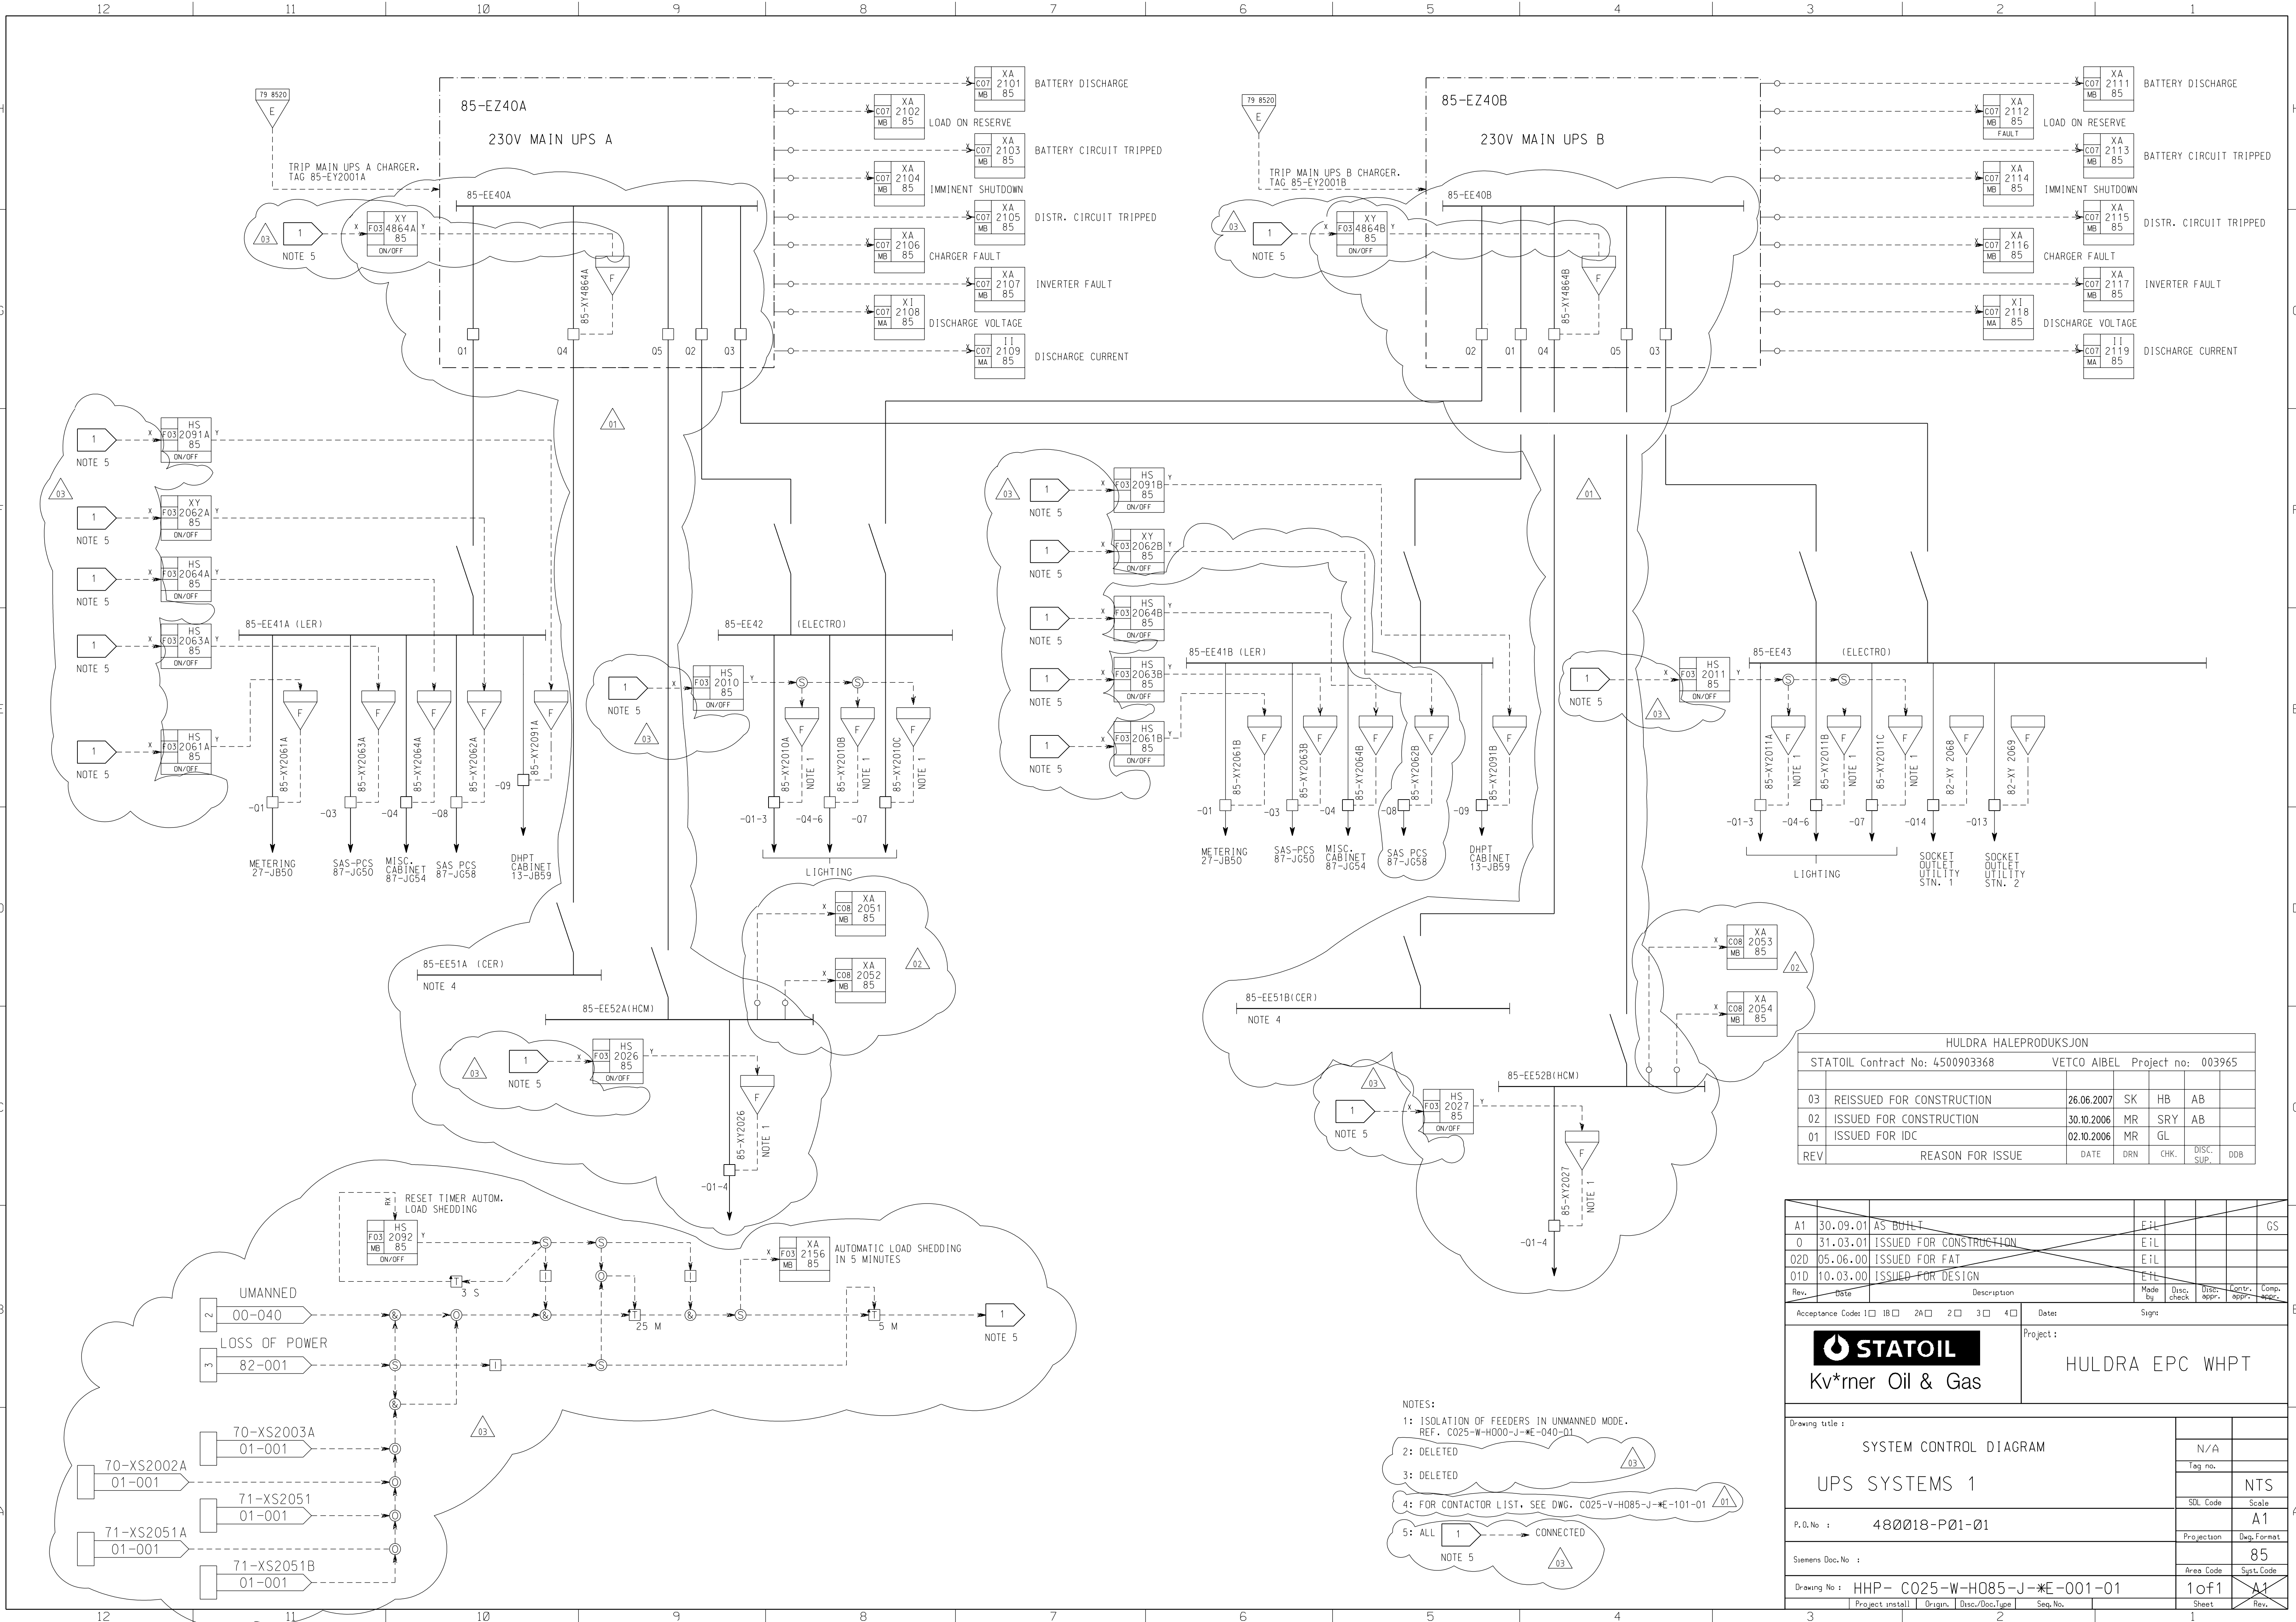

HULDRA HALEPRODUKSJON					
STATOIL Contract No: 4500903368		VETCO AIBEL		Project no: 003965	
03	REISSUED FOR CONSTRUCTION	26.06.2007	SK	HB	AB
02	ISSUED FOR CONSTRUCTION	30.10.2006	MR	SRY	AB
01	ISSUED FOR IDC	02.10.2006	MR	GL	AB
REV	REASON FOR ISSUE	DATE	DRN	CHK.	DISC. SUP. DDB

A1	30.09.01	AS BUILT	EIL			GS
0	31.03.01	ISSUED FOR CONSTRUCTION	EIL			
02D	05.06.00	ISSUED FOR FAT	EIL			
01D	10.03.00	ISSUED FOR DESIGN	EIL			
Rev.	Date	Description	Made by	Disc. check	Disc. appr.	Contr. appr.
Acceptance Codes: ☐ IB ☐ 2A ☐ 2 ☐ 3 ☐ 4 ☐ 0			Signs			
Project: STATOIL Kv*mer Oil & Gas			Project: HULDRA EPC WHPT			
Drawing title: SYSTEM CONTROL DIAGRAM UPS SYSTEMS 1			N/A			
P.O. No: 480018-P01-01			Tag no.		NTS	
Siemens Doc. No:			SOL Code		A1	
Drawing No: HHP- C025-W-H085-J-#E-001-01			Projection		Dwg. Format	
Project install			Area Code		Syst. Code	
Origin.			Seq. No.		1 of 1	
Disc./Doc. Type			Sheet		Rev.	

- NOTES:
- 1: ISOLATION OF FEEDERS IN UNMANNED MODE.
REF. C025-W-H000-J-#E-040-01
 - 2: DELETED
 - 3: DELETED
 - 4: FOR CONTACTOR LIST, SEE DWG. C025-V-H085-J-#E-101-01
 - 5: ALL **1** CONNECTED